


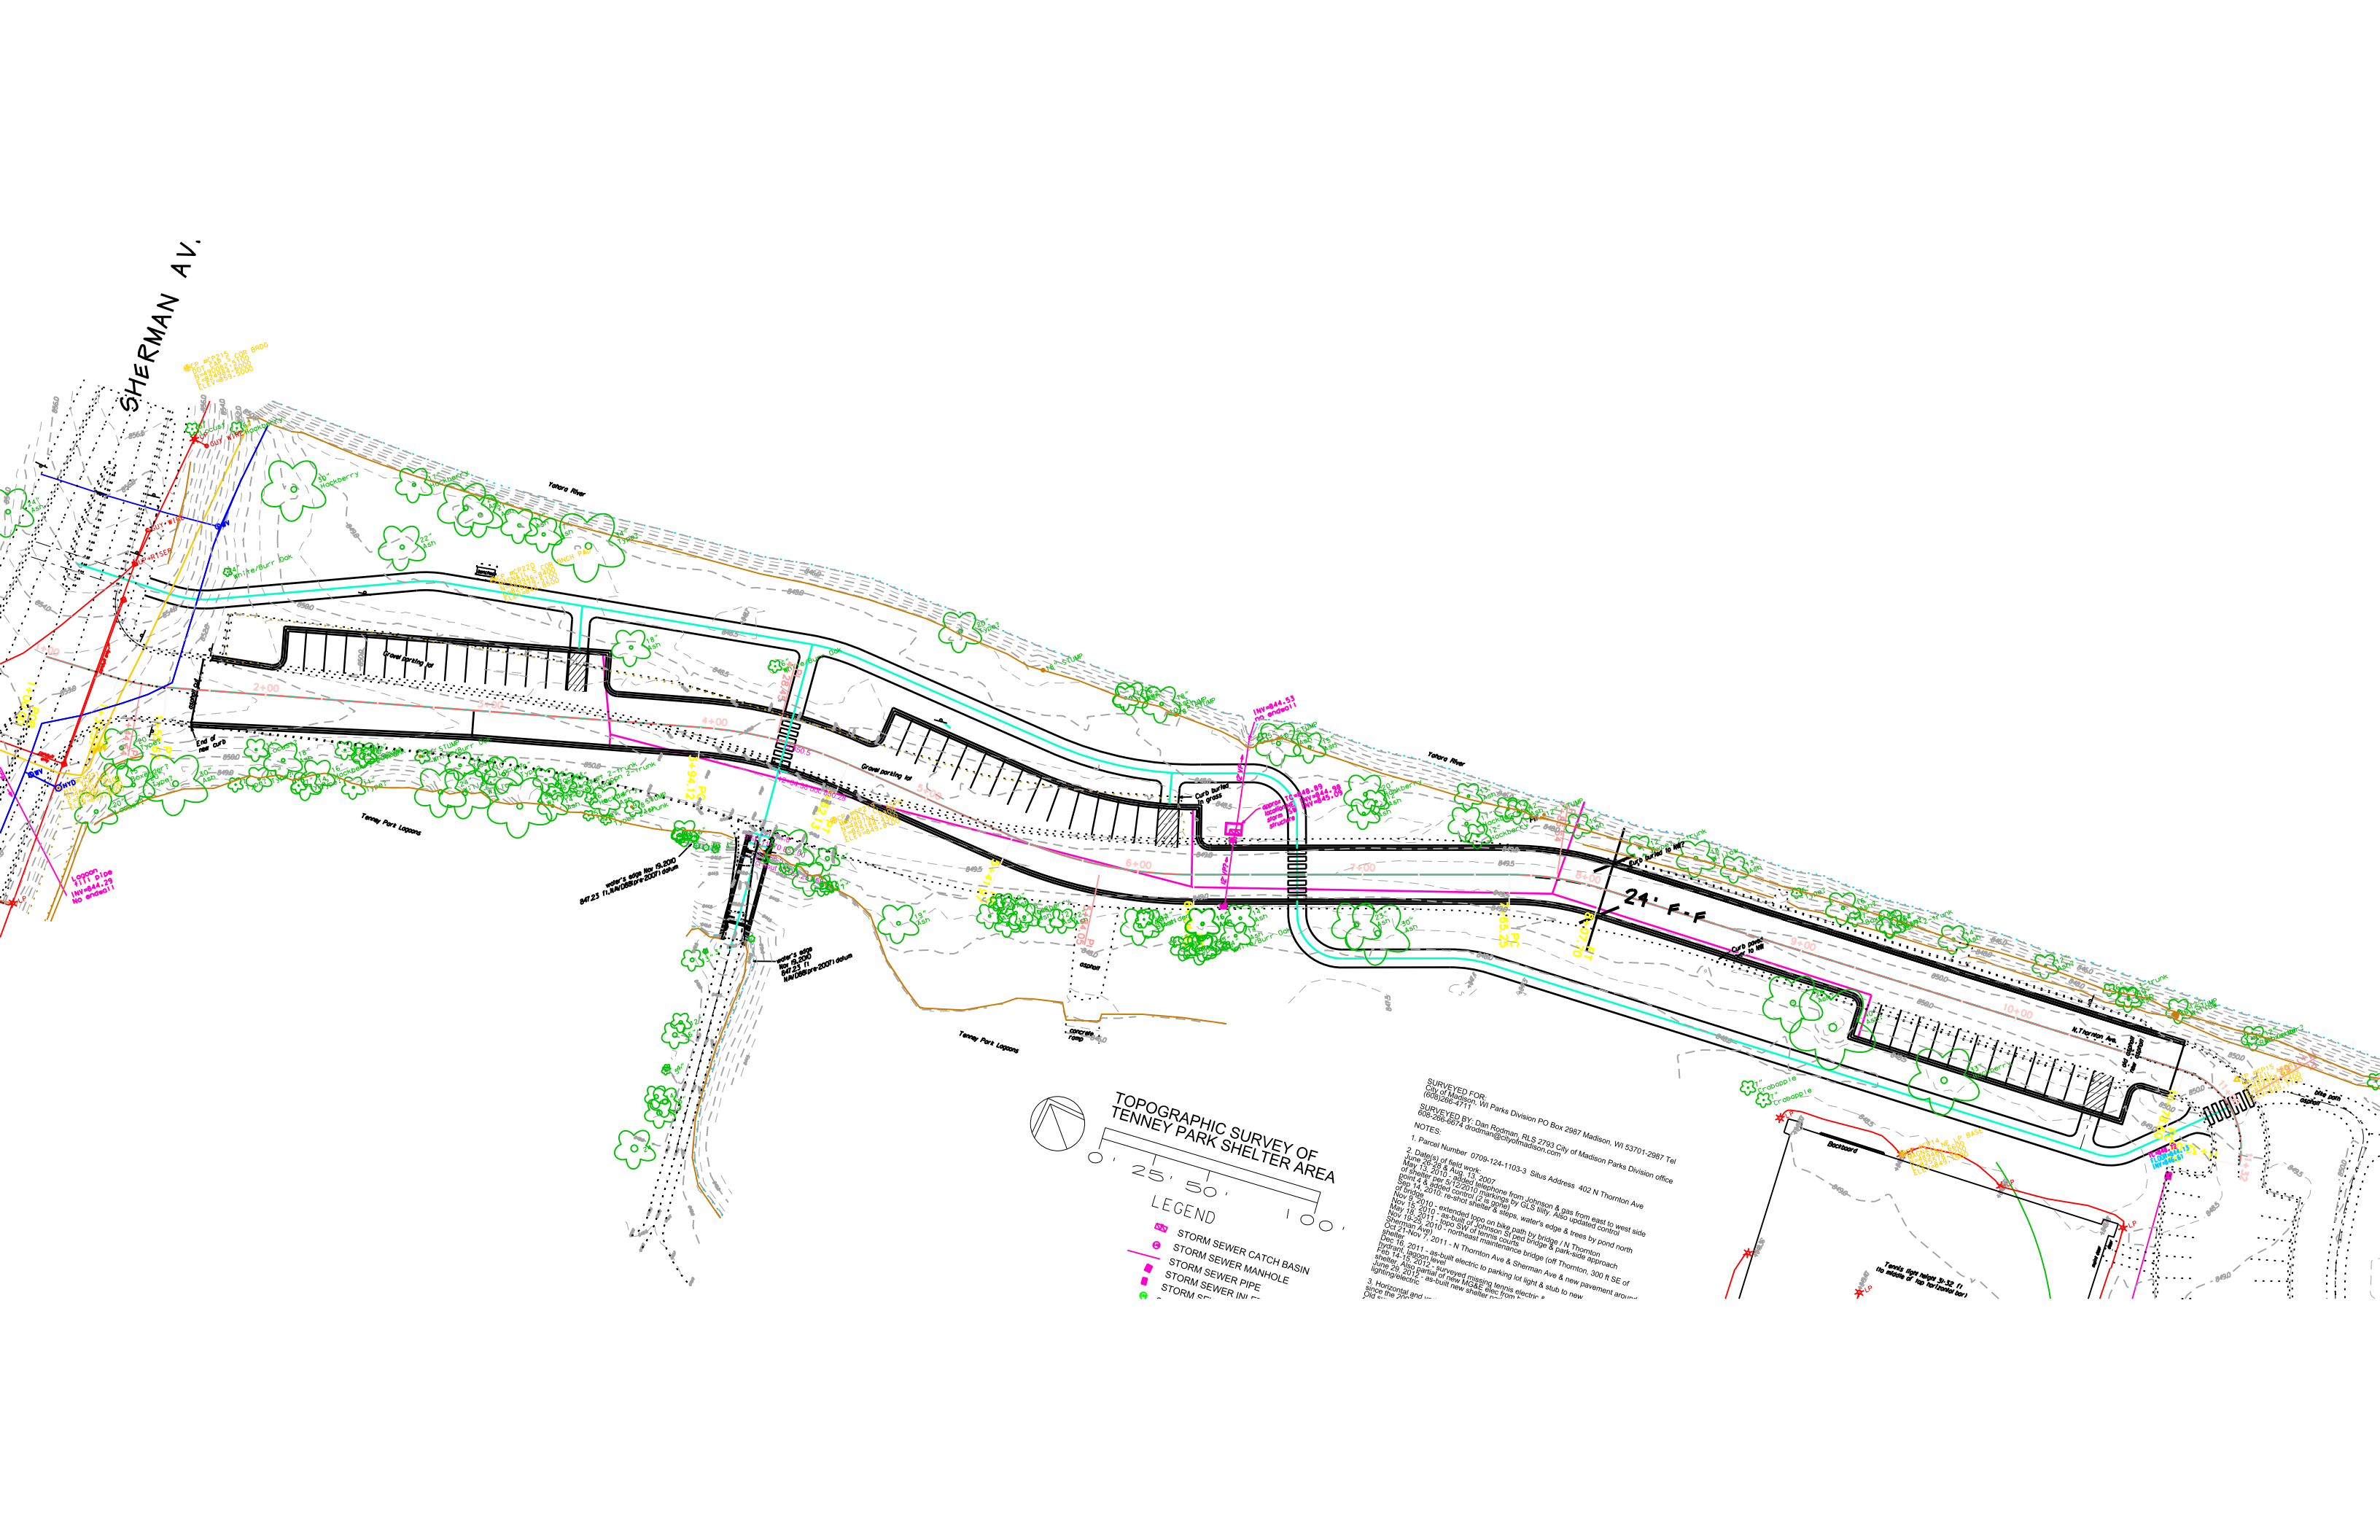

SHERMAN AV.

Tenney River

Tenney Park Lagoon

Tenney Park Lagoon

TOPOGRAPHIC SURVEY OF
TENNEY PARK SHELTER AREA

LEGEND

- STORM SEWER CATCH BASIN
- STORM SEWER MANHOLE
- STORM SEWER PIPE
- STORM SEWER INLET

SURVEYED FOR:
City of Madison, WI Parks Division PO Box 2887 Madison, WI 53701-2987 Tel
(608)266-4711
SURVEYED BY: Dan Rodman, RLS 2793 City of Madison Parks Division office
608-266-9674 drodman@cityofmadison.com

NOTES:

1. Parcel Number: 0709-124-1103-3 Situs Address: 402 N Thornton Ave
2. Date(s) of field work:
June 13, 2010 & Aug. 15, 2007
June 13, 2010 - as-built electric to parking lot light & stub to new
of shelter per 01/22/2010 markings by GLS. Also updated control
Point 4 & set of control (2) is given
Nov 14, 2010 - re-survey shelter & stops, water's edge & trees by pond north
of bridge
Nov 15, 2010 - extended topo on bike path by bridge / N Thornton
Nov 18, 2011 - as-built Johnson St. ped bridge & park-side approach
Nov 18, 2011 - 050 SW of tennis courts
Dec 16, 2011 - northeast maintenance bridge (off Thornton, 300 ft SE of
Shelter)
Dec 16, 2011 - N Thornton Ave & Sherman Ave & new pavement around
shelter
Feb 14, 2012 - Surveyed missing tennis electric
June 20, 2012 - as-built new shelter electric
lighting/electric
3. Horizontal and vertical
Old st. the 2nd and 3rd

Tenney light height 3'-5" (1/2
to middle of top horizontal bar)