


MGE Marked Up  
 MJB 5/4/18

Existing Facilities in Blue  
 Proposed Facilities in Red  
 Removals in Orange



LEGEND	
— OH	OVERHEAD UTILITY WIRE
— B	BURIED GAS LINE
— W	WATER MAIN
— SAN	SANITARY SEWER
— ST	STORM SEWER
— E	BURIED ELECTRIC
— M	MAJOR CONTOUR
— m	MINOR CONTOUR
●	BOLLARD
○	CISTERN
○	WATER VALVE
○	GAS METER
○	UTILITY POLE
○	CHAIN LINK FENCE
○	LIGHT POLE
○	GUY WIRE
○	DECIDUOUS TREE
( )	INDICATES RECORDED AS

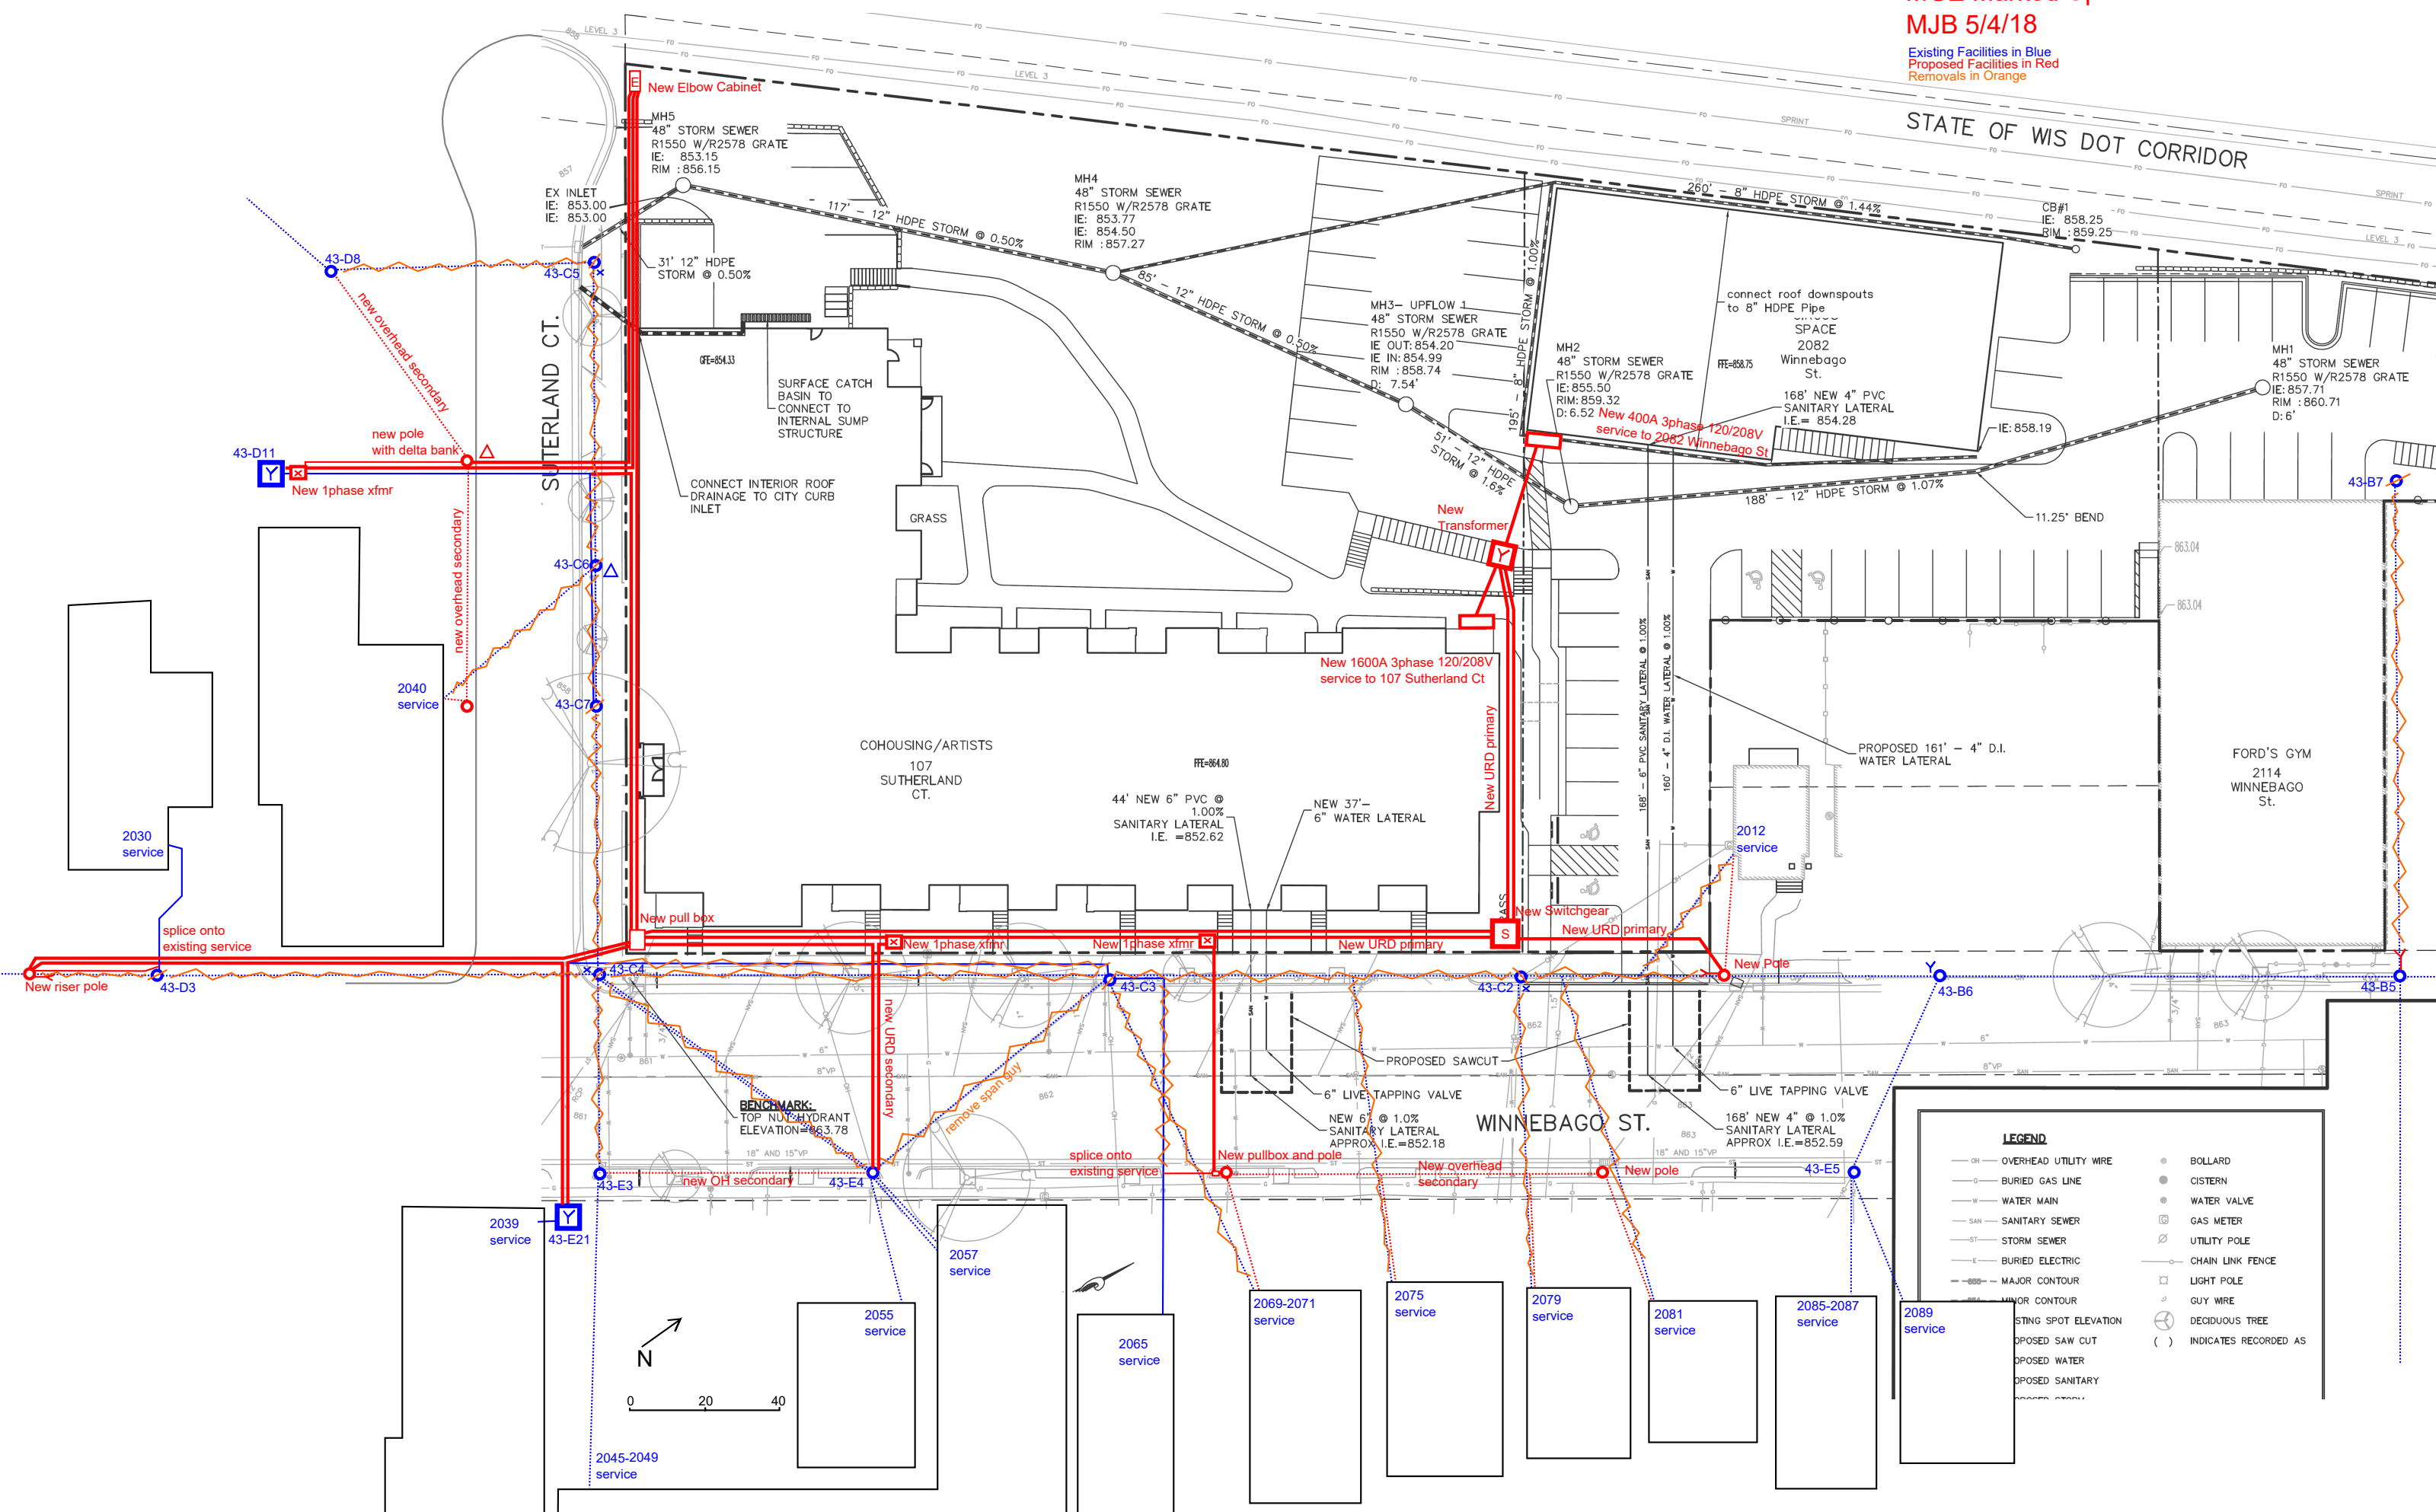