

Notes:

- ALL CORRIDOR PARTITIONS ARE D14/S, U.O.N.
- ALL UNIT DEMISING PARTITIONS ARE D15/S, U.O.N.
- SHAFT WALLS AT TRASH ARE D13/S WITH D22 FURRING PARTITION AT UNIT SIDE
- SEE ENLARGED UNIT PLANS FOR PARTITION TYPES WITHIN UNITS

KEYNOTES:

- 1 PROVIDE POWER AND HOSE BIBBS AT LANDSCAPED AREAS. LOCATIONS TO BE COORDINATED WITH OWNER AND DESIGN/BUILD MEPS.
- 2 PROVIDE GAS FOR GRILLE STATION. LOCATIONS TO BE COORDINATED WITH OWNER AND DESIGN/BUILD MEPS.
- 3 3'-0" X 6'-0" X 8'-0" TENANT STORAGE LOCKERS WITH LOCKABLE DOORS
- 4 ALUMINUM POSTS FOR UNDERHEAD LIGHTINGS SUPPORT. POSTS ANCHORED TO PRECAST CONCRETE BASE ABOVE ROOFING SYSTEM.

PRELIMINARY
NOT FOR CONSTRUCTION


St. Johns Lutheran Church
Redevelopment
328 East Washington Avenue
Madison, WI

Hancock Street Apartments
6 North Hancock Street
Madison, WI

2021.09.00

DATE	ISSUANCE/REVISIONS
09/29/2023	DESIGN DEVELOPMENT DOCUMENTS
6/14/2024	MINOR ALTERATION

1
A105 SECOND FLOOR PLAN
1/8" = 1'-0"

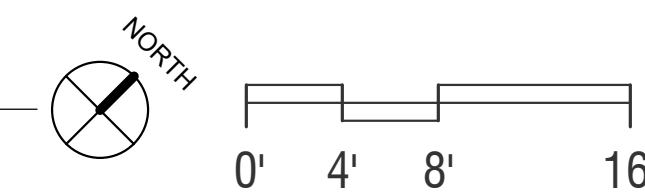


**SECOND FLOOR
PLAN**

A105



2 NORTHEAST ELEVATION - (NORTH HANCOCK STREET)
A201 3/32" = 1'-0"

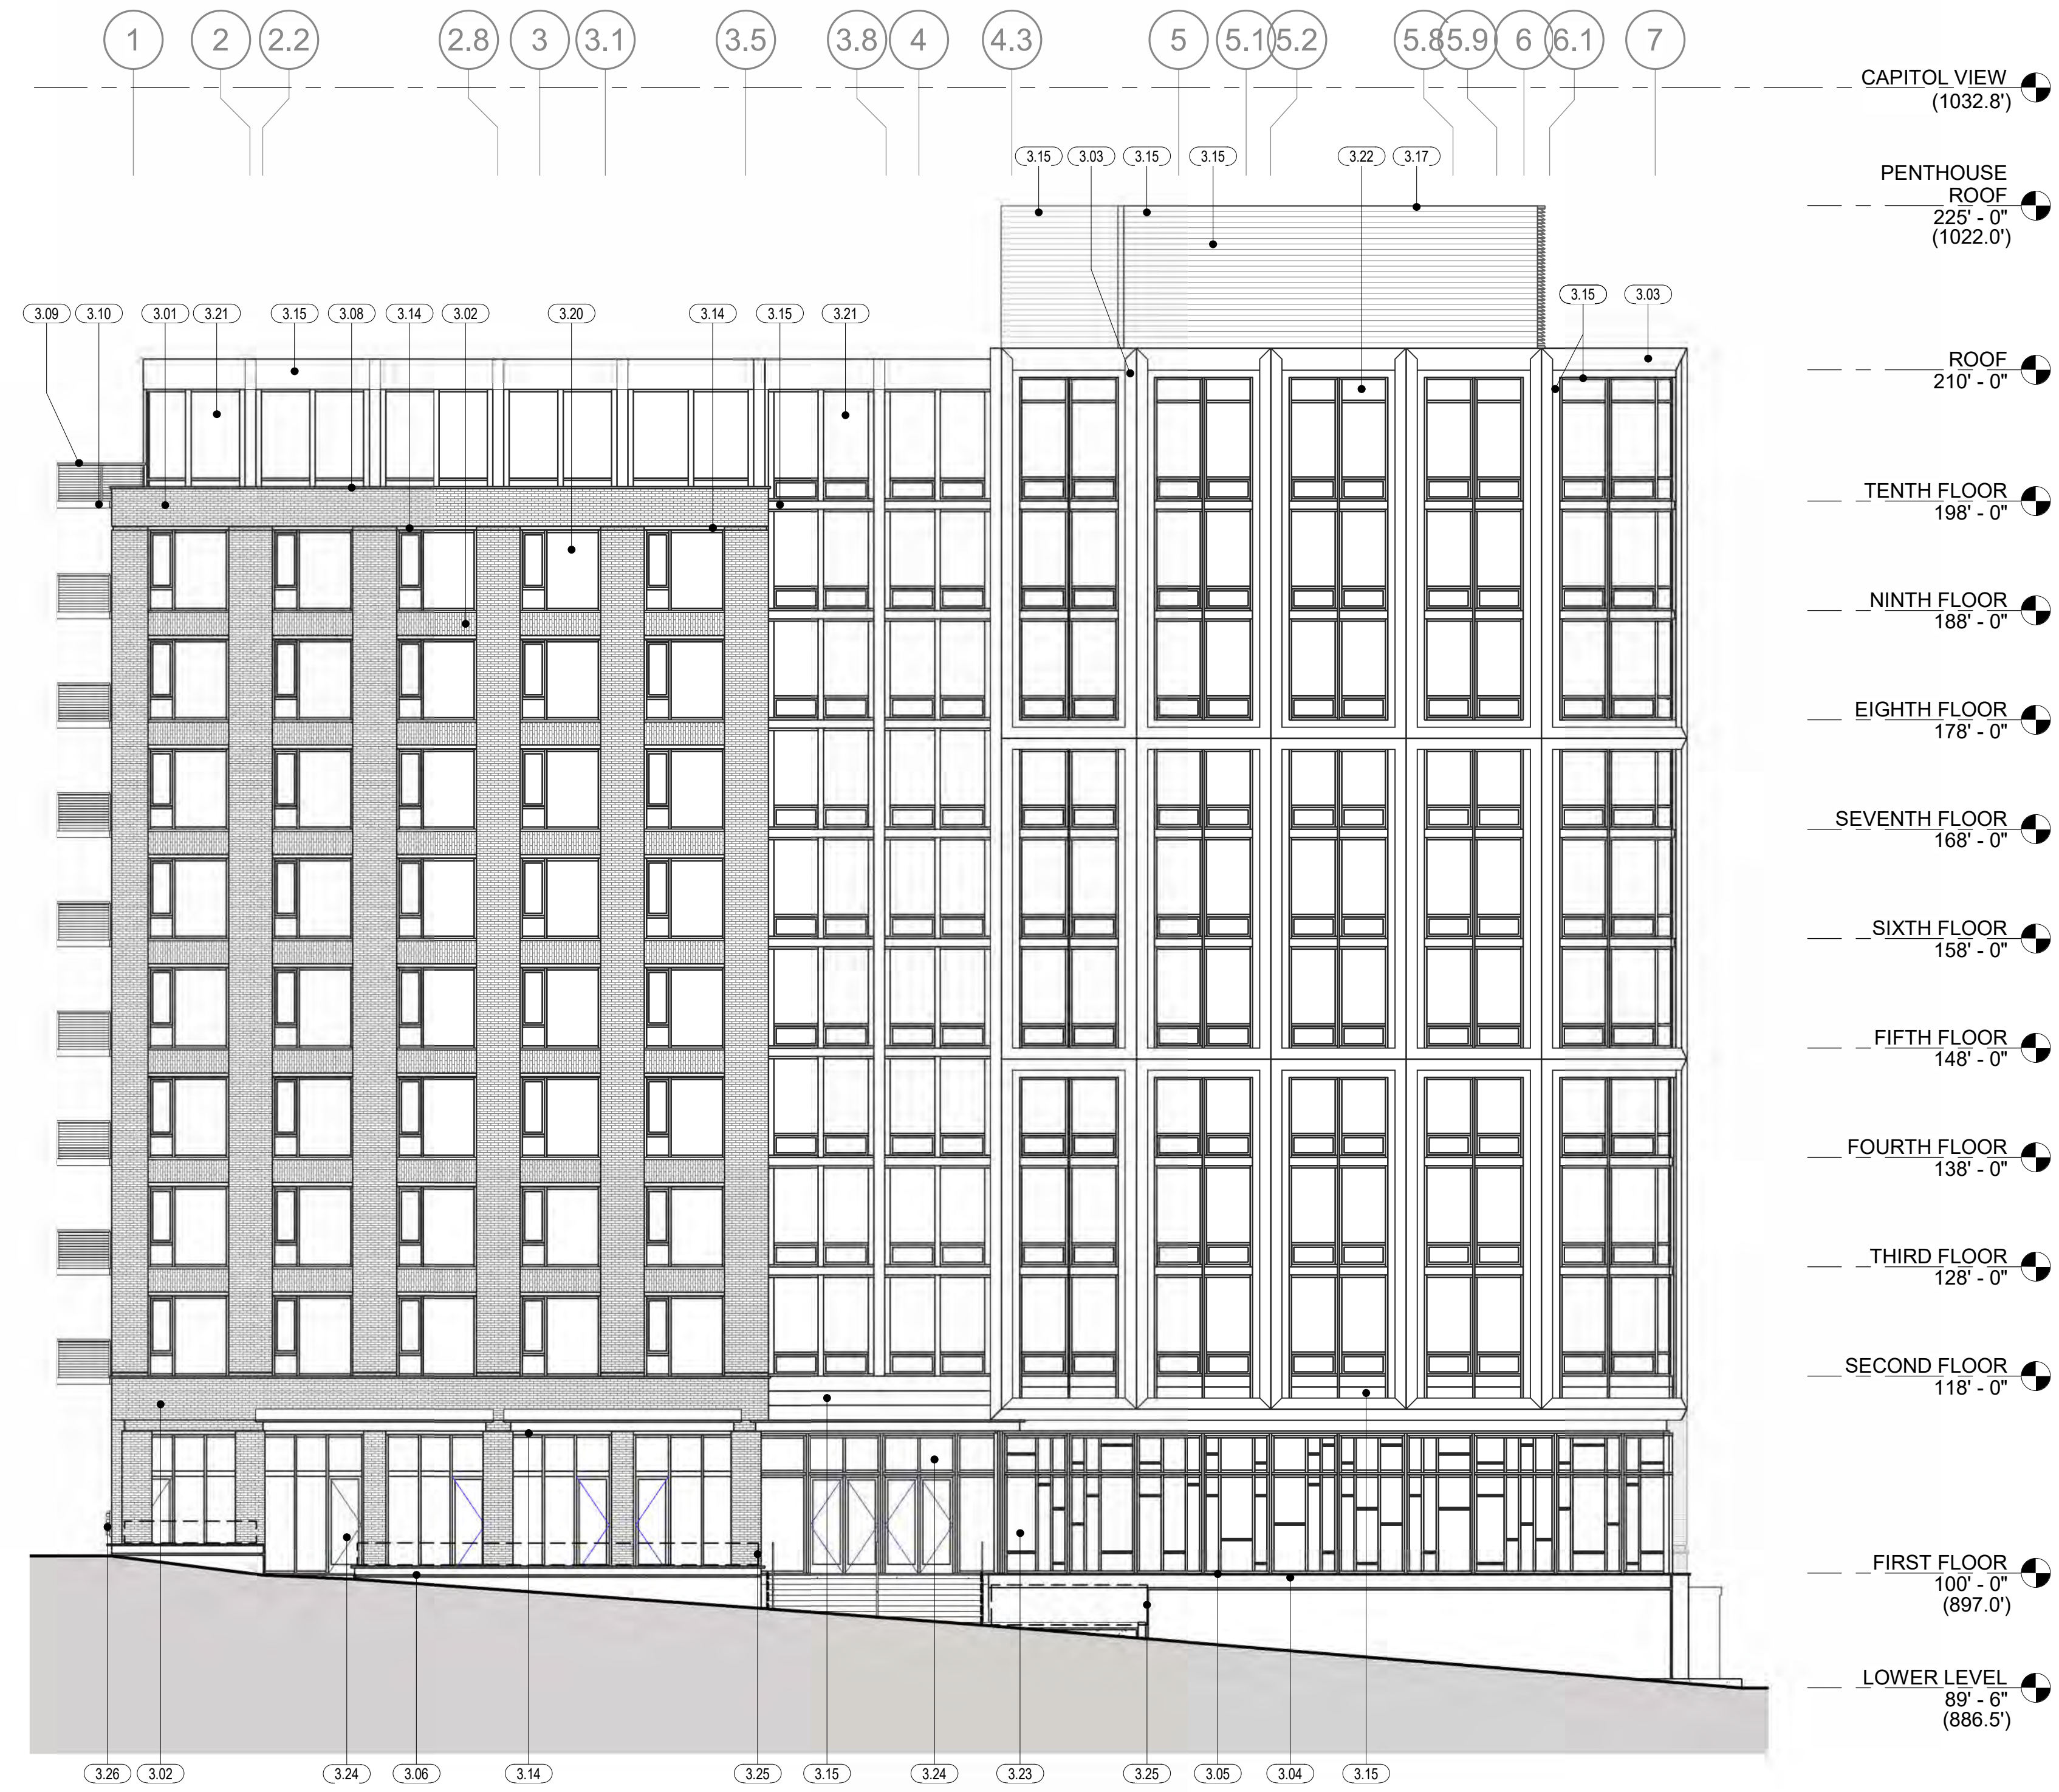

1 SOUTHEAST ELEVATION - (EAST WASHINGTON AVENUE)
A201 3/32" = 1'-0"

Notes:
INSULATING GLASS TYPES (IGU)
ALL IGU TYPES ARE TYPE "A"
UNLESS NOTED OTHERWISE
IGU - A:
IGU - B:

PRELIMINARY
NOT FOR CONSTRUCTION

St. Johns Lutheran Church
348 East Washington Avenue
Madison, WI

Hancock Street Apartments
6 North Hancock Street
Madison, WI


2021.09.00

DATE: 08/18/2023
ISSUANCE/REVISIONS: CITY OF MADISON - SITE PLAN REVIEW


Key Value	Keynote Text
3.01	BRICK VENEER - RUNNING BOND
3.02	BRICK VENEER - STACKED SOLDER BOND
3.03	PRECAST CONCRETE PANEL
3.04	STONE VENEER PANELS
3.05	STONE COPING/SILL
3.06	STONE VENEER PLANTER W/ STONE COPING
3.08	PRECAST STONE SILL
3.09	ANODIZED ALUMINUM GUARDRAIL
3.10	CONCRETE BANCONY
3.11	SITE CAST CONCRETE RETAINING WALL/FOUNDATION
3.12	PRECAST CONCRETE BASE
3.13	HIGH DENSITY FIBER CEMENT BOARD
3.14	ACCENT STEEL LINTEL
3.15	CONCEALED FASTENER ANODIZED METAL PANEL
3.16	COLING GARAGE DOOR
3.17	MECHANICAL LOUVER
3.19	FAUX WOOD VANEER EXTRUDED ALUMINUM FIN
3.20	FIBER GLASS WINDOW WALL GLAZING SYSTEM
3.21	FIBER GLASS WINDOW WALL GLAZING SYSTEM
3.22	FIBER GLASS STOREFRONT WALL GLAZING SYSTEM
3.23	CURTAIN WALL GLAZING SYSTEM
3.24	CURTAIN WALL GLAZING SYSTEM
3.25	ZONE OF PROPOSED SIGNAGE
3.26	FIRE DEPARTMENT CONNECTION
3.27	RECESSED MFD KNOX BOX
6.01	HVAC UNIT
6.02	WASHER/DRYER VENTLESS
9.01	30"W REFRIGERATOR
9.02	36"W REFRIGERATOR
9.03	24" COOKTOP
9.04	30" RANGE
9.05	30" RANGE FRONT MOUNTED WITH ACCESSIBLE CONTROLS
9.06	RANGE VENT
9.07	DISHWASHER
9.08	ACCESSIBLE DISHWASHER
9.09	OVER-RANGE MICROWAVE
9.10	COUNTERTOP MICROWAVE
9.11	PULL-OUT TRASH AND RECYCLING BINS

PREVIOUS 8.18.2023
BUILDING
ELEVATIONS

A201

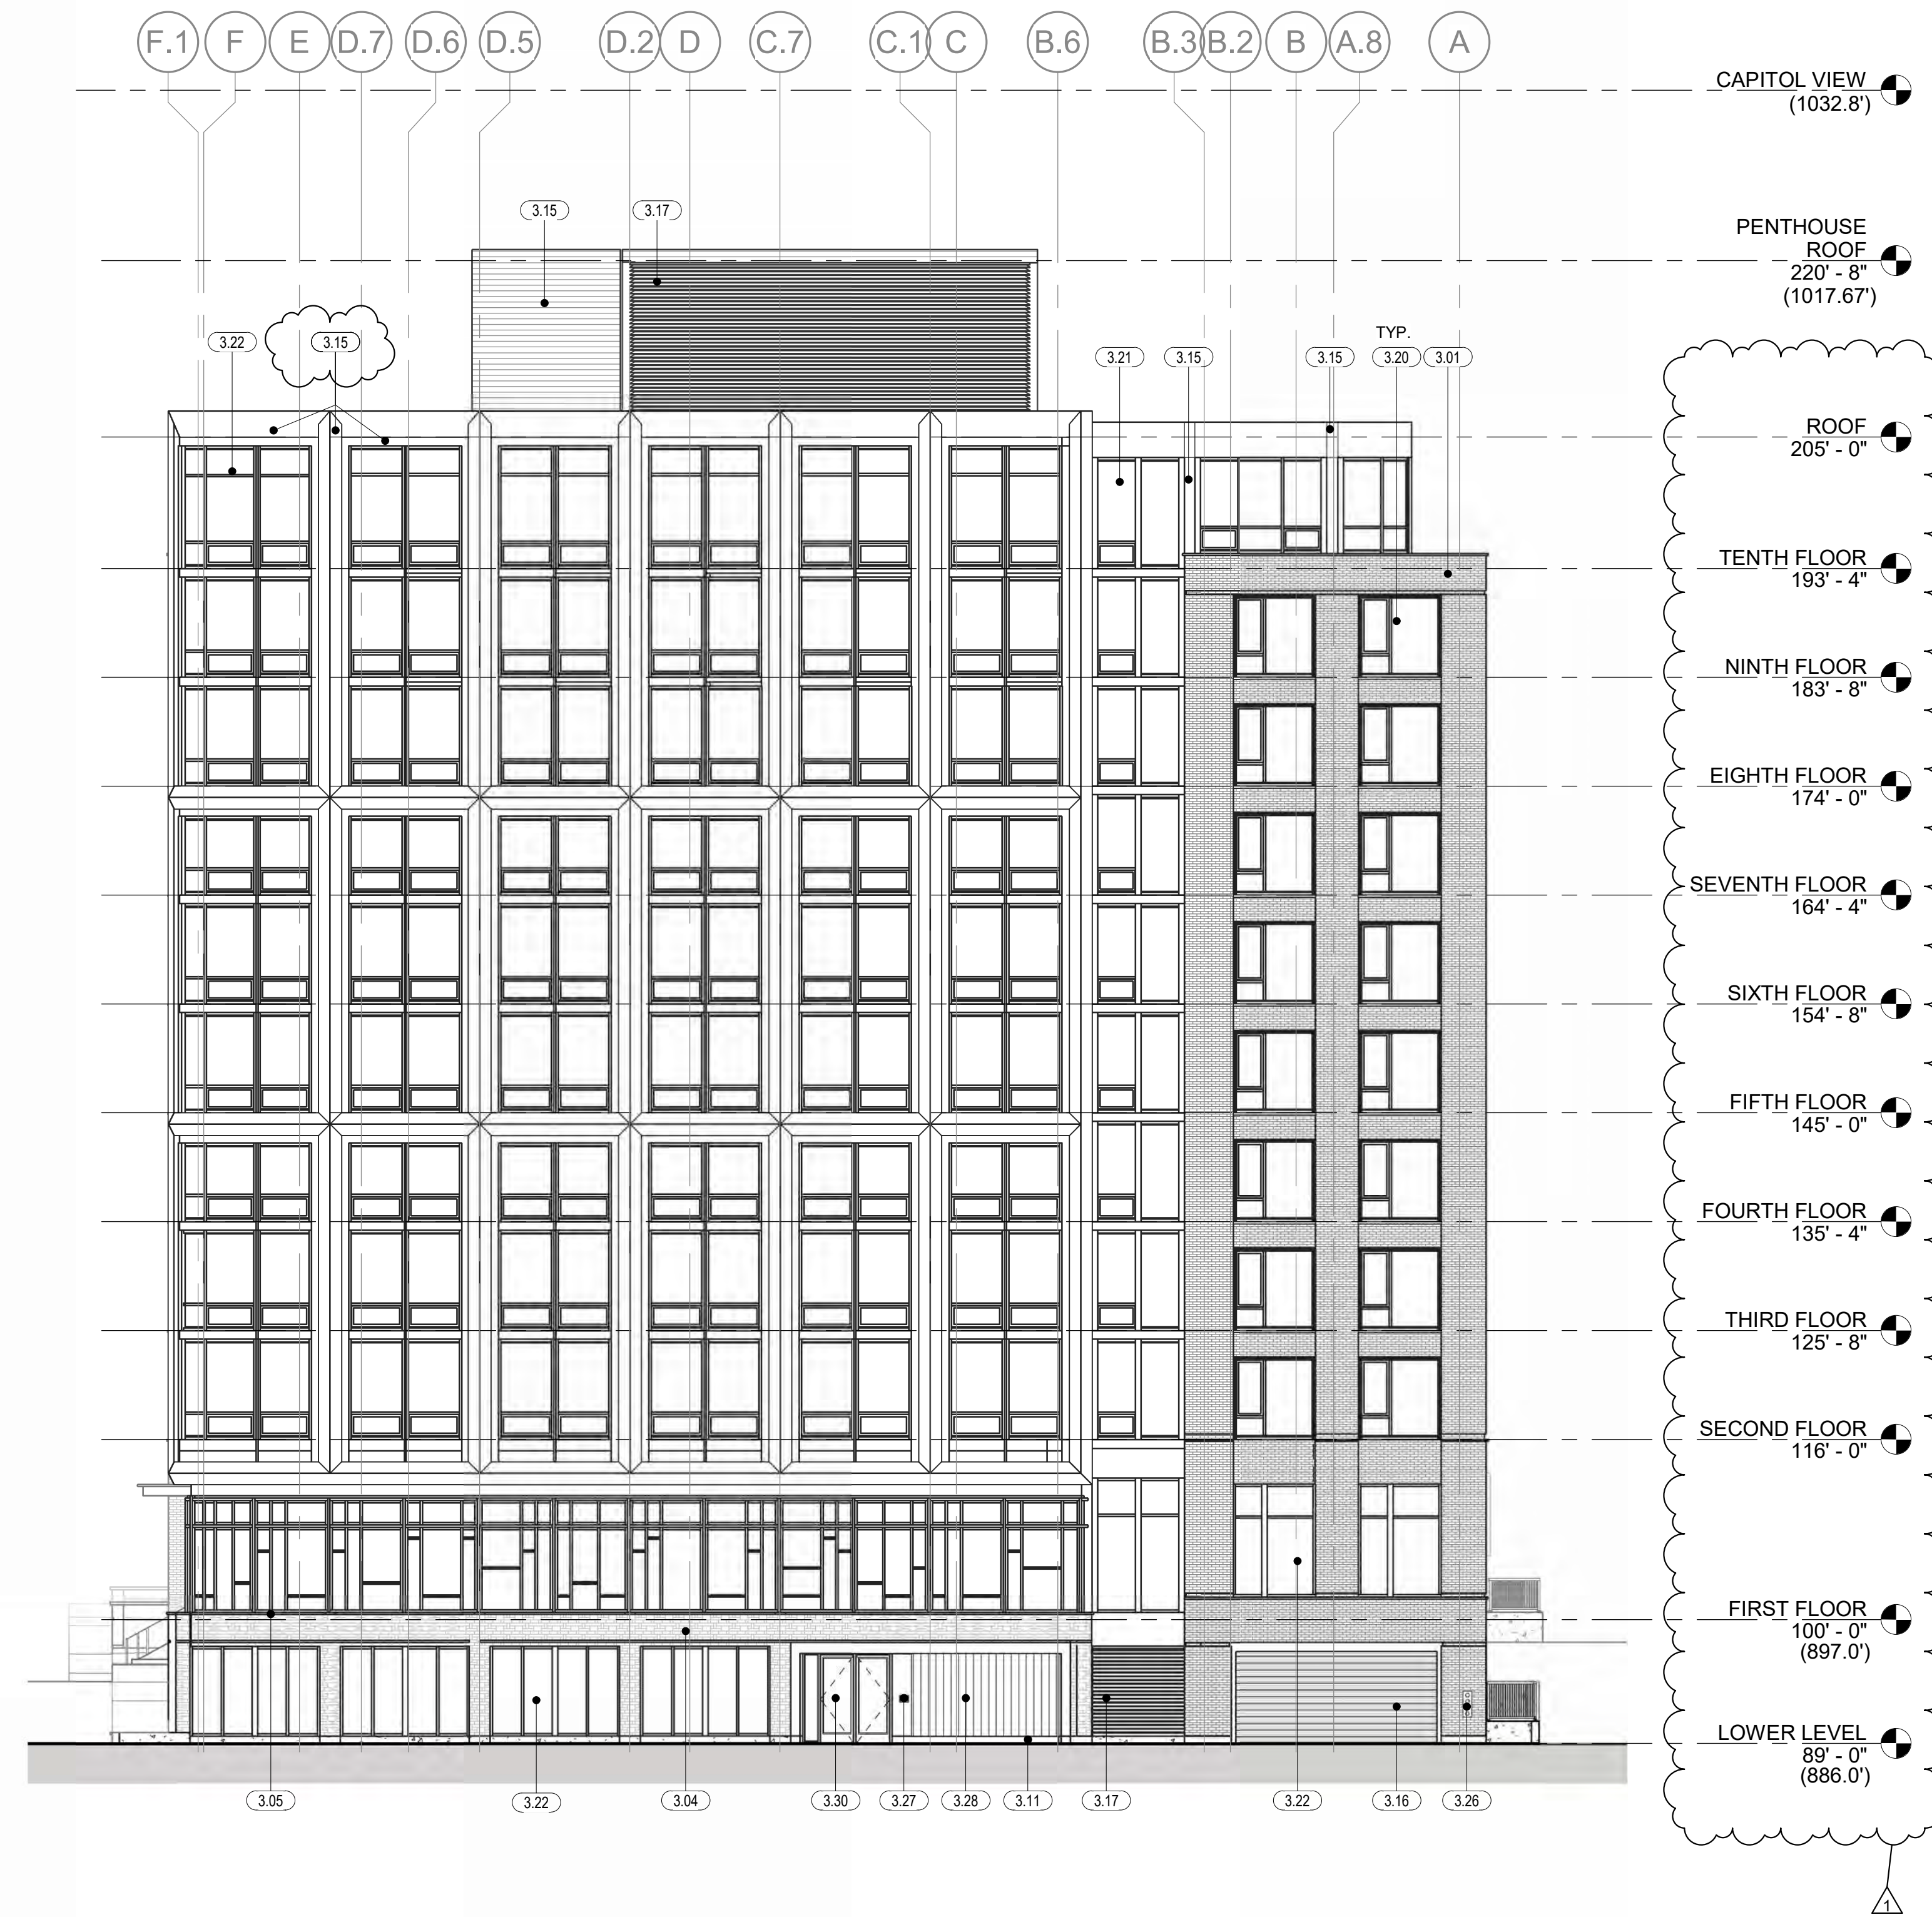

2 NORTHEAST ELEVATION - (NORTH HANCOCK STREET)
A201 3/32" = 1'-0"

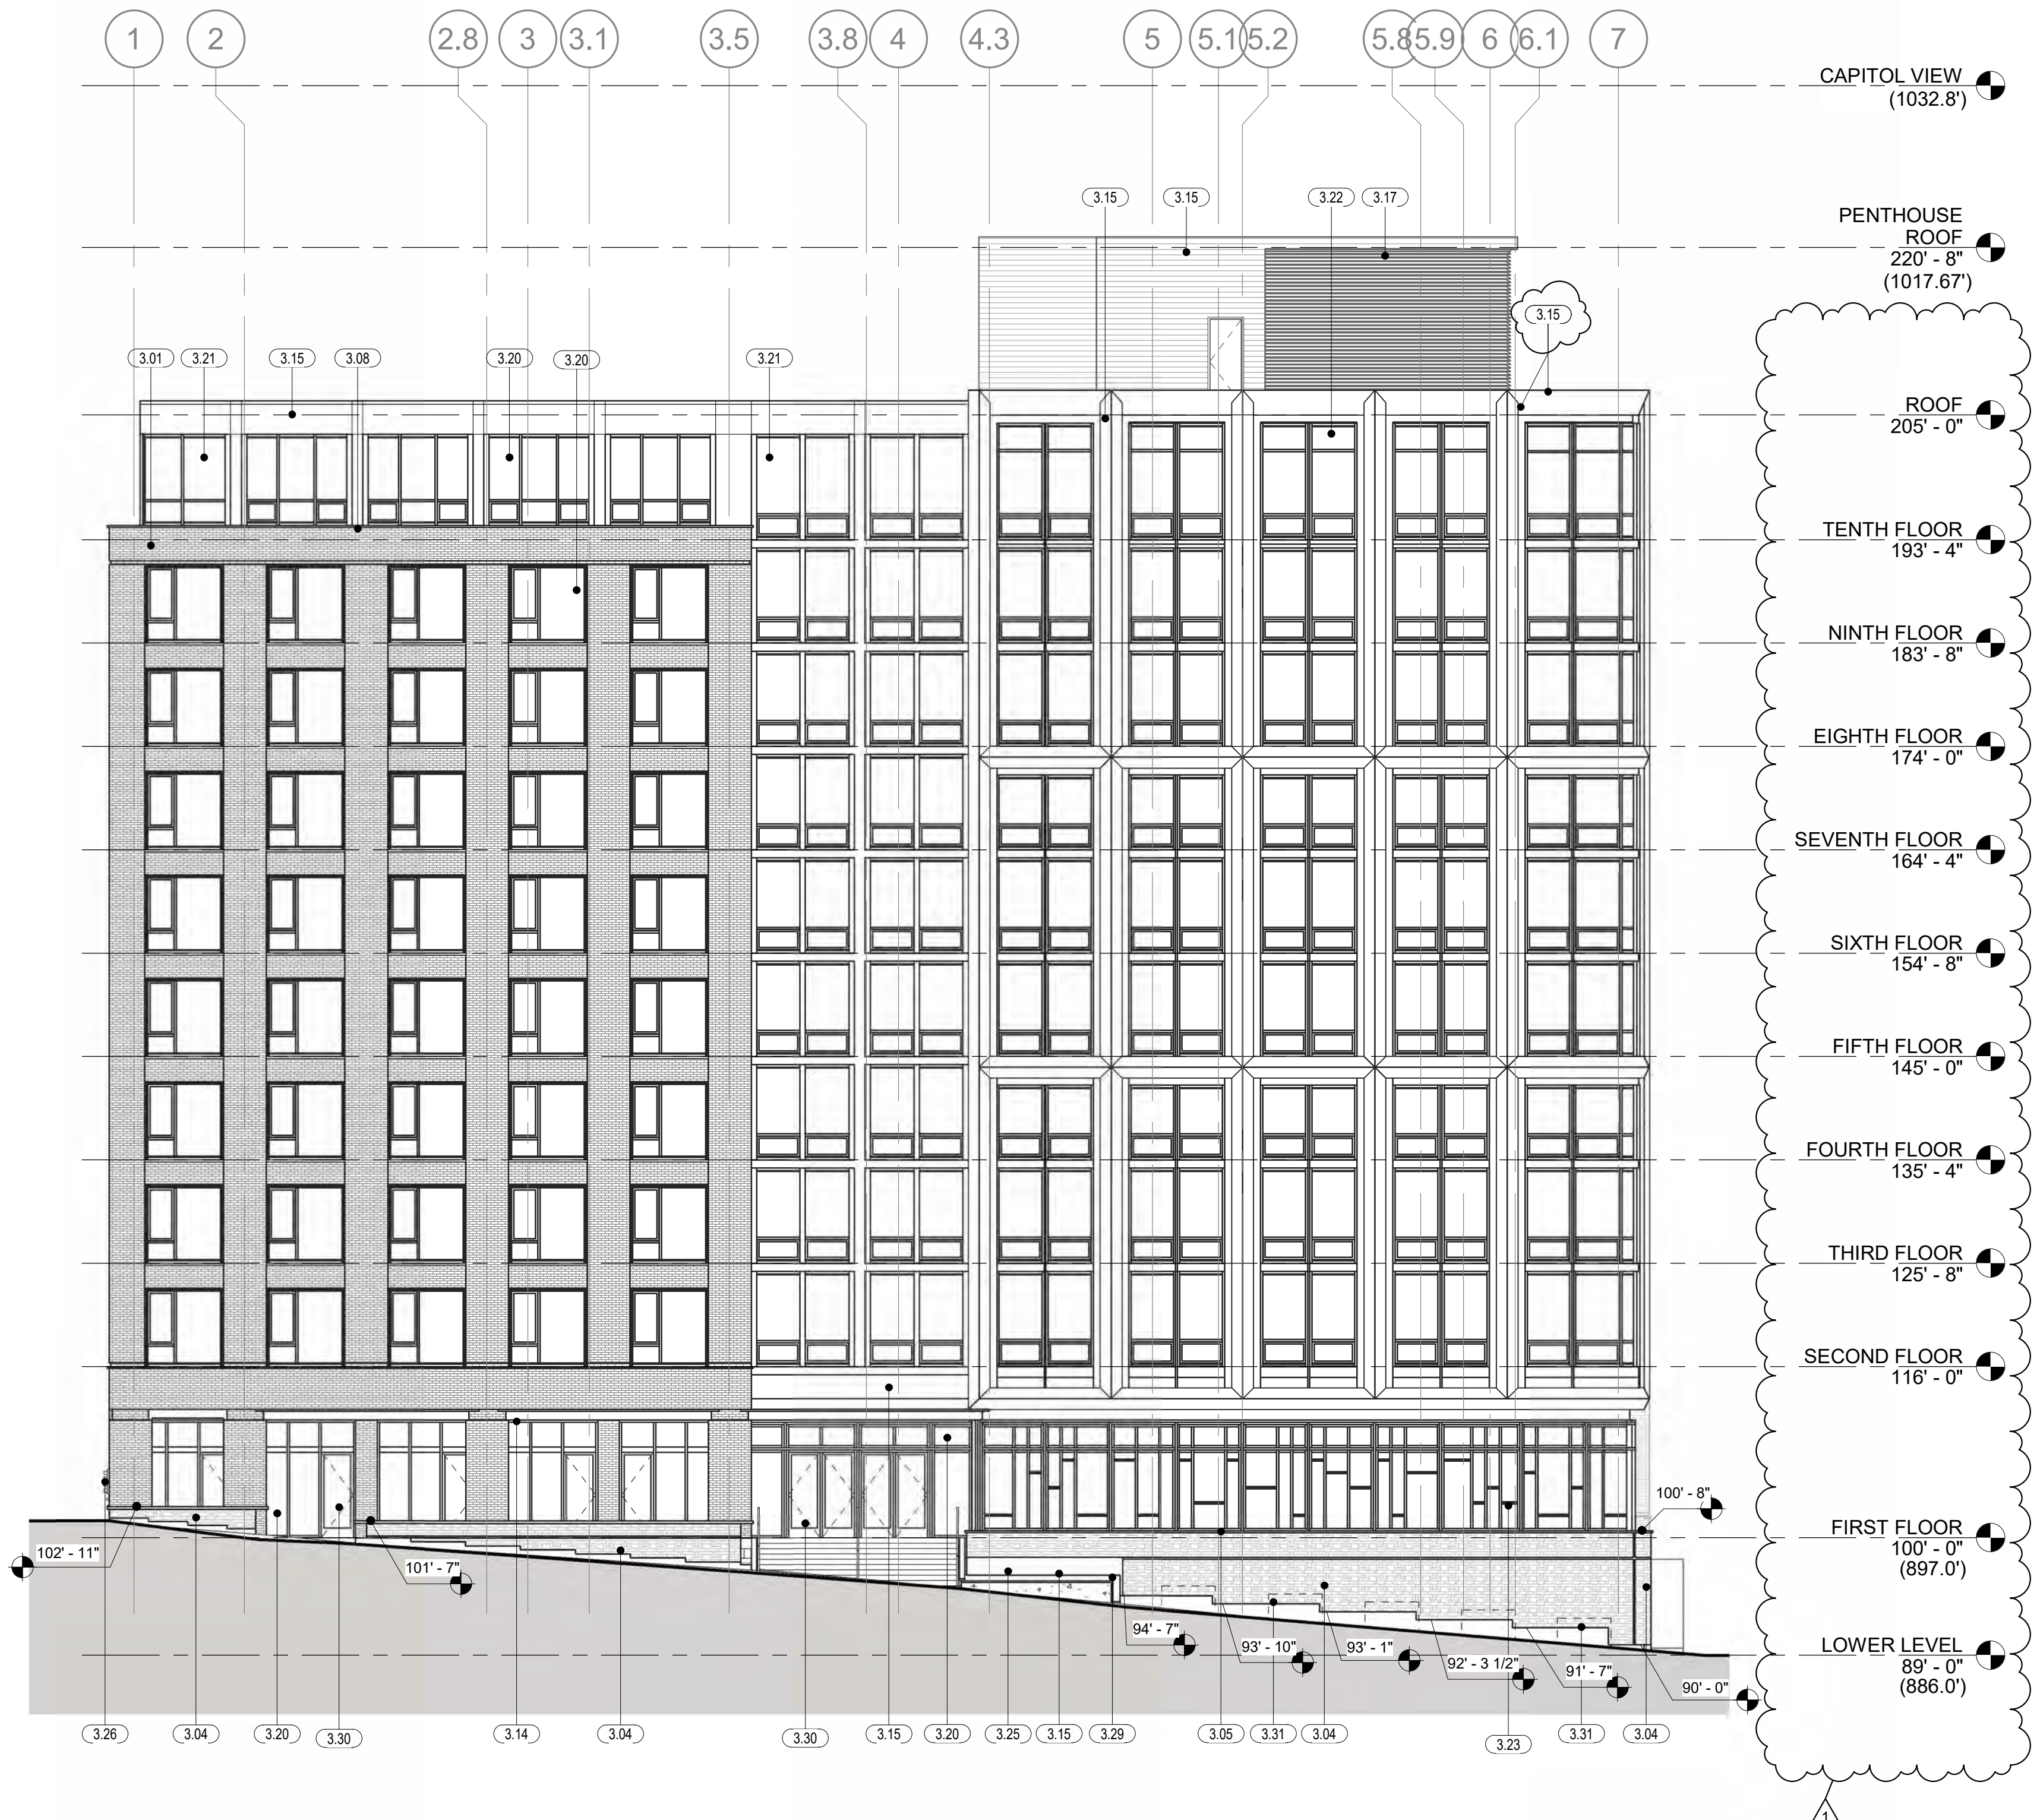

1 SOUTHEAST ELEVATION - (EAST WASHINGTON AVENUE)
A201 3/32" = 1'-0"

Key Value	Keynote Text
3.01	BRICK VENEER - RUNNING BOND
3.04	STONE VENEER PANELS
3.05	STONE CORNING SILL
3.08	PRECAST STONE SILL
3.11	SITE CAST CONCRETE RETAINING WALL/FOUNDATION
3.14	PAINTED ACCENT STEEL LINTEL
3.15	CONCEALED FASTENER ANODIZED METAL PANEL
3.16	COLING OVERHEAD DOOR
3.17	MECHANICAL LOUVER
3.20	WINDOW UNIT
3.21	WINDOW WALL GLAZING SYSTEM
3.22	STOREFRONT GLAZING SYSTEM
3.23	CURTAIN WALL GLAZING SYSTEM
3.25	ZONE OF PROPOSED SIGNAGE
3.26	MFJ HOSE CONNECTION
3.27	RECESSED MFJ KNOX BOX
3.28	METALLIC FAUX WOOD SLAT
3.29	PRECAST CONCRETE BENCH
3.30	ALUMINUM ENTRY DOOR
3.31	MODULAR PLANTERS

Notes:

PRELIMINARY
NOT FOR CONSTRUCTION

St. Johns Lutheran Church
Redevelopment
328 East Washington Avenue
Madison, WI


Hancock Street Apartments
6 North Hancock Street
Madison, WI

2021.09.00


DATE	ISSUANCE/REVISIONS
09/29/2023	DESIGN DEVELOPMENT DOCUMENTS
6/14/2024	MINOR ALTERATION

**BUILDING
ELEVATIONS**

A201

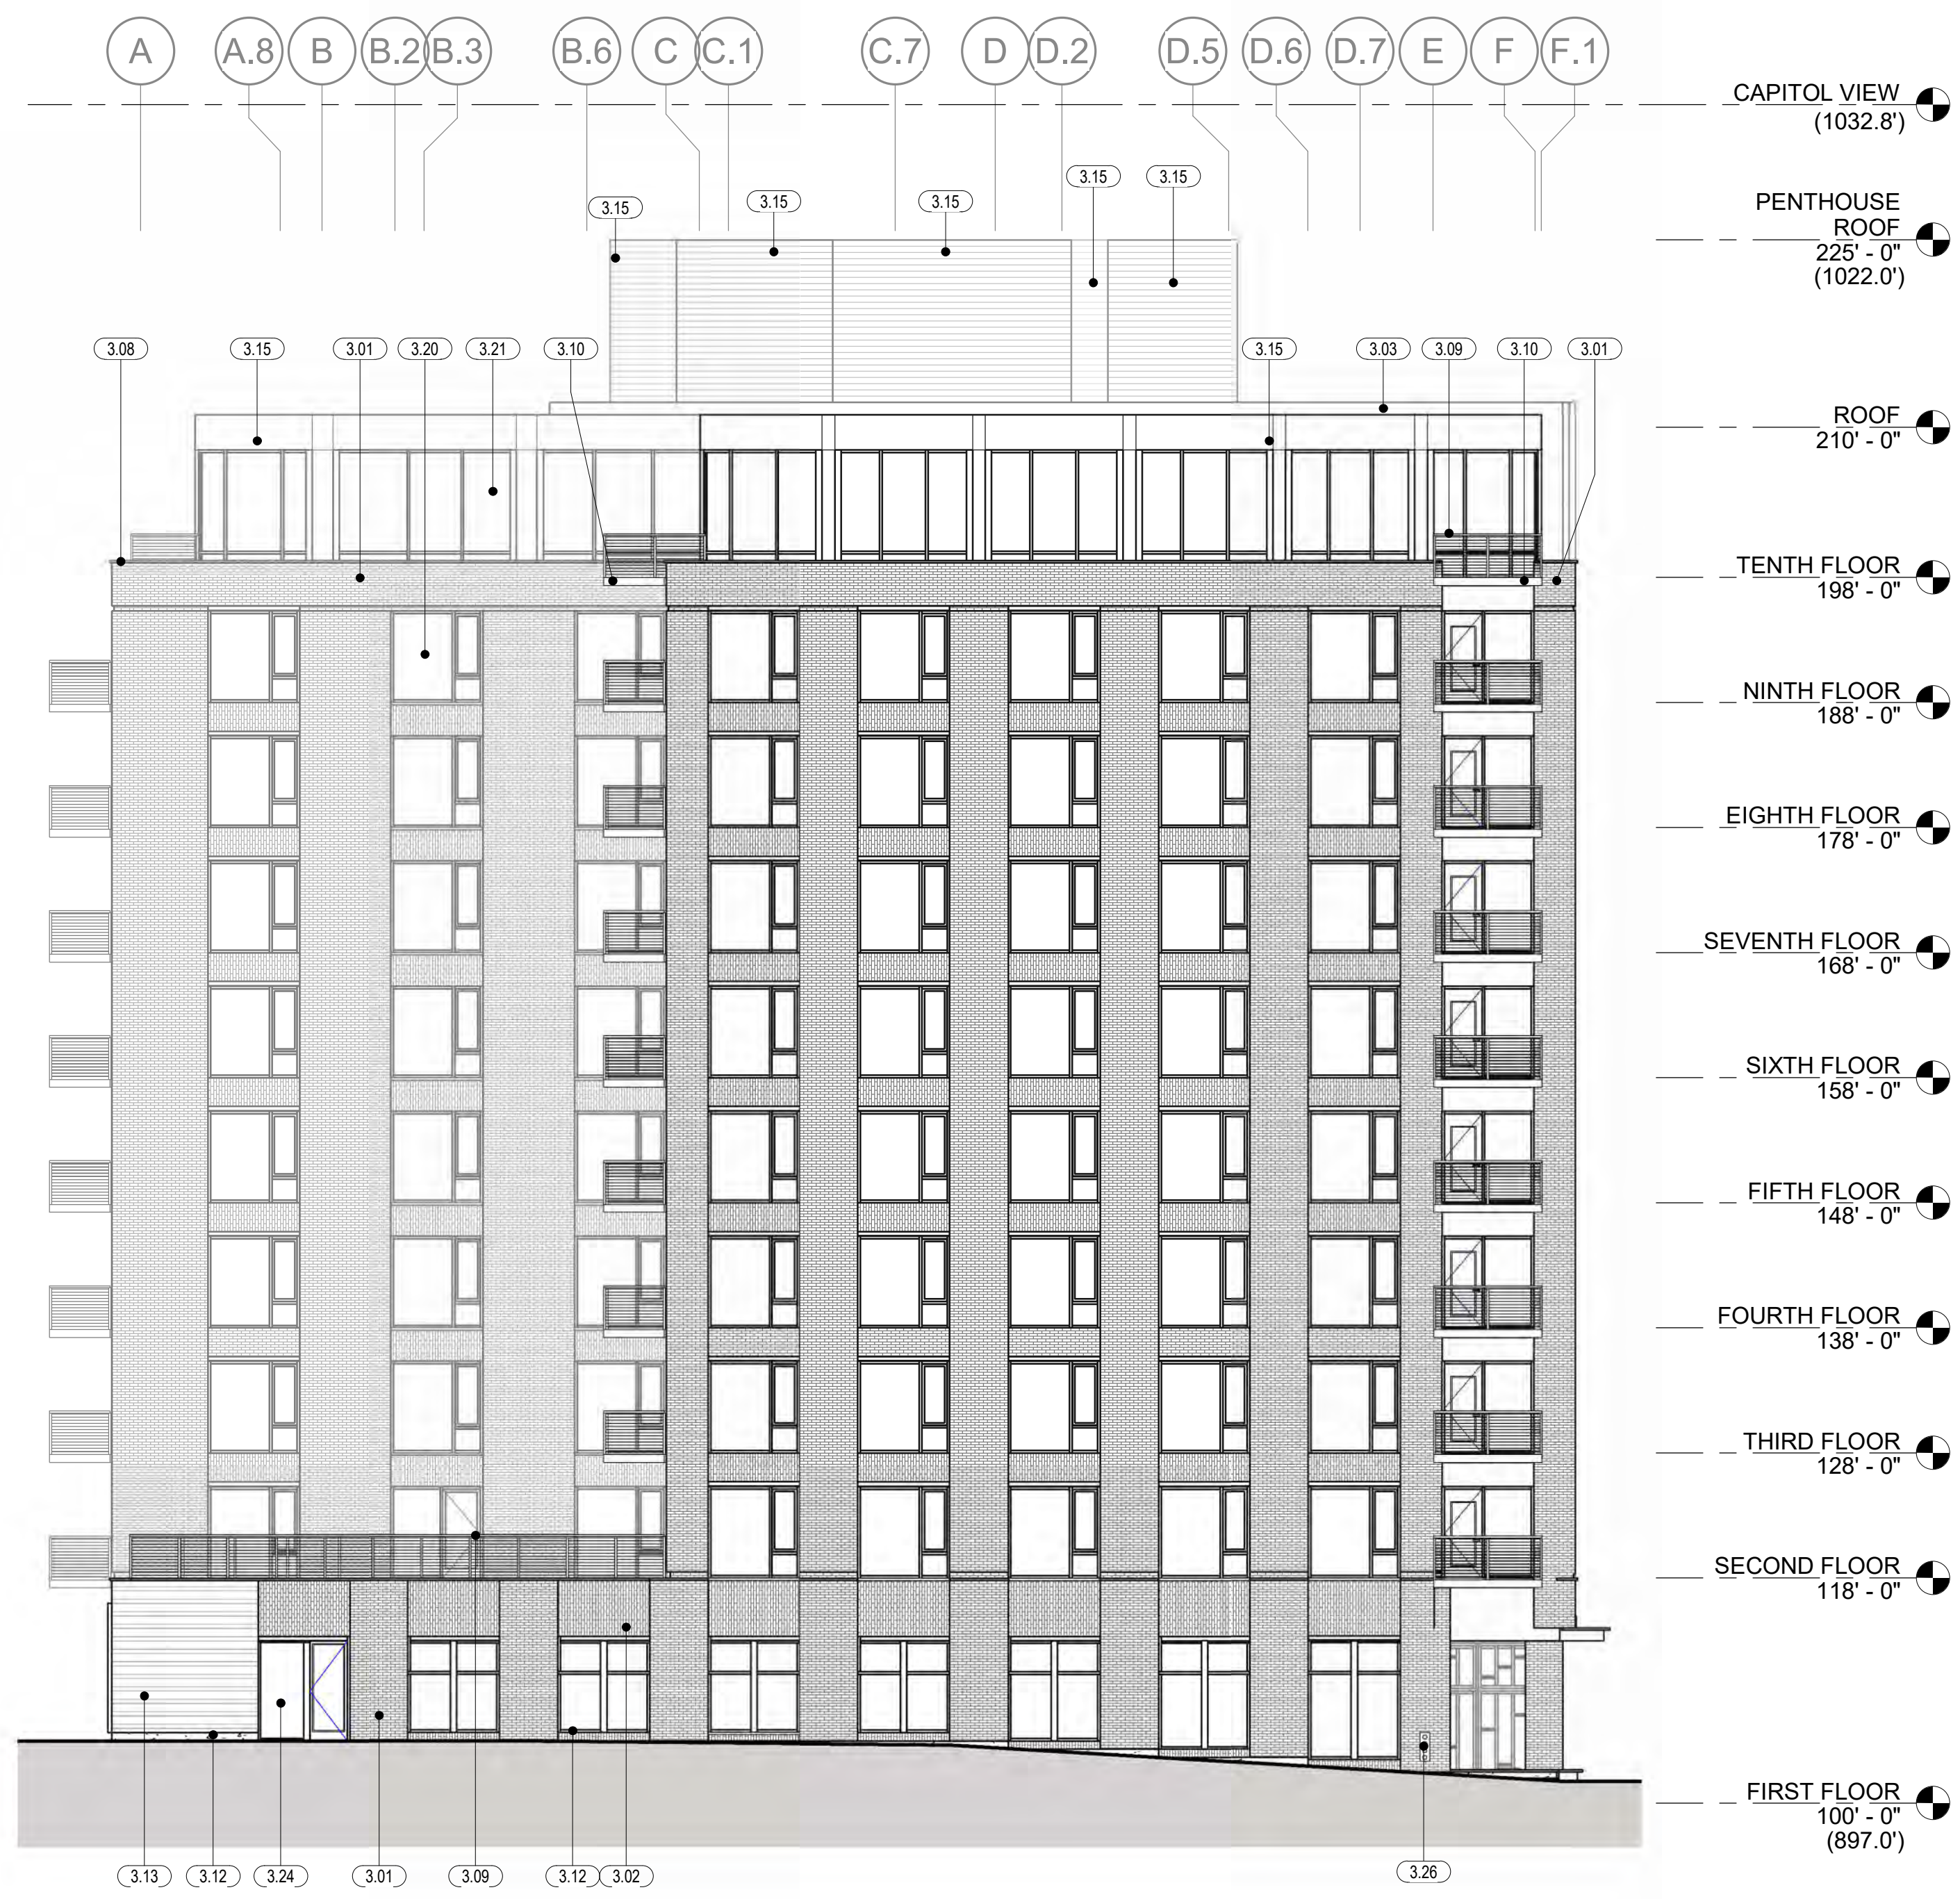

2 **SOUTHWEST ELEVATION**
A202 3/32" = 1'-0"

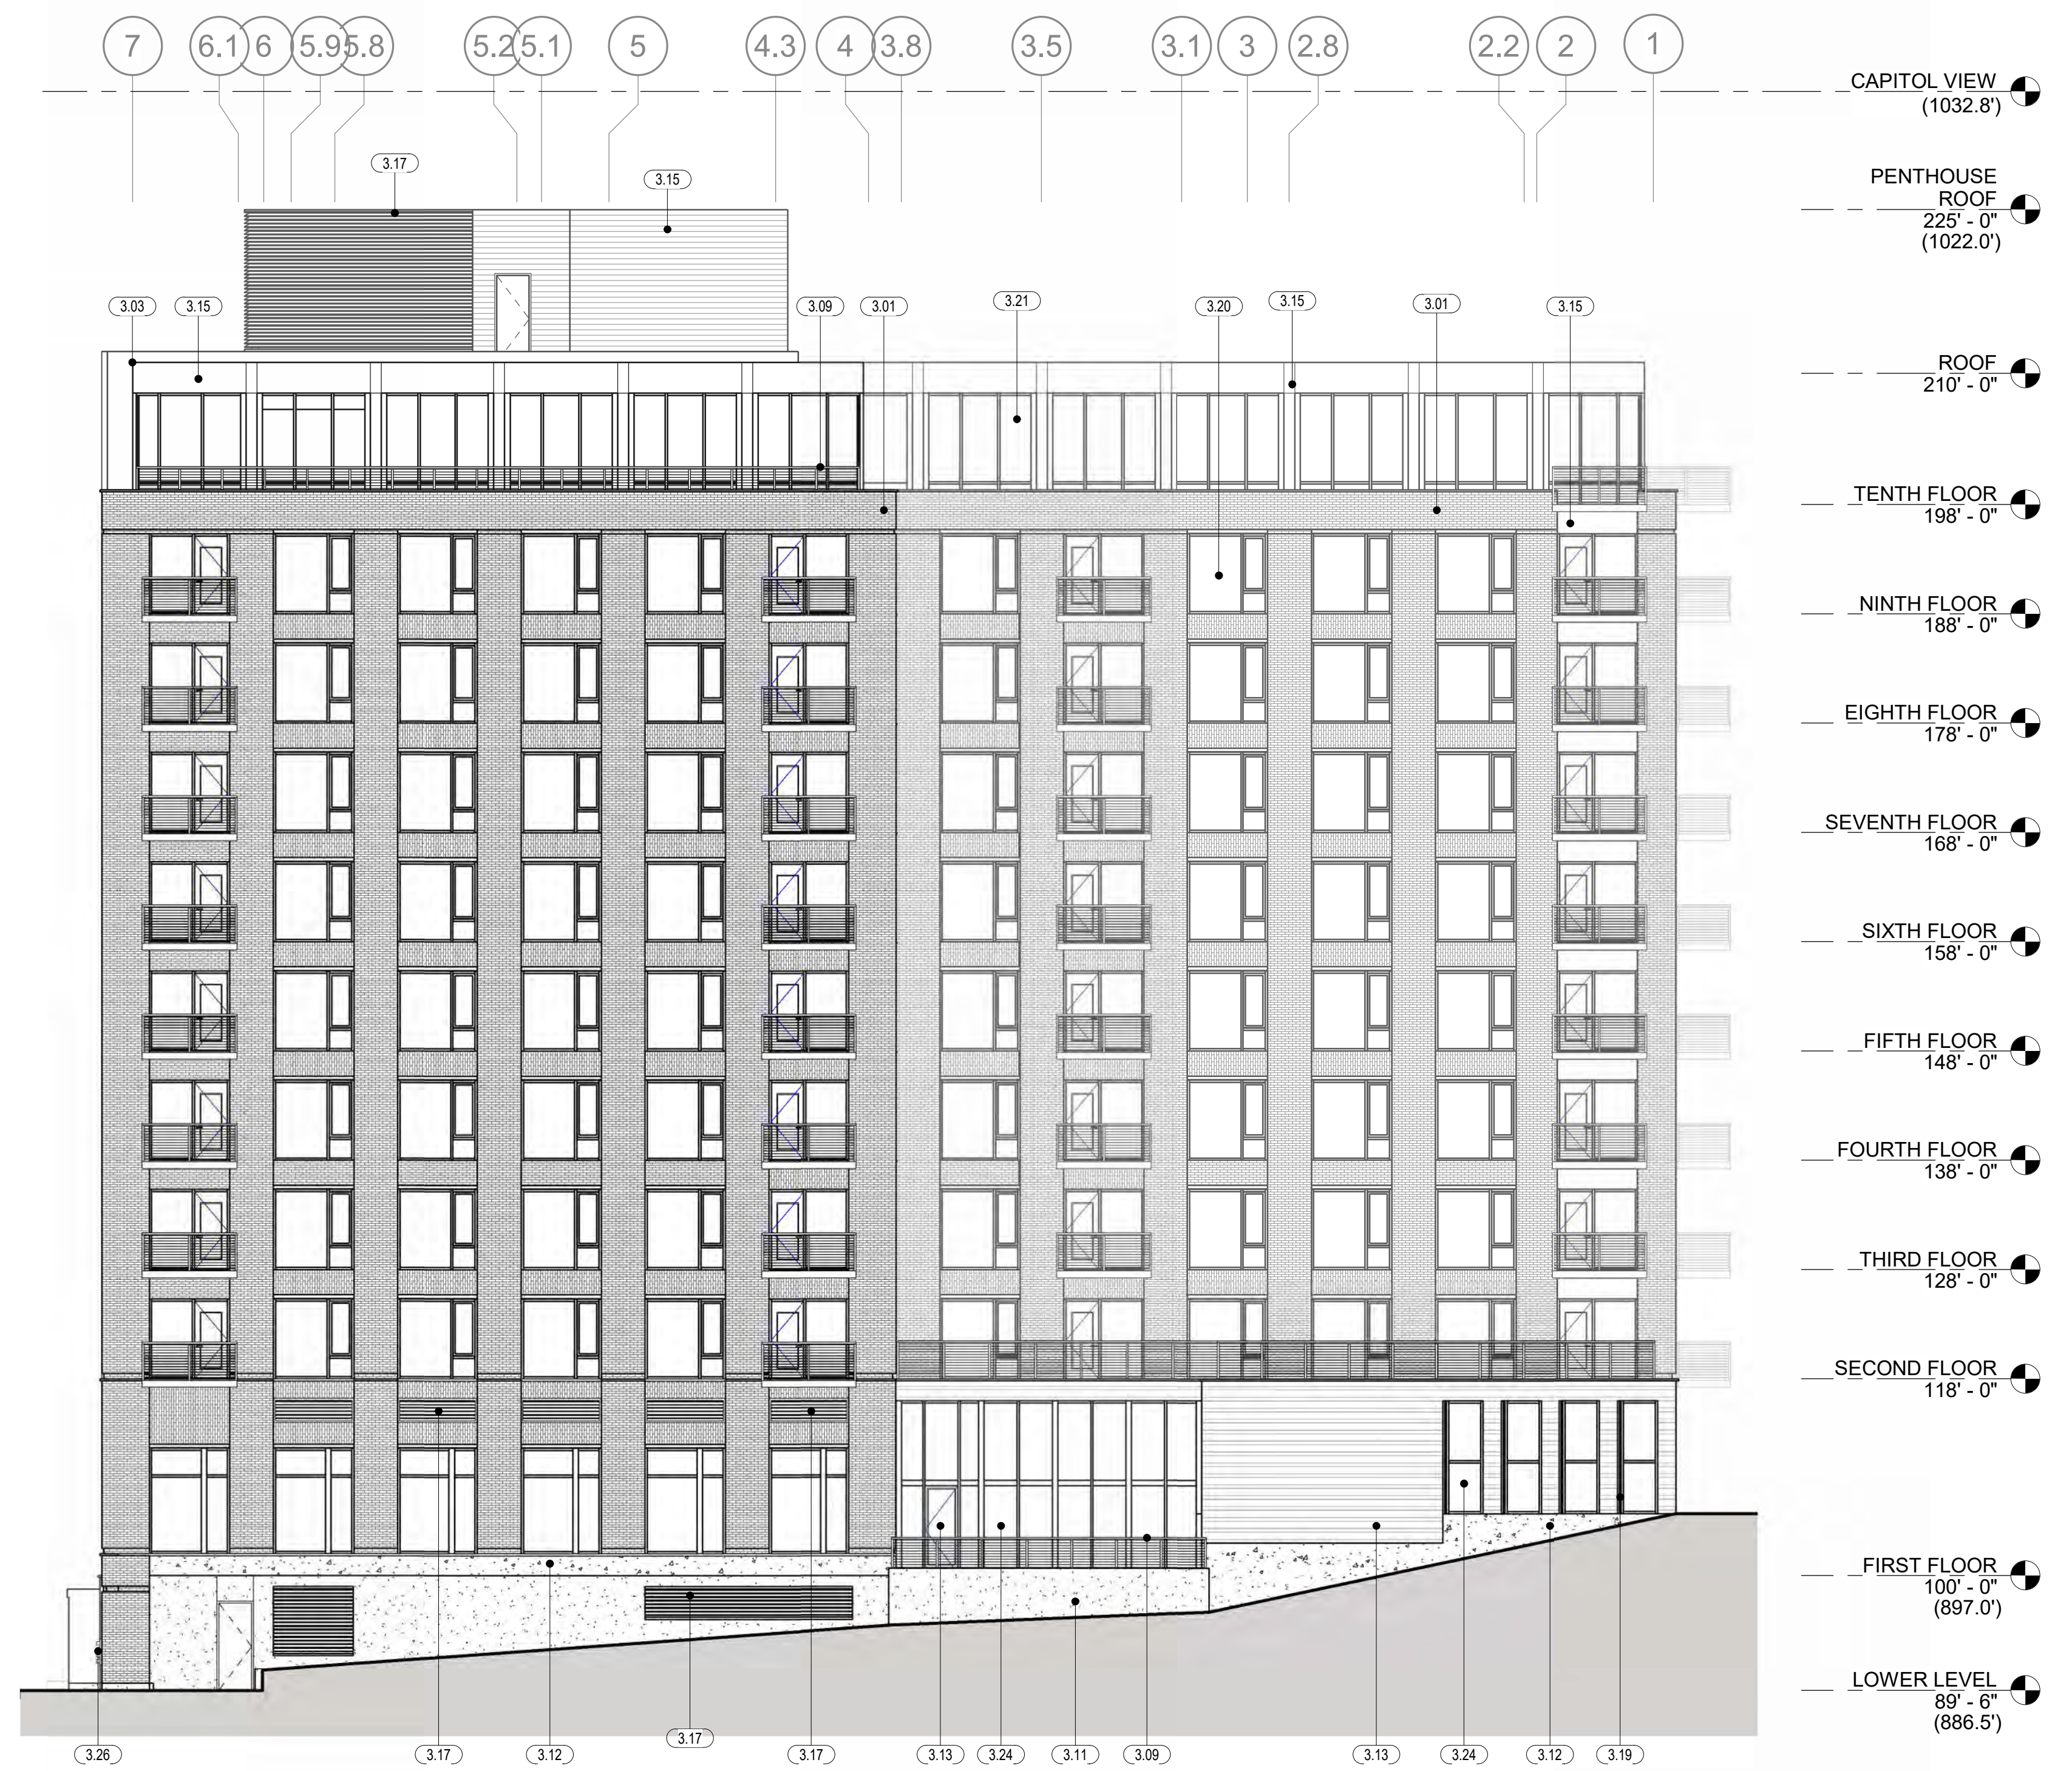

1 **NORTHWEST ELEVATION**
A202 3/32" = 1'-0"

Notes:
INSULATING GLASS TYPES (IGU)
ALL IGU TYPES ARE TYPE "A"
UNLESS NOTED OTHERWISE
◊ IGU - A
◊ IGU - B

PRELIMINARY
NOT FOR CONSTRUCTION

St. Johns Lutheran Church
348 East Washington Avenue
Madison, WI

Hancock Street Apartments
6 North Hancock Street
Madison, WI

2021.09.00

DATE: 08/18/2023
ISSUANCE/REVISIONS: CITY OF MADISON - SITE PLAN REVIEW

Key Value	Keynote Text
3.01	BRICK VENEER - RUNNING BOND
3.02	BRICK VENEER - STACKED SOLDER BOND
3.03	PRECAST CONCRETE PANEL
3.04	STONE VENEER PANELS
3.05	STONE COPING/SILL
3.06	STONE VENEER PLANTER W/ STONE COPING
3.08	PRECAST STONE SILL
3.09	ANODIZED ALUMINUM GUARDRAIL
3.10	CONCRETE BANCONY
3.11	SITE CAST CONCRETE RETAINING WALL/FOUNDATION
3.12	PRECAST CONCRETE BASE
3.13	HIGH DENSITY FIBER CEMENT BOARD
3.14	ACCENT STEEL LITTEL
3.15	CONCEALED FASTENER ANODIZED METAL PANEL
3.16	COILING GARAGE DOOR
3.17	MECHANICAL LOUVER
3.19	FAUX WOOD VANEER EXTRUDED ALUMINUM FIN
3.20	FIBER GLASS WINDOW GLAZING SYSTEM
3.21	FIBER GLASS WINDOW WALL GLAZING SYSTEM
3.22	FIBER GLASS STOREFRONT GLAZING SYSTEM
3.23	CURTAIN WALL GLAZING SYSTEM
3.24	CURTAIN WALL GLAZING SYSTEM
3.25	ZONE OF PROPOSED SIGNAGE
3.26	FIRE DEPARTMENT CONNECTION
3.27	RECESSED MFD KNOX BOX
6.01	HVAC UNIT
6.02	WASHER/DRYER VENTLESS
9.01	30"W REFRIGERATOR
9.02	36"W REFRIGERATOR
9.03	24" COOKTOP
9.04	30" RANGE
9.05	30" RANGE FRONT MOUNTED WITH ACCESSIBLE CONTROLS
9.06	RANGE VENT
9.07	DISHWASHER
9.08	ACCESSIBLE DISHWASHER
9.09	OVER-RANGE MICROWAVE
9.10	COUNTERTOP MICROWAVE
9.11	PULL-OUT TRASH AND RECYCLING BINS

**PREVIOUS 8.18.2023
BUILDING
ELEVATIONS**

A202

Notes:

PRELIMINARY
NOT FOR CONSTRUCTION

St. Johns Lutheran Church
Redevelopment
328 East Washington Avenue
Madison, WI

Hancock Street Apartments
6 North Hancock Street
Madison, WI


2021.09.00

DATE	ISSUANCE/REVISIONS
09/29/2023	DESIGN DEVELOPMENT DOCUMENTS
6/14/2024	MINOR ALTERATION


Key Value	Keynote Text
3.01	BRICK VENEER - RUNNING BOND
3.03	PRECAST CONCRETE PANEL
3.09	ANODIZED ALUMINUM GUARDRAIL
3.11	SITE CAST CONCRETE RETAINING WALL/FOUNDATION
3.13	FIBER CEMENT BOARD SIDING
3.15	CONCEALED FASTENER ANODIZED METAL PANEL
3.17	MECHANICAL LOUVER
3.19	FALX WOOD EXTRUDED ALUMINUM SYSTEM
3.20	WINDOW UNIT
3.21	WINDOW WALL GLAZING SYSTEM
3.22	STOREFRONT GLAZING SYSTEM
3.26	MFD HOSE CONNECTION
3.32	H.M. DOOR

**BUILDING
ELEVATIONS**

A202

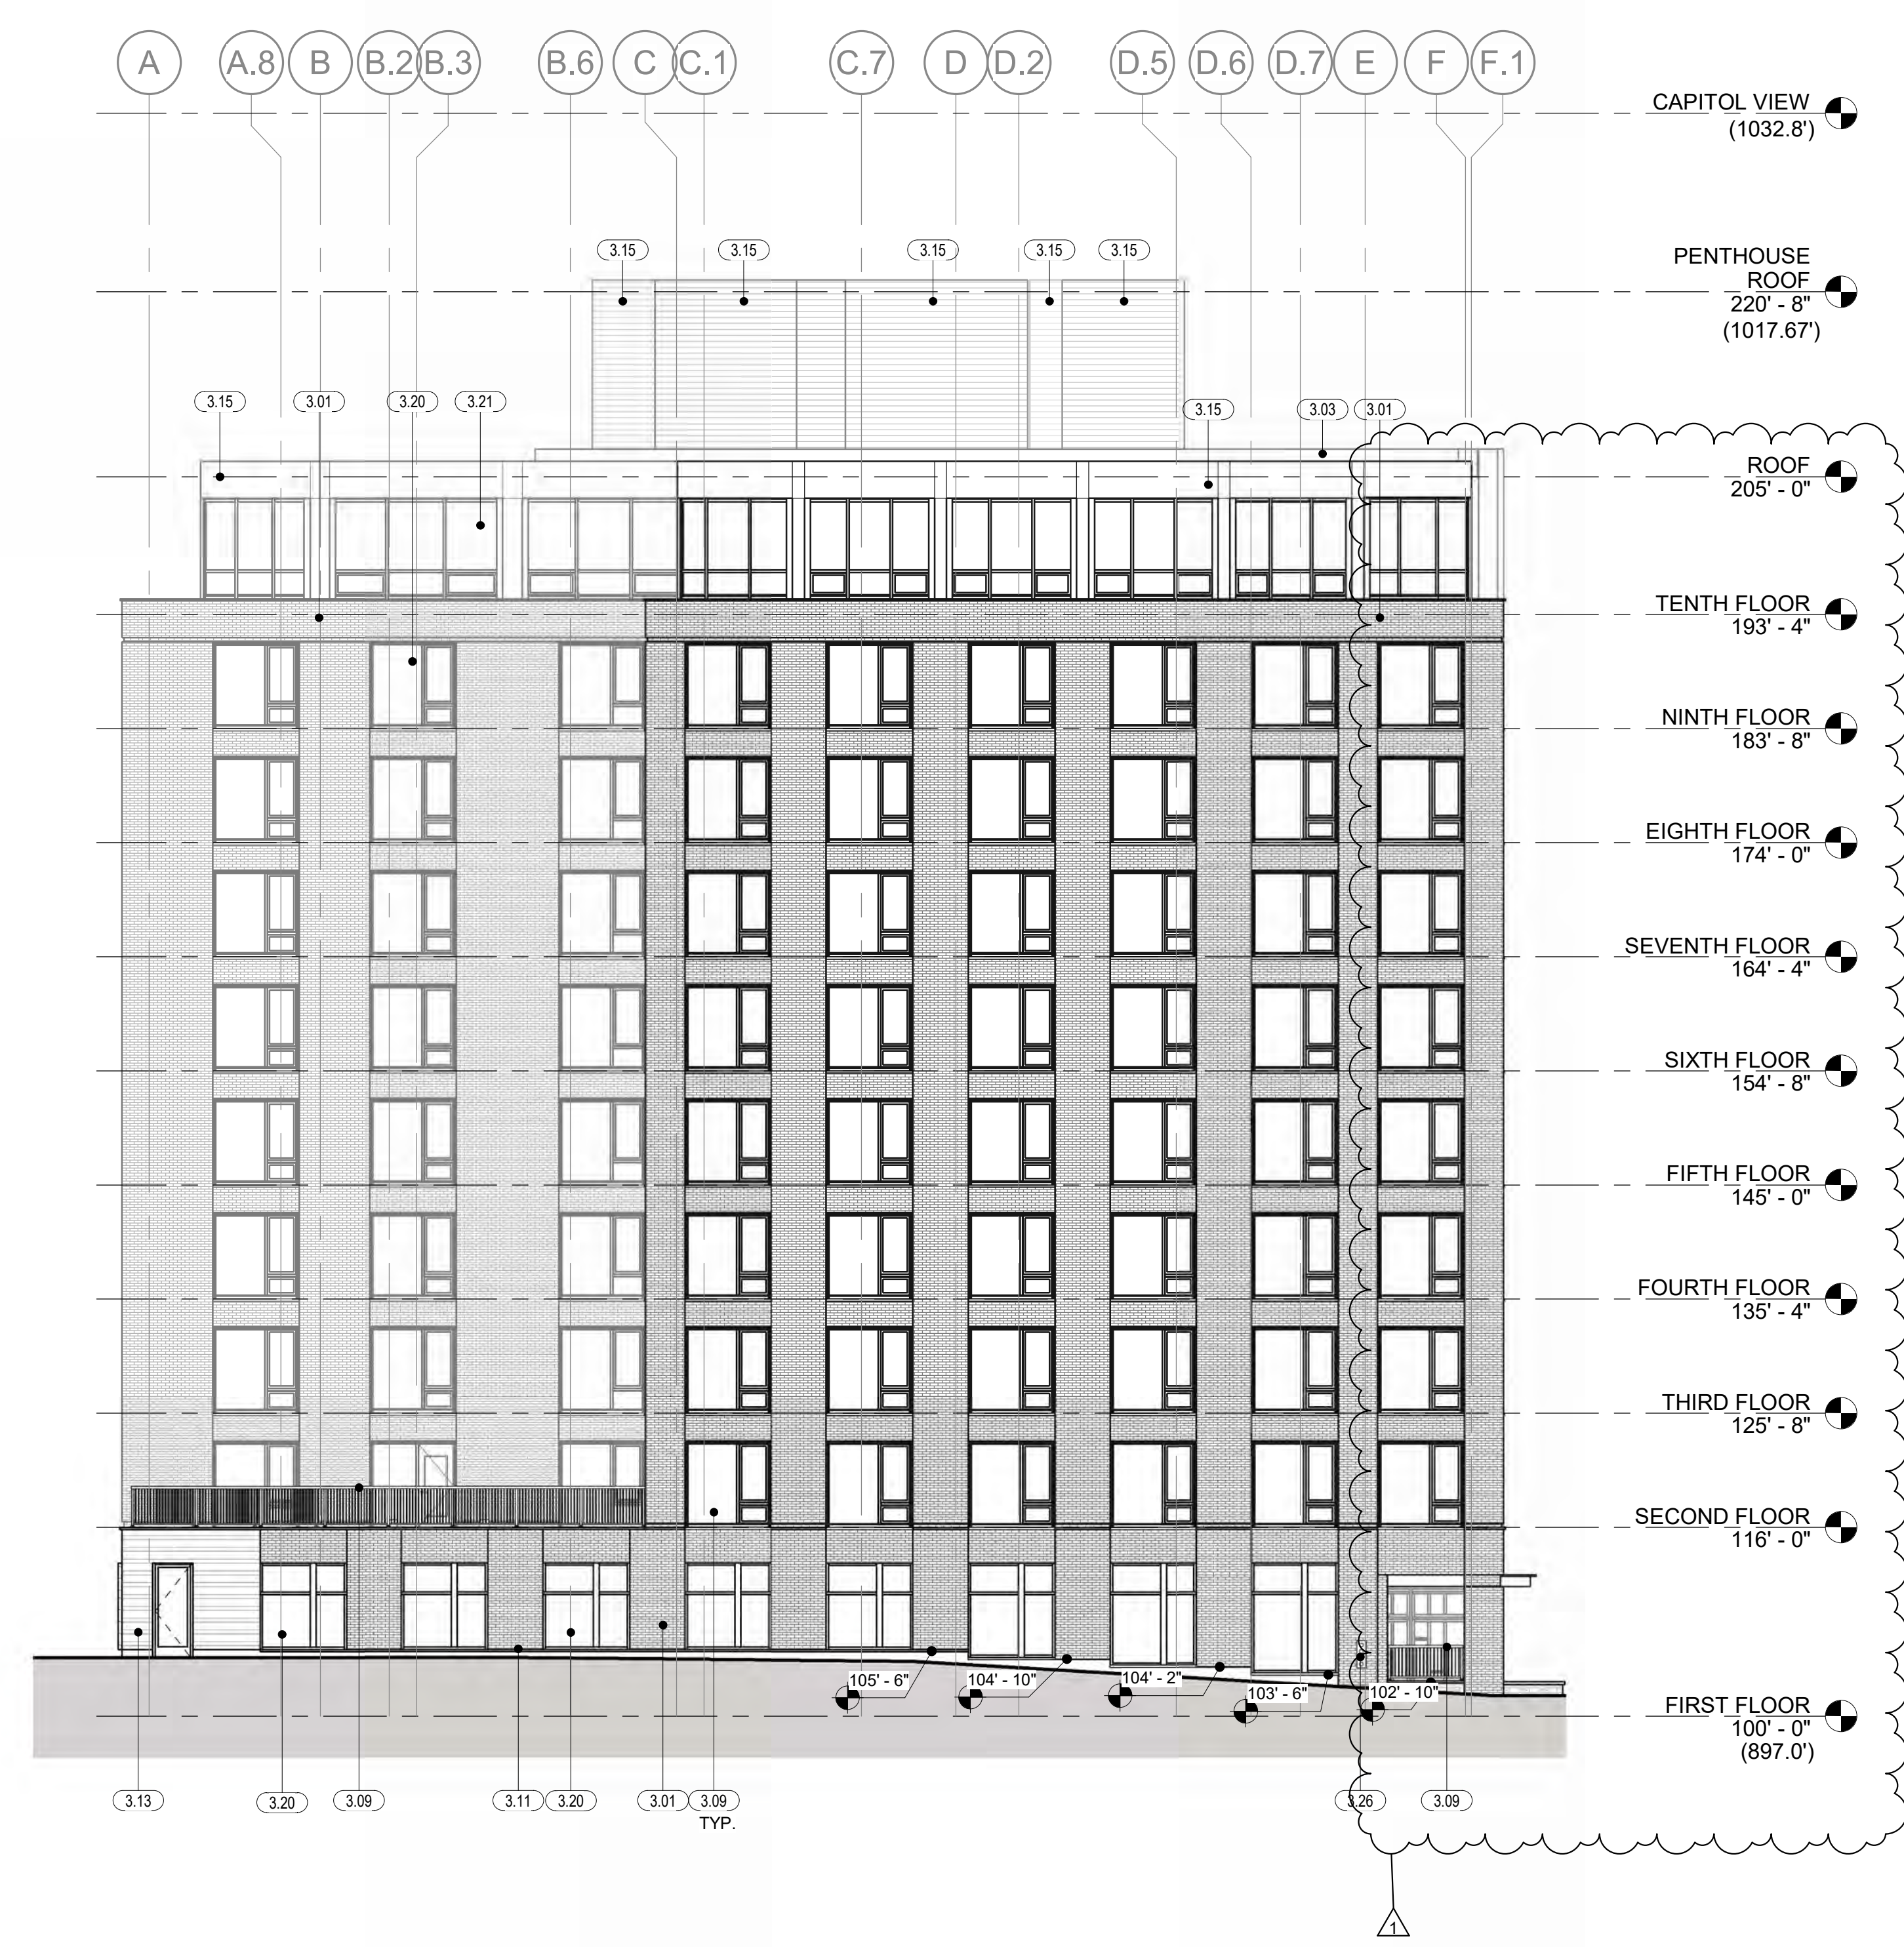

2 **SOUTHWEST ELEVATION**
A202 3/32" = 1'-0"

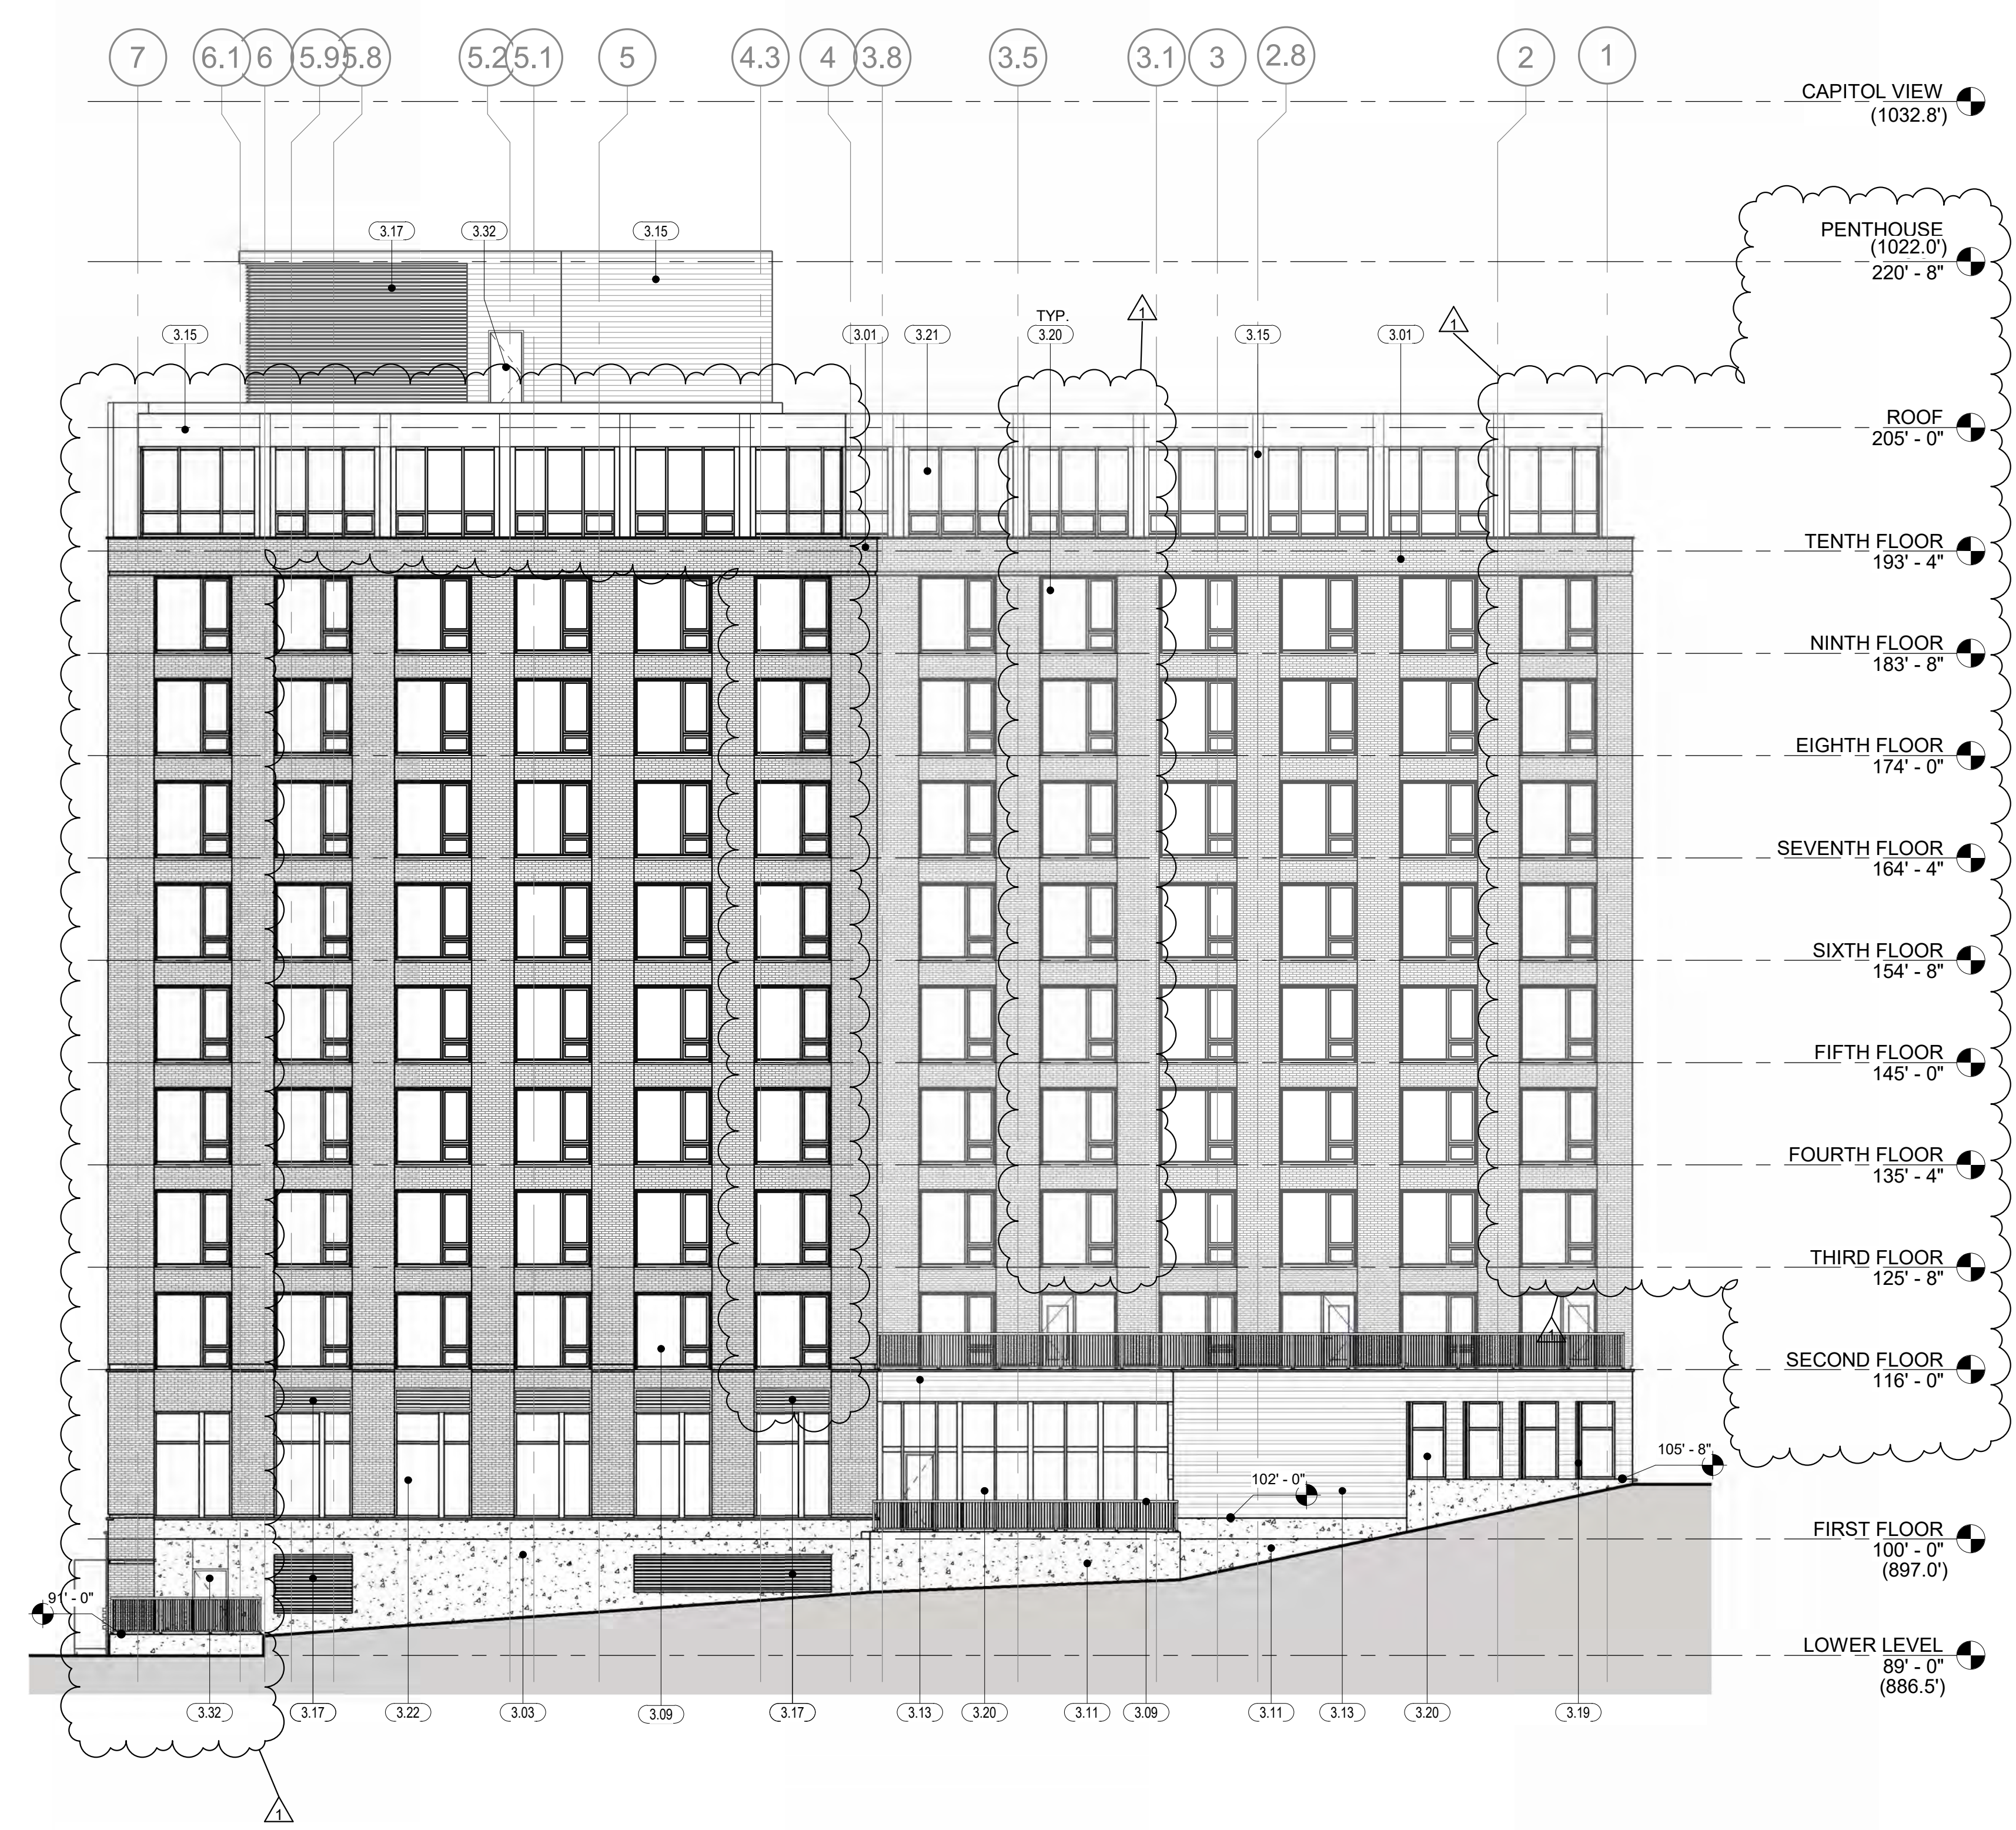

1 **NORTHWEST ELEVATION**
A202 3/32" = 1'-0"

Original Parking Plans Submitted for Approval:

Sheet A101 = P2 = 7 parking stalls

Sheet A102 = P1 = 35 parking stalls

Sheet A103 = LL = 21 parking stalls

Total Parking Stall Count = 63

Revised Parking Plan Submitted for Approval:

Sheet A103 = LL = 10 parking stalls

Total Parking Stall Count = 10

