

THIS PARCEL IS SUBJECT TO ANY AND ALL EASEMENTS AND AGREEMENTS, RECORDED AND UNRECORDED

BEFORE CONSTRUCTION CALL DIGGERS HOTLINE FOR LOCATION OF UNDERGROUND UTILITIES. 1-800-2428511


3-19-03 LAKE ELEVATION = 843.60'

SCALE 1" = 30'

- LARGE TREE
- PINE / CEDAR
- FOUND SURVEY MONUMENT
-

PREPARED FOR :

DON ANDERSON
2604 WAUNONA WAY
MADISON, WI, 53713

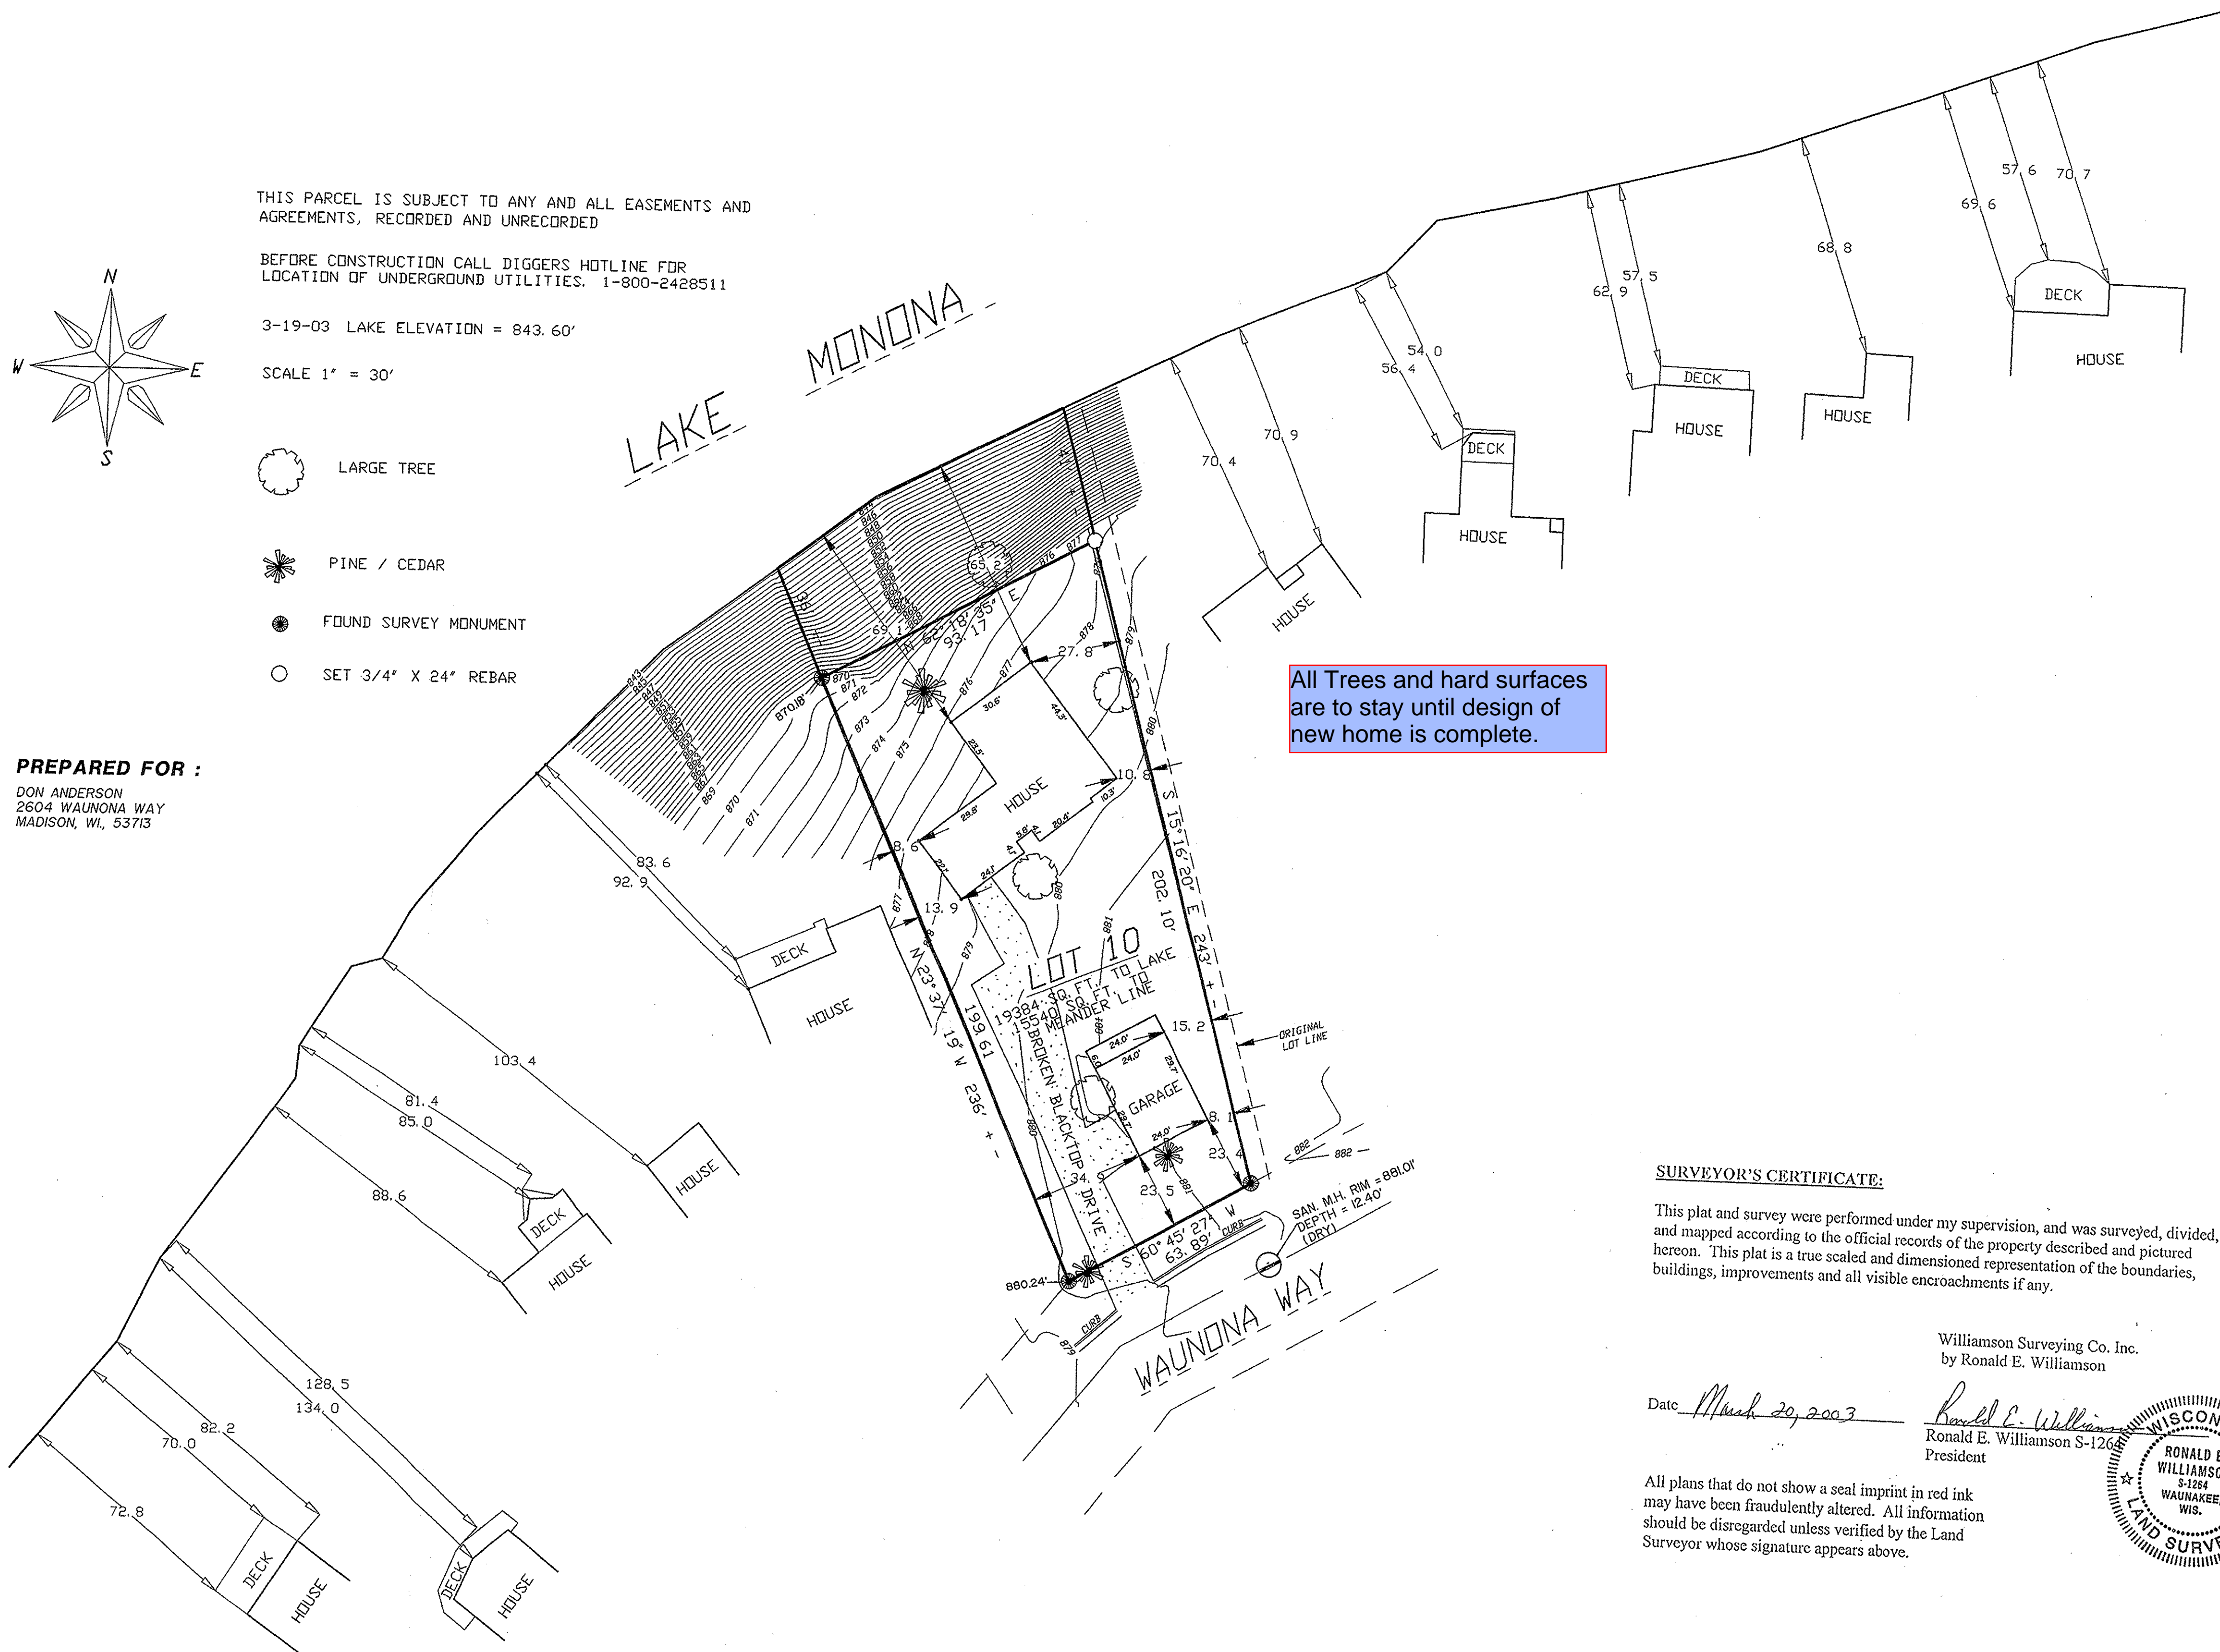

SURVEYOR'S CERTIFICATE:


This plat and survey were performed under my supervision, and was surveyed, divided, and mapped according to the official records of the property described and pictured hereon. This plat is a true scaled and dimensioned representation of the boundaries, buildings, improvements and all visible encroachments if any.

Williamson Surveying Co. Inc.
by Ronald E. Williamson

Date March 20, 2003

Ronald E. Williamson S-1268
President

All plans that do not show a seal imprint in red ink may have been fraudulently altered. All information should be disregarded unless verified by the Land Surveyor whose signature appears above.

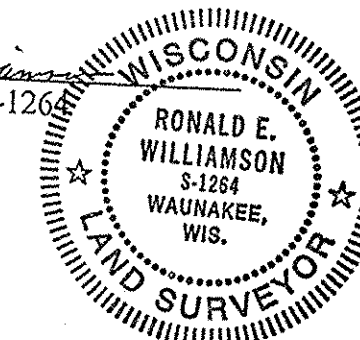

WILLIAMSON SURVEYING COMPANY	
104 A WEST MAIN STREET WAUNAKEE WISCONSIN 53597	
PHONE 1-(608)-255-5705	
TOPOGRAPHIC SURVEY	
PART OF LOT 10, BLOCK 2, RAYWOOD HEIGHTS, IN THE TOWN OF BLOOMING GROVE, DANE COUNTY, WISCONSIN.	
DATE 3-19-03	CHECKED