


EXISTING FLOOR PLAN

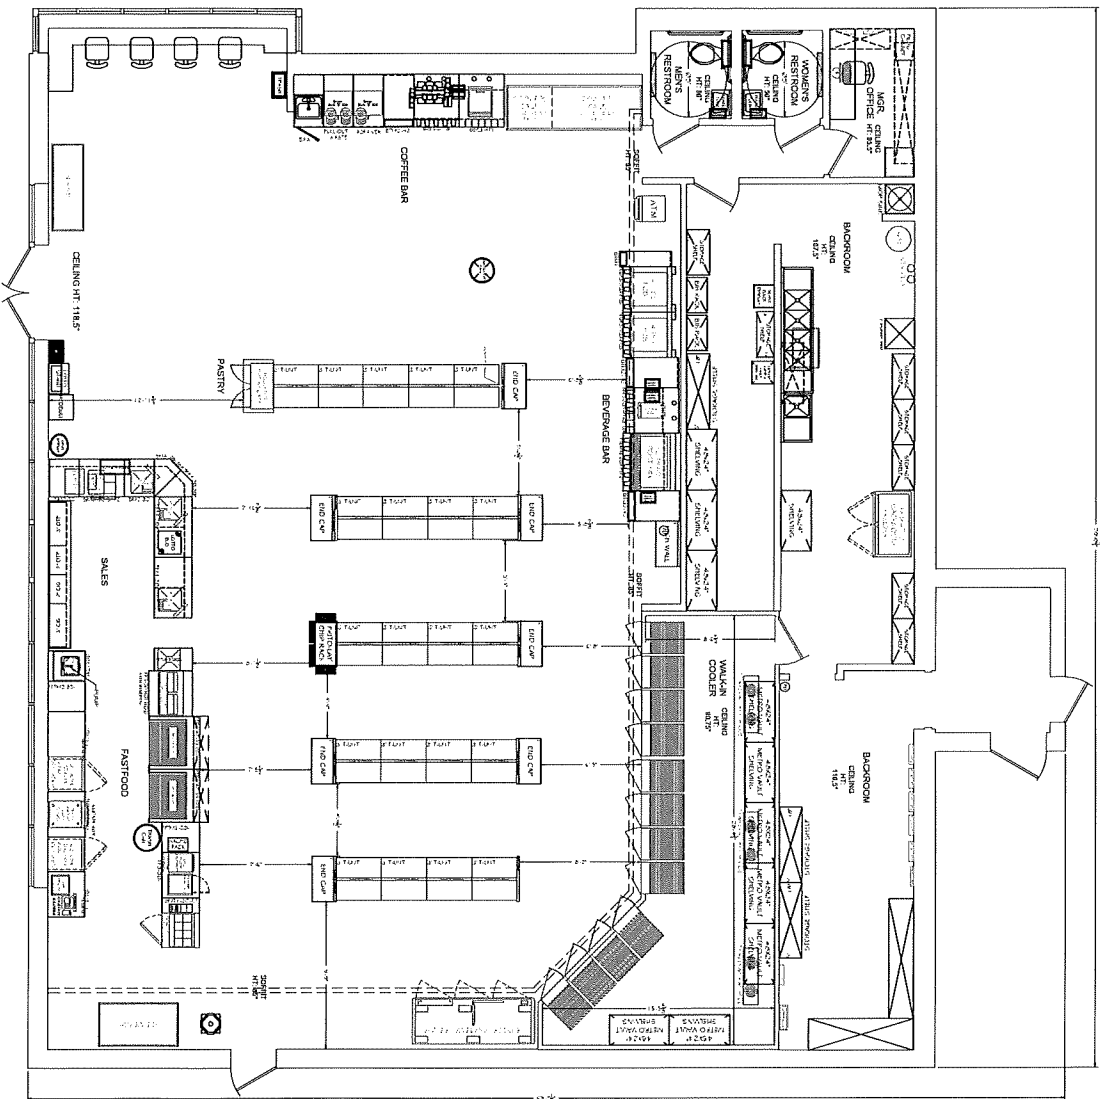

DISCLAIMER: THIS DRAWING AND ALL SUPPORTING DOCUMENTS CONTAINED IN THE "DRAWING PACKAGE" ARE THE PROPERTY OF ROYSTON GROUP, FIELD SERVICES DIVISION. ANY USE OF THE DRAWING, FILE OR ANY OF THE INFORMATION FOUND WITHIN FOR ANY PURPOSE OUTSIDE OF DIRECT REQUEST BY ROYSTON GROUP WILL BE SEEN AS A VIOLATION OF THE WORK AGREEMENT AND WILL BE PURSUED TO THE FULLEST EXTENT ALLOWABLE. THE DRAWINGS AND EQUIPMENT LISTS ARE INTENDED TO REPRESENT THE GENERALIZED CHARACTERISTICS OF THE SCOPE OF WORK BUT IN NO WAY RELIEVE THE CONTRACTORS RESPONSIBILITY FOR CONDUCTING A STORE SPECIFIC SITE VISIT, COLLECTING ALL NECESSARY AS-BUILT INFORMATION, AND VERIFYING ALL ELEMENTS SHOWN AS FEASIBLE AS THEY PERTAIN TO THE PROPOSED DESIGN.

NOTE: EXISTING CONDITIONS ARE SHOWN IN BLACK OR GRAY. NEW / PROPOSED ELEMENTS ARE SHOWN IN RED.



7-ELEVEN  
REMDEL

DISCLAIMER:  
THIS IS NOT A LEGAL  
DOCUMENT. INTENT TO  
SHOW CURRENT  
EQUIPMENT CONDITIONS

REVISIONS		
REV#	DATE	DESCRIPTION

7-ELEVEN

35851  
2216 UNIVERSITY AVENUE  
MADISON, WISCONSIN  
53726

DRAWN BY:  
FJ

SCALE:  
1/8" = 1'-0"


DATE:  
05-11-24

SHEET:  
A - 1.0

7-ELEVEN


DRAWING #  
35851 - 7-ELEVEN

PROPOSED - FLOOR PLAN

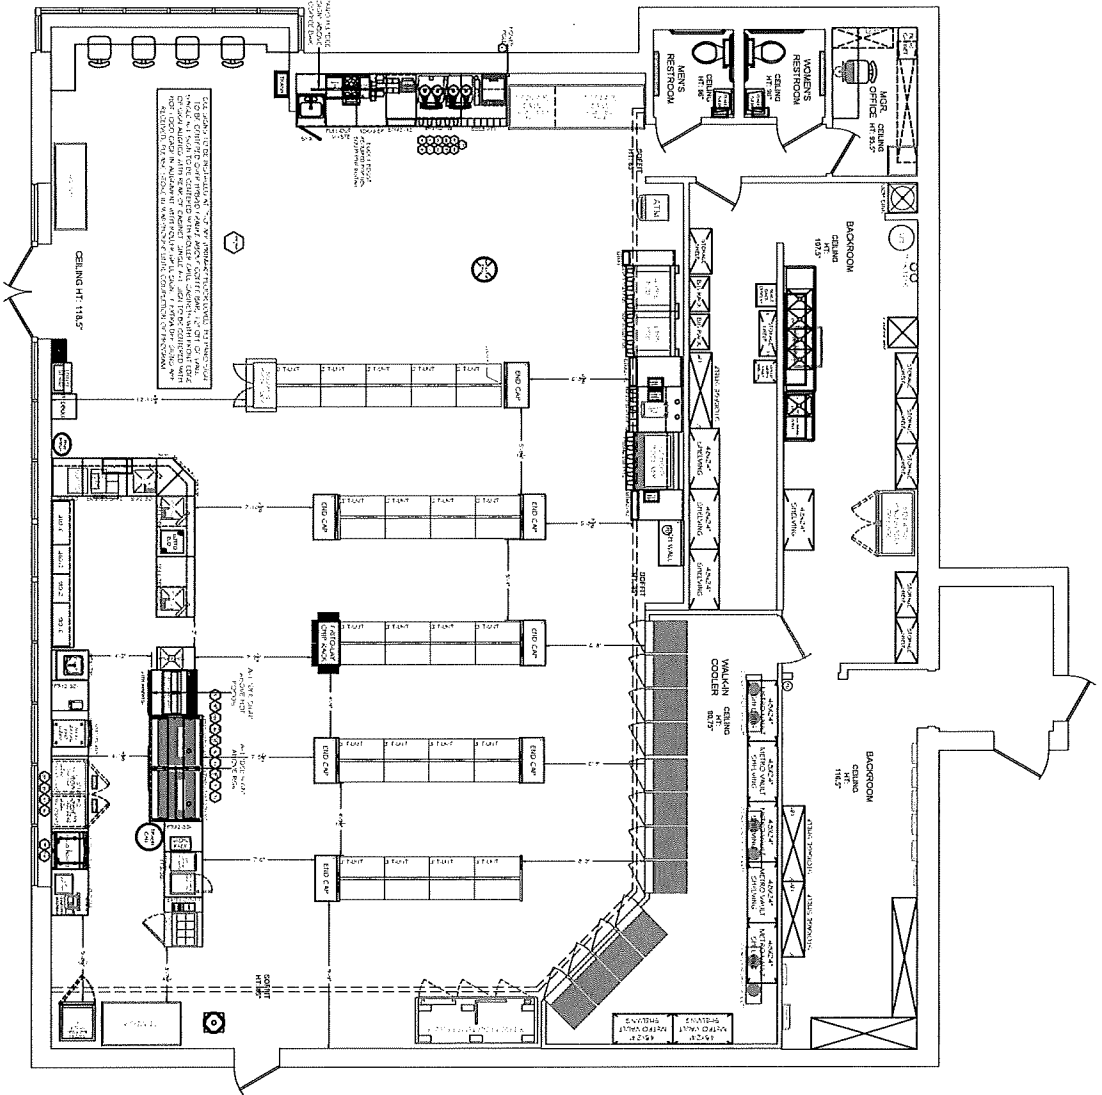

DISCLAIMER: THIS DRAWING AND ALL SUPPORTING DOCUMENTS CONTAINED IN THE "DRAWING PACKAGE" ARE THE PROPERTY OF ROYSTON GROUP, FIELD SERVICES DIVISION. ANY USE OF THE DRAWING FILE OR ANY OF THE INFORMATION FOUND WITHIN FOR ANY PURPOSE OUTSIDE OF DIRECT REQUEST BY ROYSTON GROUP WILL BE SEEN AS A VIOLATION OF THE WORK AGREEMENT AND WILL BE PURSUED TO THE FULLEST EXTENT ALLOWABLE. THE DRAWINGS AND EQUIPMENT LISTS ARE INTENDED TO REPRESENT THE GENERALIZED CHARACTERISTICS OF THE SCOPE OF WORK, BUT IN NO WAY RELIEVE THE CONTRACTORS RESPONSIBILITY FOR CONDUCTING A STORE SPECIFIC SITE VISIT, COLLECTING ALL NECESSARY AS-BUILT INFORMATION, AND VERIFYING ALL ELEMENTS SHOWN AS FEASIBLE AS THEY PERTAIN TO THE PROPOSED DESIGN.

NOTE: EXISTING CONDITIONS ARE SHOWN IN BLACK OR GRAY. NEW / PROPOSED ELEMENTS ARE SHOWN IN RED.



7-ELEVEN  
REMODEL

DISCLAIMER:  
THIS IS NOT A LEGAL  
DOCUMENT. INTENT TO  
SHOW CURRENT  
EQUIPMENT CONDITIONS

7-ELEVEN		
REVISIONS		
REV#	DATE	DESCRIPTION
2-KLD	5/14/24	INITIAL PROPOSAL
3-NRR	6/13/24	SCOPE WALK

35851  
2216 UNIVERSITY AVENUE  
MADISON, WISCONSIN  
53726

7-ELEVEN

DRAWING #  
35851 - 7-ELEVEN






DRAWN BY:  
FJ

SCALE:  
1/8" = 1'-0"

DATE:  
05-11-24

SHEET:  
A - 2.0

REMOVED ITEMS

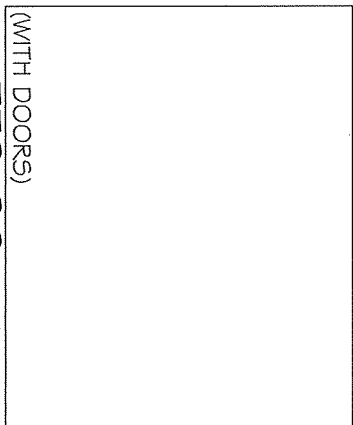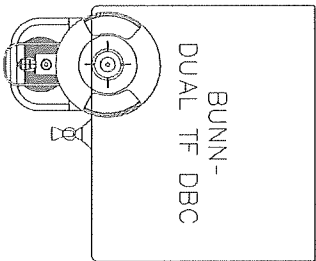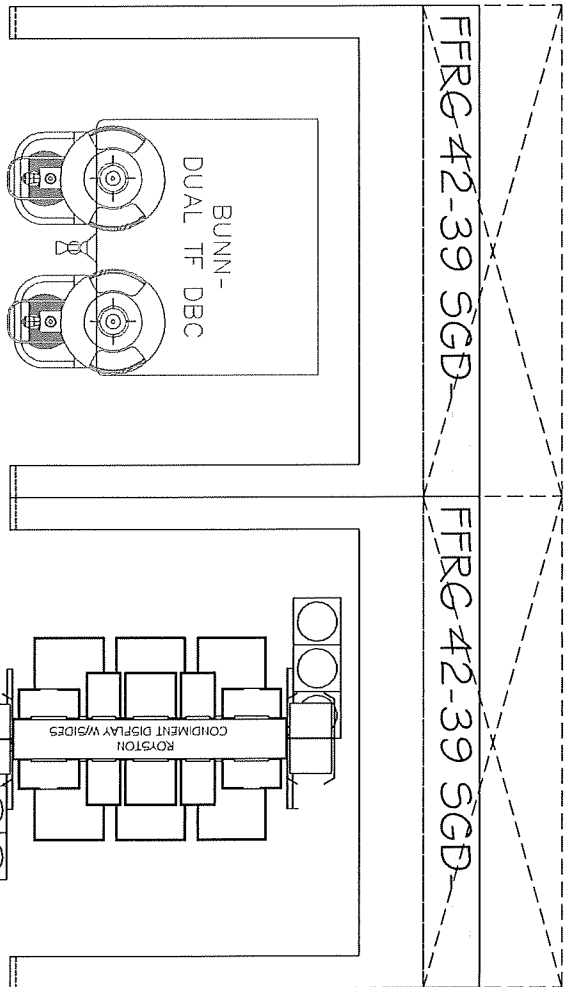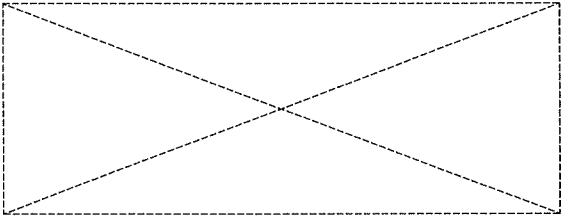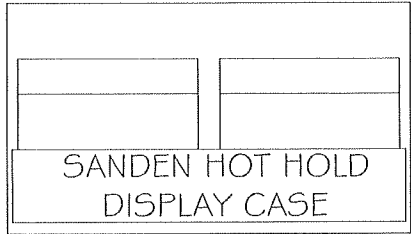

ASK  
STORE IF  
THEY  
WANT TO  
KEEP  
STORAGE  
CABINET

DISCLAIMER: THIS DRAWING AND ALL SUPPORTING DOCUMENTS CONTAINED IN THE 'DRAWING PACKAGE' ARE THE PROPERTY OF ROYSTON GROUP, FIELD SERVICES DIVISION. ANY USE OF THE DRAWING FILE OR ANY OF THE INFORMATION FOUND WITHIN FOR ANY PURPOSE OUTSIDE OF DIRECT REQUEST BY ROYSTON GROUP WILL BE SEEN AS A VIOLATION OF THE WORK AGREEMENT AND WILL BE PURSUED TO THE FULLEST EXTENT ALLOWABLE. THE DRAWINGS AND EQUIPMENT LISTS ARE INTENDED TO REPRESENT THE GENERALIZED CHARACTERISTICS OF THE SCOPE OF WORK BUT IN NO WAY RELIEVE THE CONTRACTORS RESPONSIBILITY FOR CONDUCTING A STORE SPECIFIC SITE VISIT, COLLECTING ALL NECESSARY AS-BUILT INFORMATION, AND VERIFYING ALL ELEMENTS SHOWN AS FEASIBLE AS THEY PERTAIN TO THE PROPOSED DESIGN.

NOTE: EXISTING CONDITIONS ARE SHOWN IN BLACK OR GRAY. NEW / PROPOSED ELEMENTS ARE SHOWN IN RED.



7-ELEVEN  
REMDEL

DISCLAIMER:  
THIS IS NOT A LEGAL  
DOCUMENT. INTENT TO  
SHOW CURRENT  
EQUIPMENT CONDITIONS

REVISIONS

REV#	DATE	DESCRIPTION

7-ELEVEN

35851  
2216 UNIVERSITY AVENUE  
MADISON, WISCONSIN  
53726

DRAWN BY: FJ

SCALE: NTS

DATE: 05-11-24

SHEET: 1

R. 1, - 1.0

7-ELEVEN

DRAWING # 35851 - 7-ELEVEN