




STRANG


ARCHITECTURE
ENGINEERING
INTERIOR DESIGN

STRANG, INC.
6411 MINERAL POINT ROAD
MADISON, WI 53705-4395

REVISIONS		
No.	DESCRIPTION	DATE
1	ADDENDUM 01	05-30-2017
2	SI-C01	06-28-2017

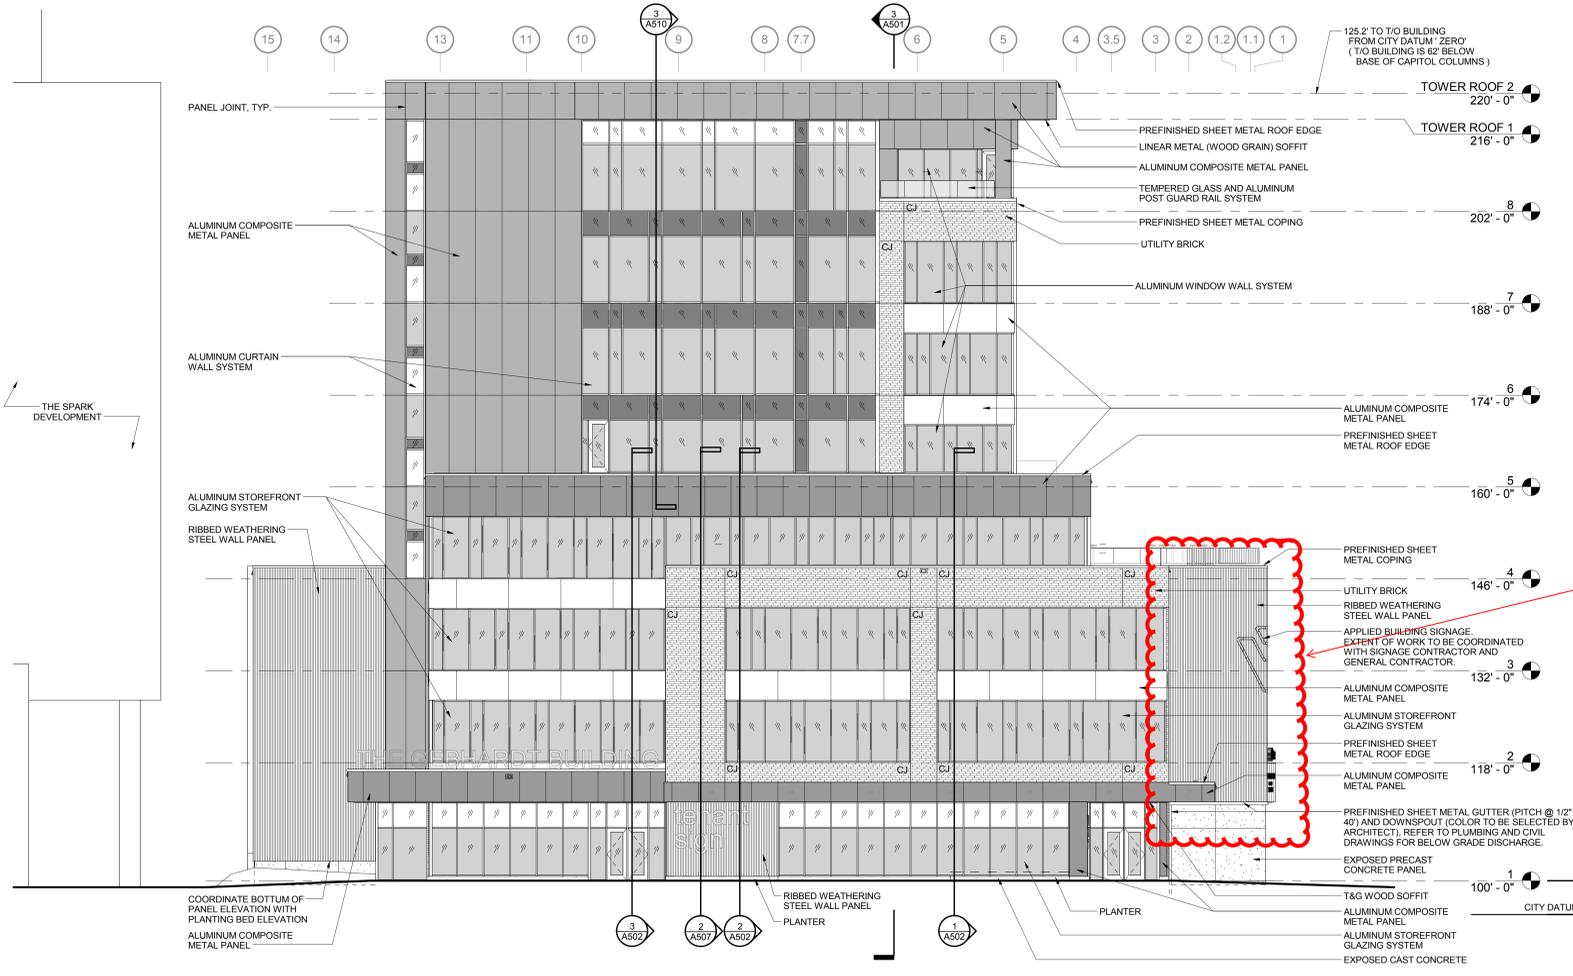


1 E. WASHINGTON AVE. (WEST) ELEVATION
SCALE: 3/32" = 1'-0"

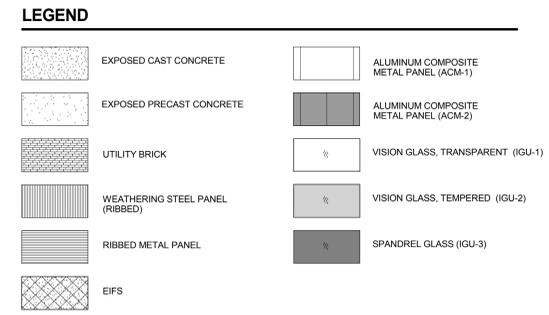

- GENERAL EXTERIOR ELEVATION NOTES**
- REFER TO WALL SECTIONS AND SPECIFICATION FOR ADDITIONAL EXTERIOR MATERIALS INFORMATION.
 - APPROXIMATE LOCATIONS OF SIGNAGE AND CUSTOM PERFORATED WEATHERING STEEL ARE SHOWN. LOCATIONS PENDING CITY APPROVAL.
 - SIGNAGE PROVIDED BY OWNER'S SIGNAGE CONSULTANT, N.I.C. APPROXIMATE LOCATIONS SHOWN FOR GENERAL COORDINATION OF ELECTRICAL WORK PROVIDED BY E.C.
 - SHEET METAL COLORS FOR COPINGS, FLASHINGS, DOWNSPOUTS AND GUTTERS TO BE SELECTED BY ARCHITECT.

UDC APPROVED 3/8/17:
DETAIL OF ARCHITECTURAL FEATURE

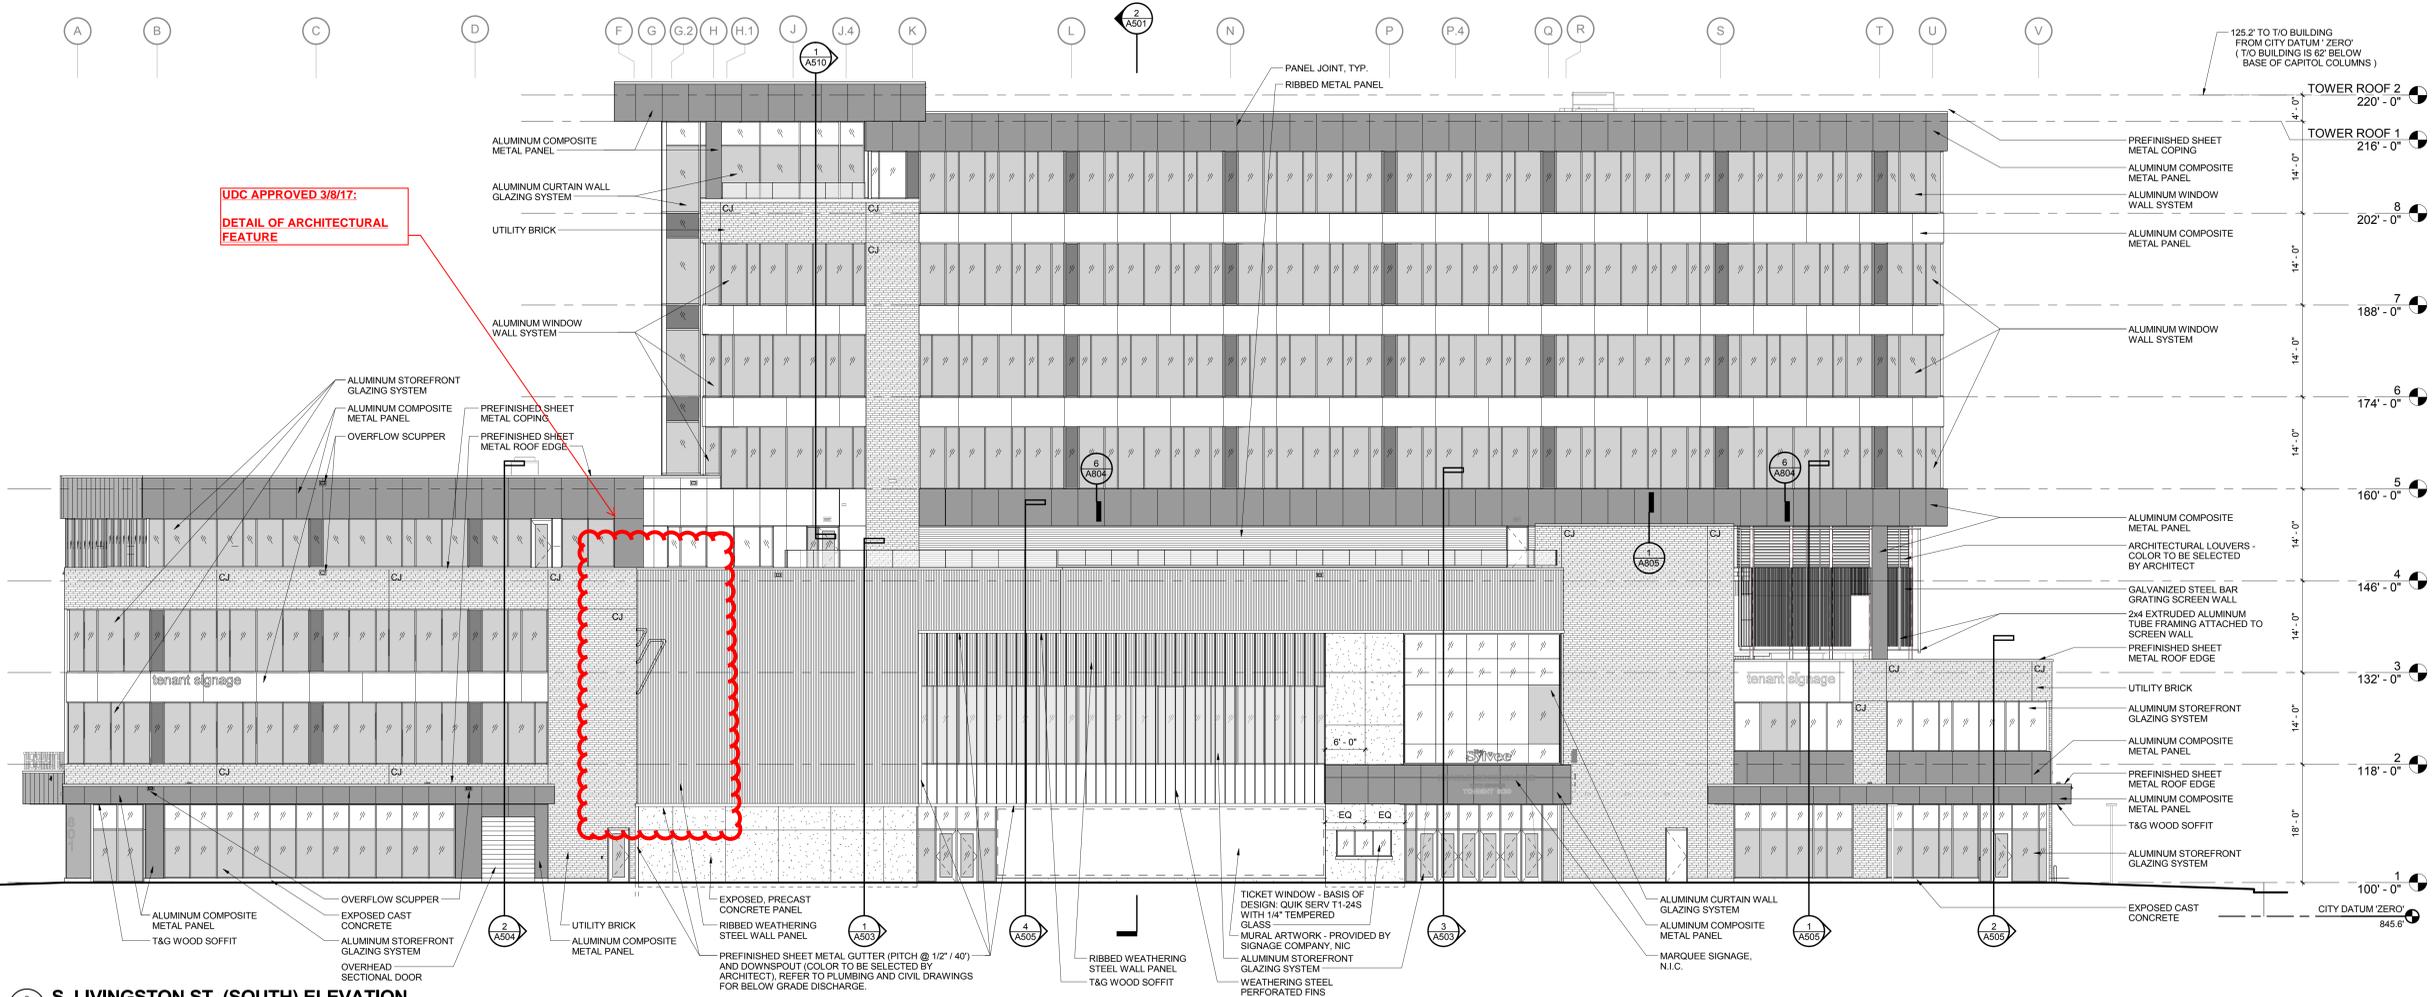

2 S. LIVINGSTON ST. (SOUTH) ELEVATION
SCALE: 3/32" = 1'-0"

COPYRIGHT STRANG, INC.	2017
DRAWING SET	SITE PLAN REVIEW
DRAWN	JZ
CHECKED	JC
DATE	07-07-2017
PROJECT NO.	2016090
PROJECT TITLE	
GEBHARDT DEVELOPMENT - THE COSMOS PROJECT	
811 E. WASHINGTON AVENUE MADISON, WISCONSIN 53703	

SHEET NAME
EXTERIOR ELEVATIONS

SHEET NO.
A401



STRANG

**ARCHITECTURE
ENGINEERING
INTERIOR DESIGN**

STRANG, INC.
6411 MINERAL POINT ROAD
MADISON, WI 53705-4395



UDC APPROVED 3/8/17:
DETAIL OF ARCHITECTURAL FEATURE

**OWNER REVIEW
SET**

**NOT FOR
CONSTRUCTION**

COPYRIGHT STRANG, INC.	2017
DRAWING SET	SITE PLAN REVIEW
DRAWN	JZ
CHECKED	JC
DATE	07-07-2017
PROJECT NO.	2016090

PROJECT TITLE

**GEBHARDT
DEVELOPMENT -
THE COSMOS
PROJECT**

811 E. WASHINGTON AVENUE
MADISON, WISCONSIN 53703

SHEET NAME


**EXTERIOR
RENDERING**

SHEET NO.

A901

EXTERIOR RENDERING (VIEW LOOKING EAST)

UDC APPROVED 3/8/17:
DETAIL OF ARCHITECTURAL FEATURE

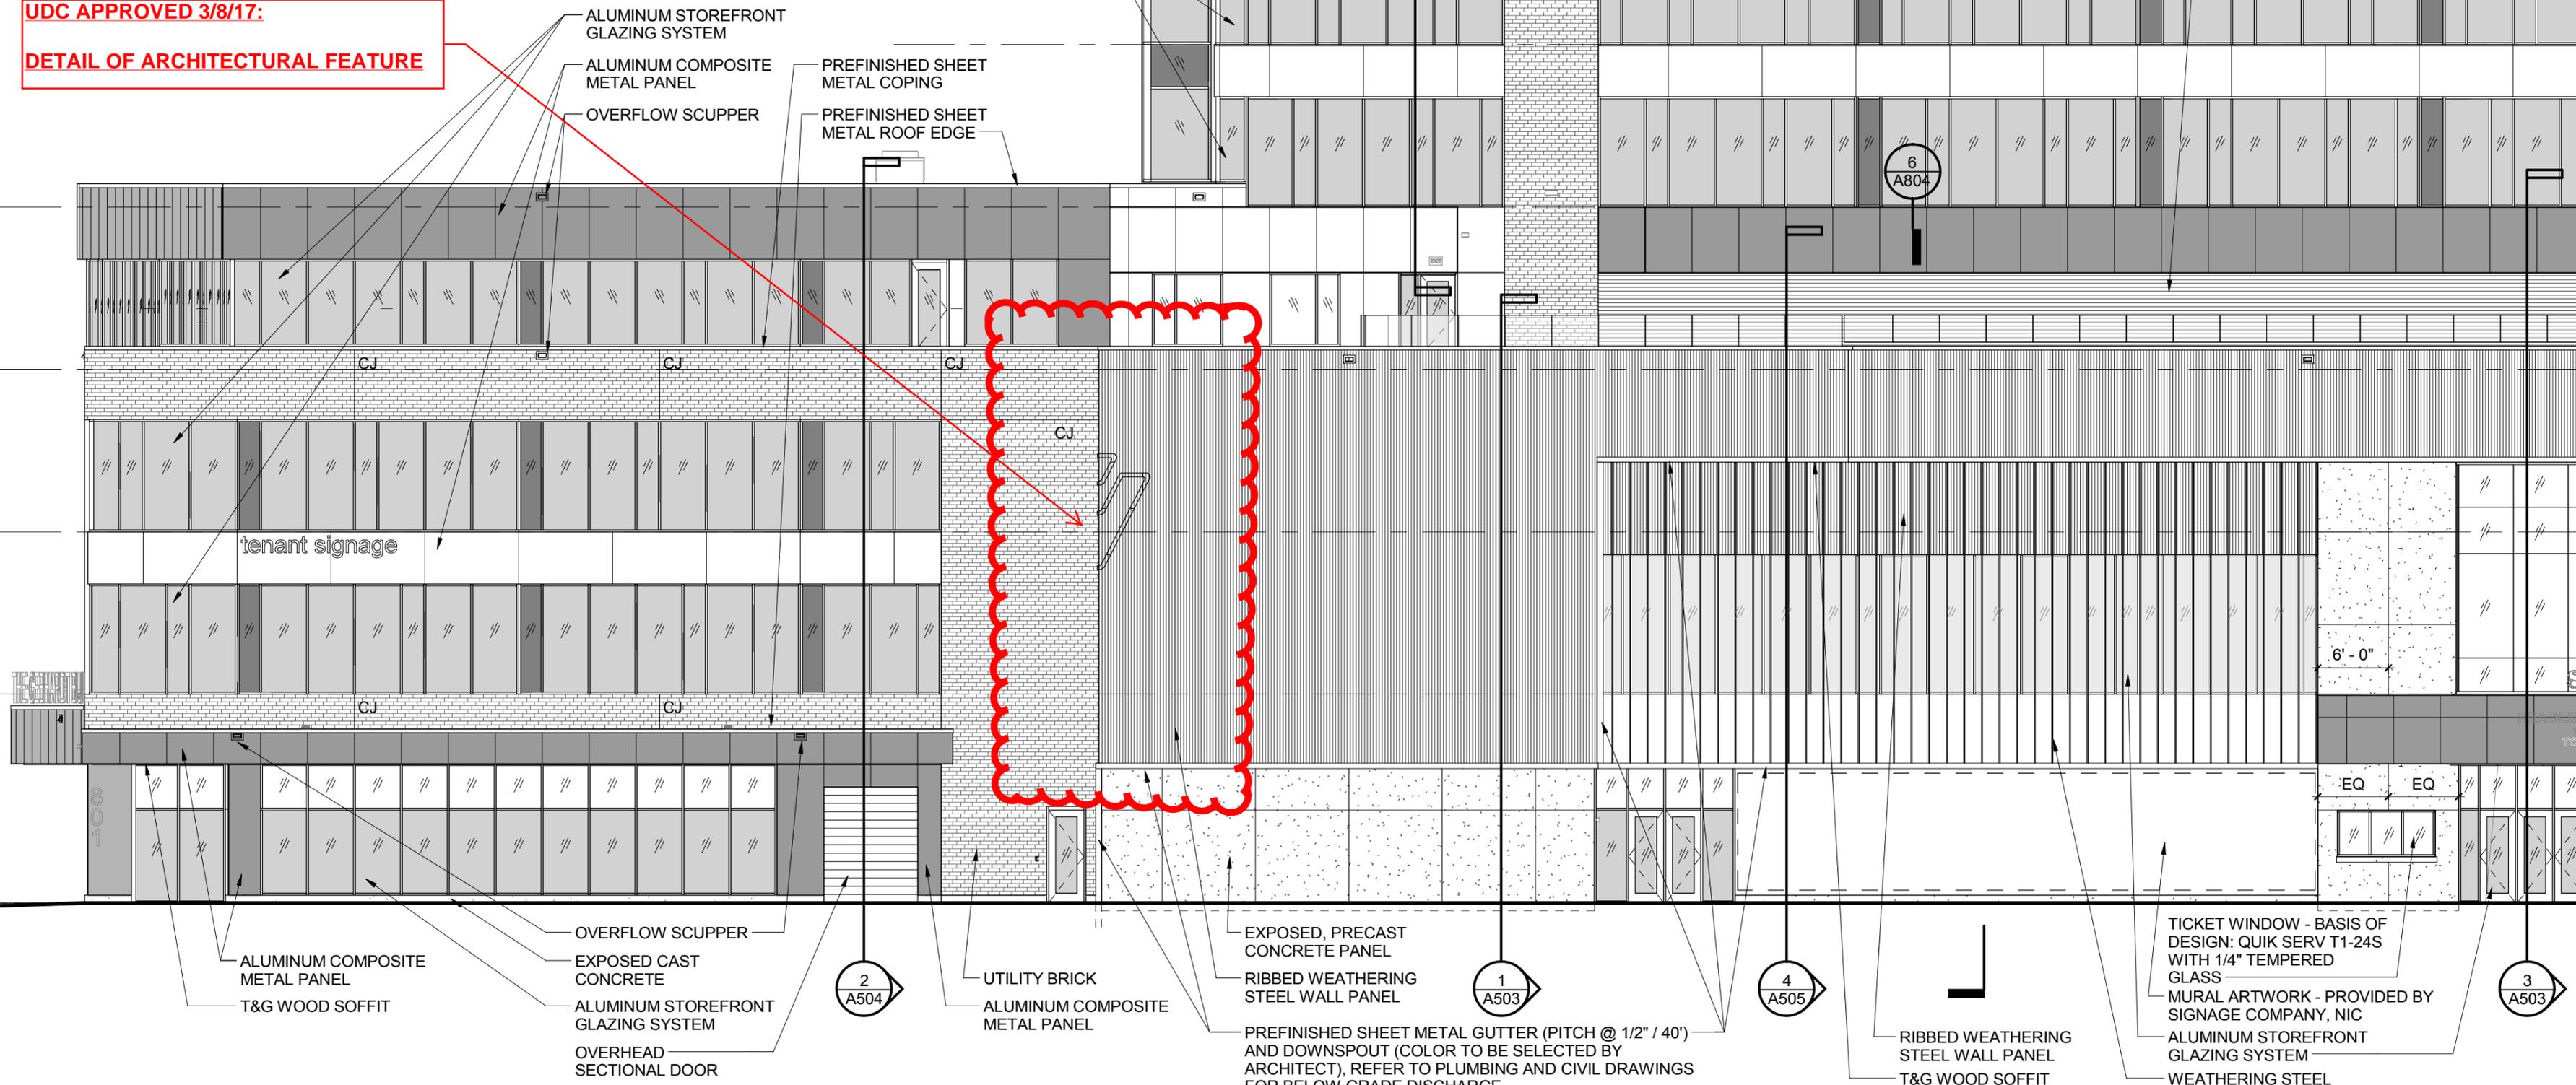

2
A401

S. LIVINGSTON ST. (SOUTH) ELEVATION

SCALE: 3/32" = 1'-0"

- OVERFLOW SCUPPER
- EXPOSED CAST CONCRETE
- ALUMINUM STOREFRONT GLAZING SYSTEM
- OVERHEAD SECTIONAL DOOR

2
A504

- UTILITY BRICK
- ALUMINUM COMPOSITE METAL PANEL

- EXPOSED, PRECAST CONCRETE PANEL
- RIBBED WEATHERING STEEL WALL PANEL
- PREFINISHED SHEET METAL GUTTER (PITCH @ 1/2" / 40') AND DOWNSPOUT (COLOR TO BE SELECTED BY ARCHITECT), REFER TO PLUMBING AND CIVIL DRAWINGS FOR BELOW GRADE DISCHARGE.


1
A503

4
A505

- RIBBED WEATHERING STEEL WALL PANEL
- T&G WOOD SOFFIT

- TICKET WINDOW - BASIS OF DESIGN: QUIK SERV T1-24S WITH 1/4" TEMPERED GLASS
- MURAL ARTWORK - PROVIDED BY SIGNAGE COMPANY, NIC
- ALUMINUM STOREFRONT GLAZING SYSTEM
- WEATHERING STEEL PERFORATED FINIS

3
A503

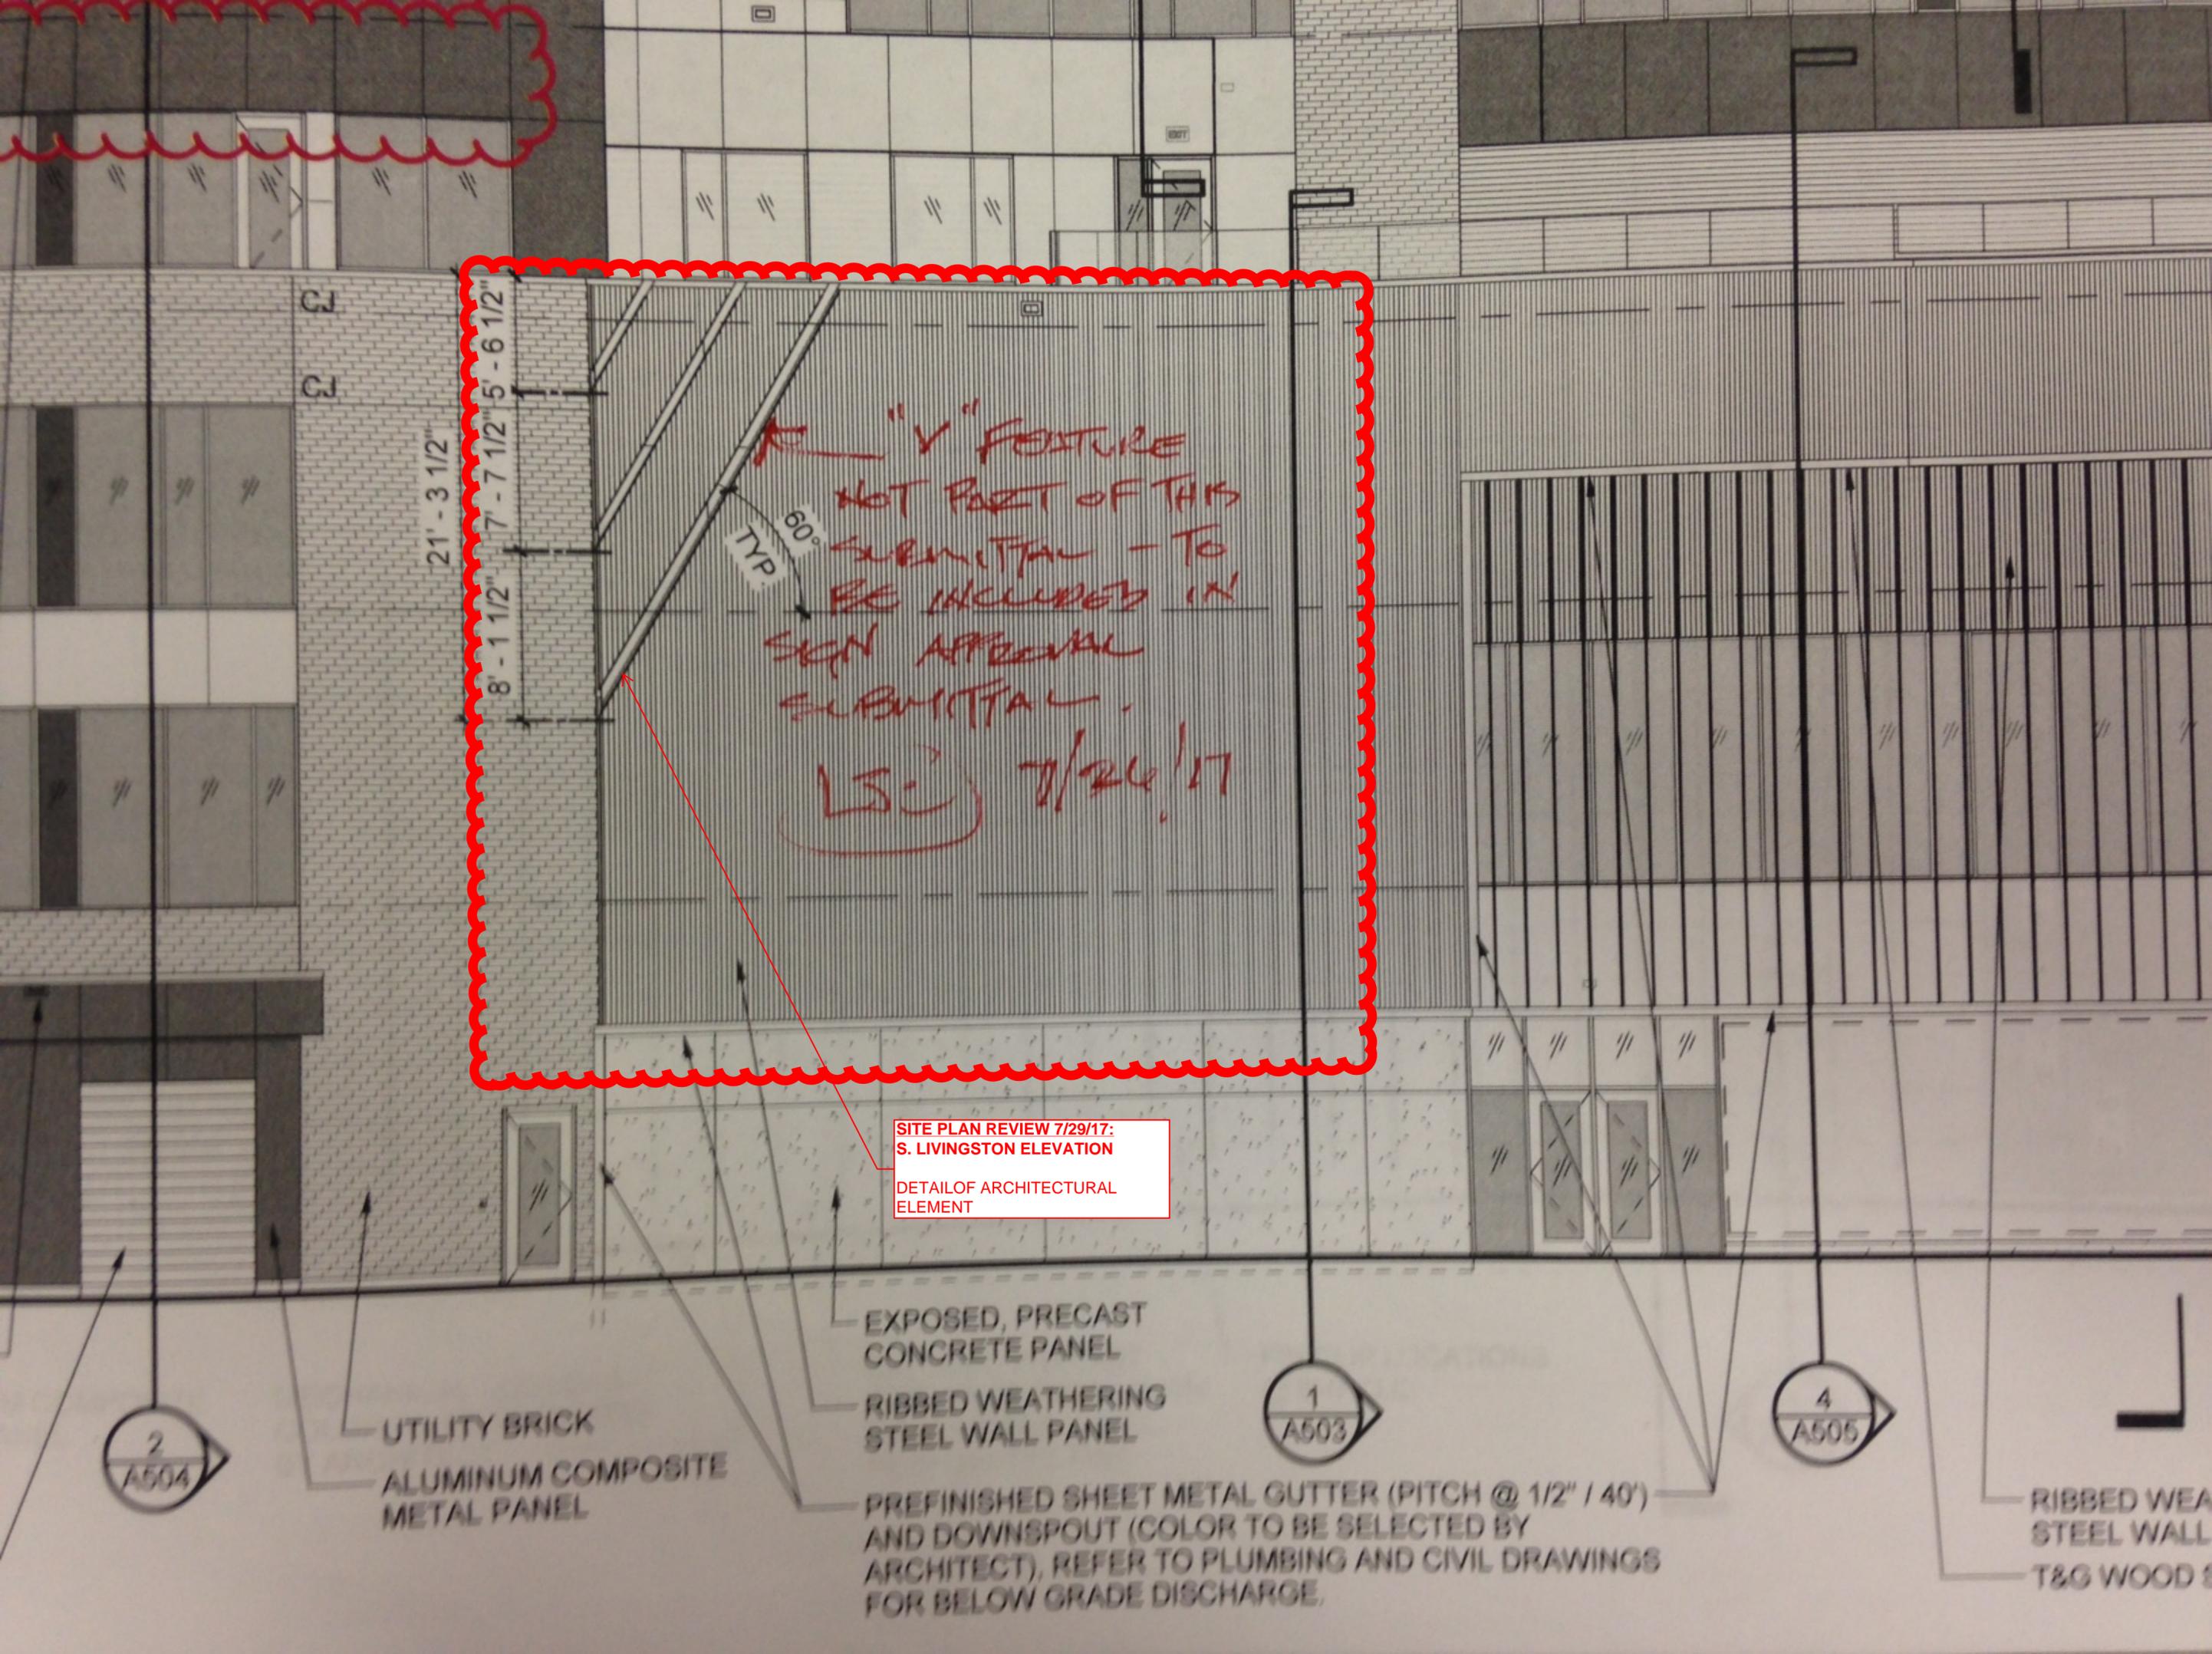

21' - 3 1/2"

8' - 1 1/2" 7' - 7 1/2" 5' - 6 1/2"

"V" FEATURE
NOT PART OF THIS
SUBMITTAL - TO
BE INCLUDED IN
SIGN APPROVAL
SUBMITTAL.
LS: 7/26/17

60°
TYP

SITE PLAN REVIEW 7/29/17:
S. LIVINGSTON ELEVATION
DETAIL OF ARCHITECTURAL
ELEMENT

2
A504

UTILITY BRICK
ALUMINUM COMPOSITE
METAL PANEL

EXPOSED, PRECAST
CONCRETE PANEL
RIBBED WEATHERING
STEEL WALL PANEL

1
A503

PREFINISHED SHEET METAL GUTTER (PITCH @ 1/2" / 40')
AND DOWNSPOUT (COLOR TO BE SELECTED BY
ARCHITECT), REFER TO PLUMBING AND CIVIL DRAWINGS
FOR BELOW GRADE DISCHARGE.

4
A505

RIBBED WEA
STEEL WALL
T&G WOOD S

GLAZING SYSTEM

RIBBED WEATHERING STEEL WALL PANEL

COORDINATE BOTTOM OF PANEL ELEVATION WITH PLANTING BED ELEVATION
ALUMINUM COMPOSITE METAL PANEL

THE GEBHARDT BUILDING

tenant sign

RIBBED WEATHERING STEEL WALL PANEL
PLANTER

PLANTER

PREFINISHED SHEET METAL COPING

UTILITY BRICK

RIBBED WEATHERING STEEL WALL PANEL

APPLIED BUILDING SIGNAGE. EXTENT OF WORK TO BE COORDINATED WITH SIGNAGE CONTRACTOR AND GENERAL CONTRACTOR.

ALUMINUM COMPOSITE METAL PANEL

ALUMINUM STOREFRONT GLAZING SYSTEM

PREFINISHED SHEET METAL ROOF EDGE

ALUMINUM COMPOSITE METAL PANEL

PREFINISHED SHEET METAL GUTTER (PITCH @ 1/2" 40') AND DOWNSPOUT (COLOR TO BE SELECTED BY ARCHITECT), REFER TO PLUMBING AND CIVIL DRAWINGS FOR BELOW GRADE DISCHARGE.

EXPOSED PRECAST CONCRETE PANEL

T&G WOOD SOFFIT

ALUMINUM COMPOSITE METAL PANEL

ALUMINUM STOREFRONT GLAZING SYSTEM

EXPOSED CAST CONCRETE

4
146' - 0"

3
132' - 0"

2
118' - 0"

1
100' - 0"

CITY DAT

UDC APPROVED 3/8/17:
DETAIL OF ARCHITECTURAL FEATURE

1
A401

E. WASHINGTON AVE. (WEST) ELEVATION

SCALE: 3/32" = 1'-0"


3
A502

2
A507

2
A502

1
A502

2

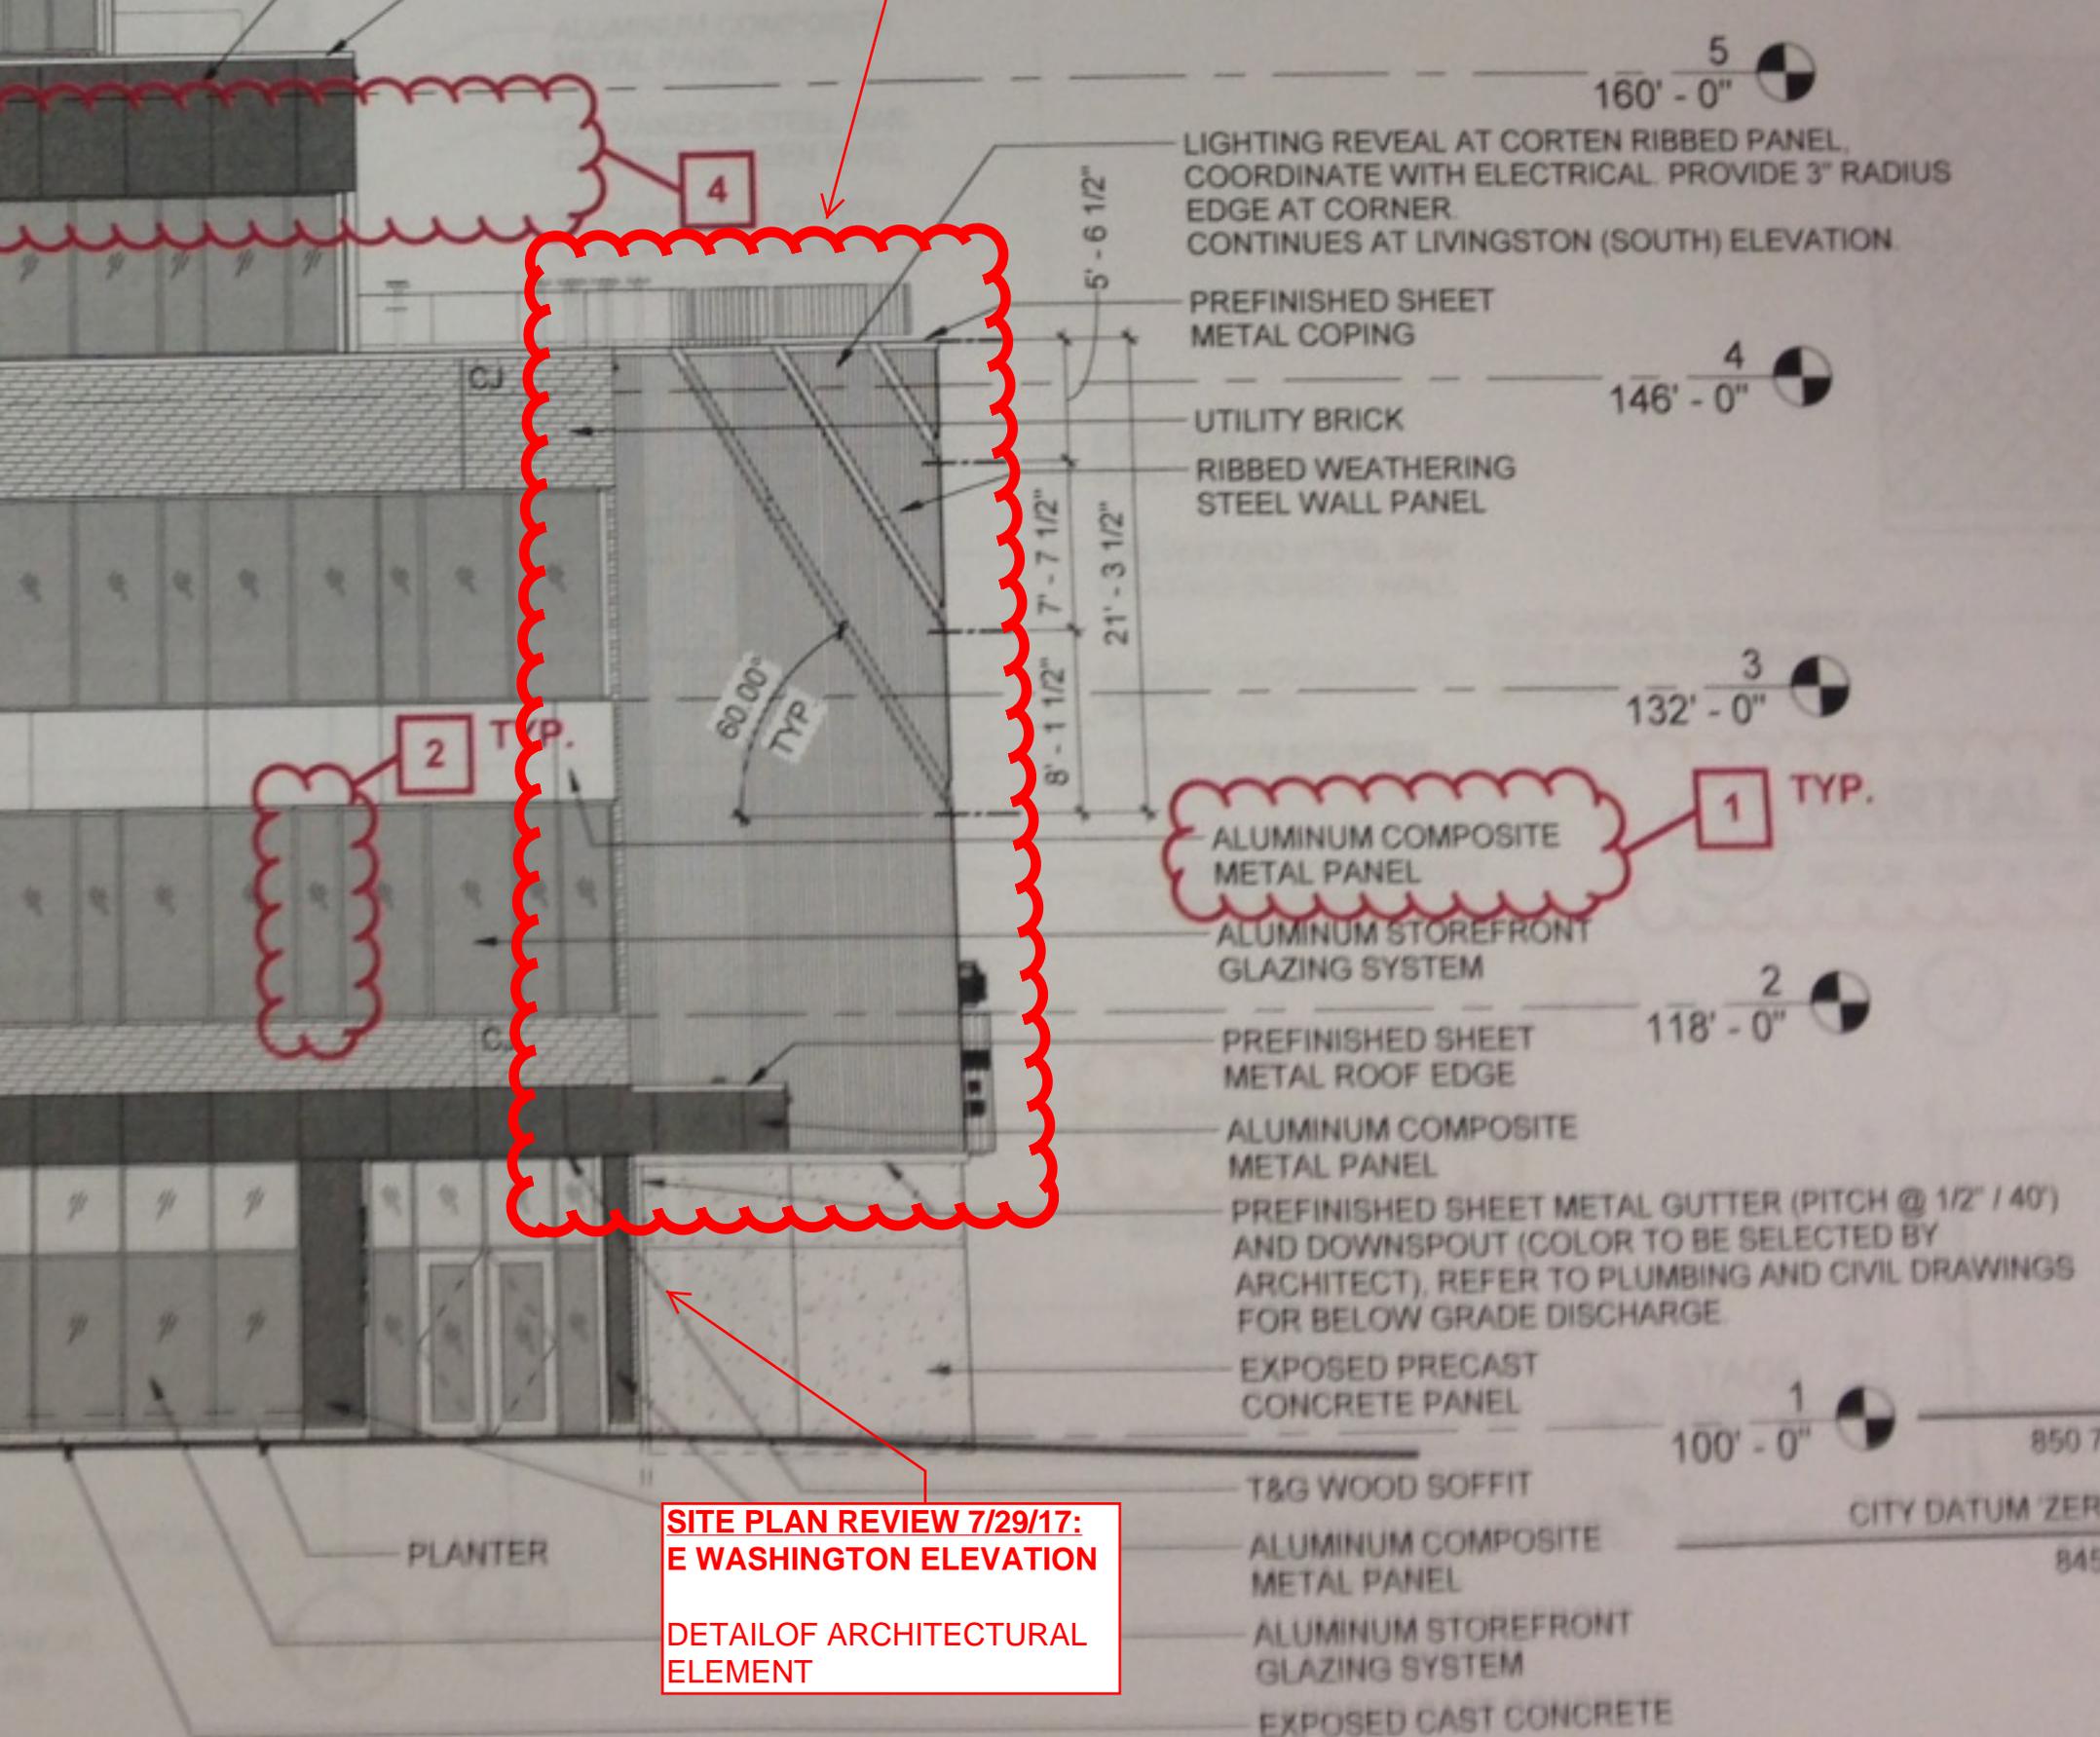

160' - 0" 

LIGHTING REVEAL AT CORTEN RIBBED PANEL, COORDINATE WITH ELECTRICAL. PROVIDE 3" RADIUS EDGE AT CORNER. CONTINUES AT LIVINGSTON (SOUTH) ELEVATION.

PREFINISHED SHEET METAL COPING

146' - 0" 

UTILITY BRICK
RIBBED WEATHERING STEEL WALL PANEL

132' - 0" 

ALUMINUM COMPOSITE METAL PANEL
ALUMINUM STOREFRONT GLAZING SYSTEM

118' - 0" 

PREFINISHED SHEET METAL ROOF EDGE

ALUMINUM COMPOSITE METAL PANEL

PREFINISHED SHEET METAL GUTTER (PITCH @ 1/2" / 40') AND DOWNSPOUT (COLOR TO BE SELECTED BY ARCHITECT), REFER TO PLUMBING AND CIVIL DRAWINGS FOR BELOW GRADE DISCHARGE.

EXPOSED PRECAST CONCRETE PANEL

100' - 0" 

T&G WOOD SOFFIT

ALUMINUM COMPOSITE METAL PANEL

ALUMINUM STOREFRONT GLAZING SYSTEM

EXPOSED CAST CONCRETE

CITY DATUM ZER

850 7

845

**SITE PLAN REVIEW 7/29/17:
E WASHINGTON ELEVATION
DETAIL OF ARCHITECTURAL
ELEMENT**

PLANTER

2 TYP.

1 TYP.

60.00°
TYP.

5' - 6 1/2"

7' - 7 1/2"

8' - 1 1/2"

21' - 3 1/2"