


EXHIBIT B

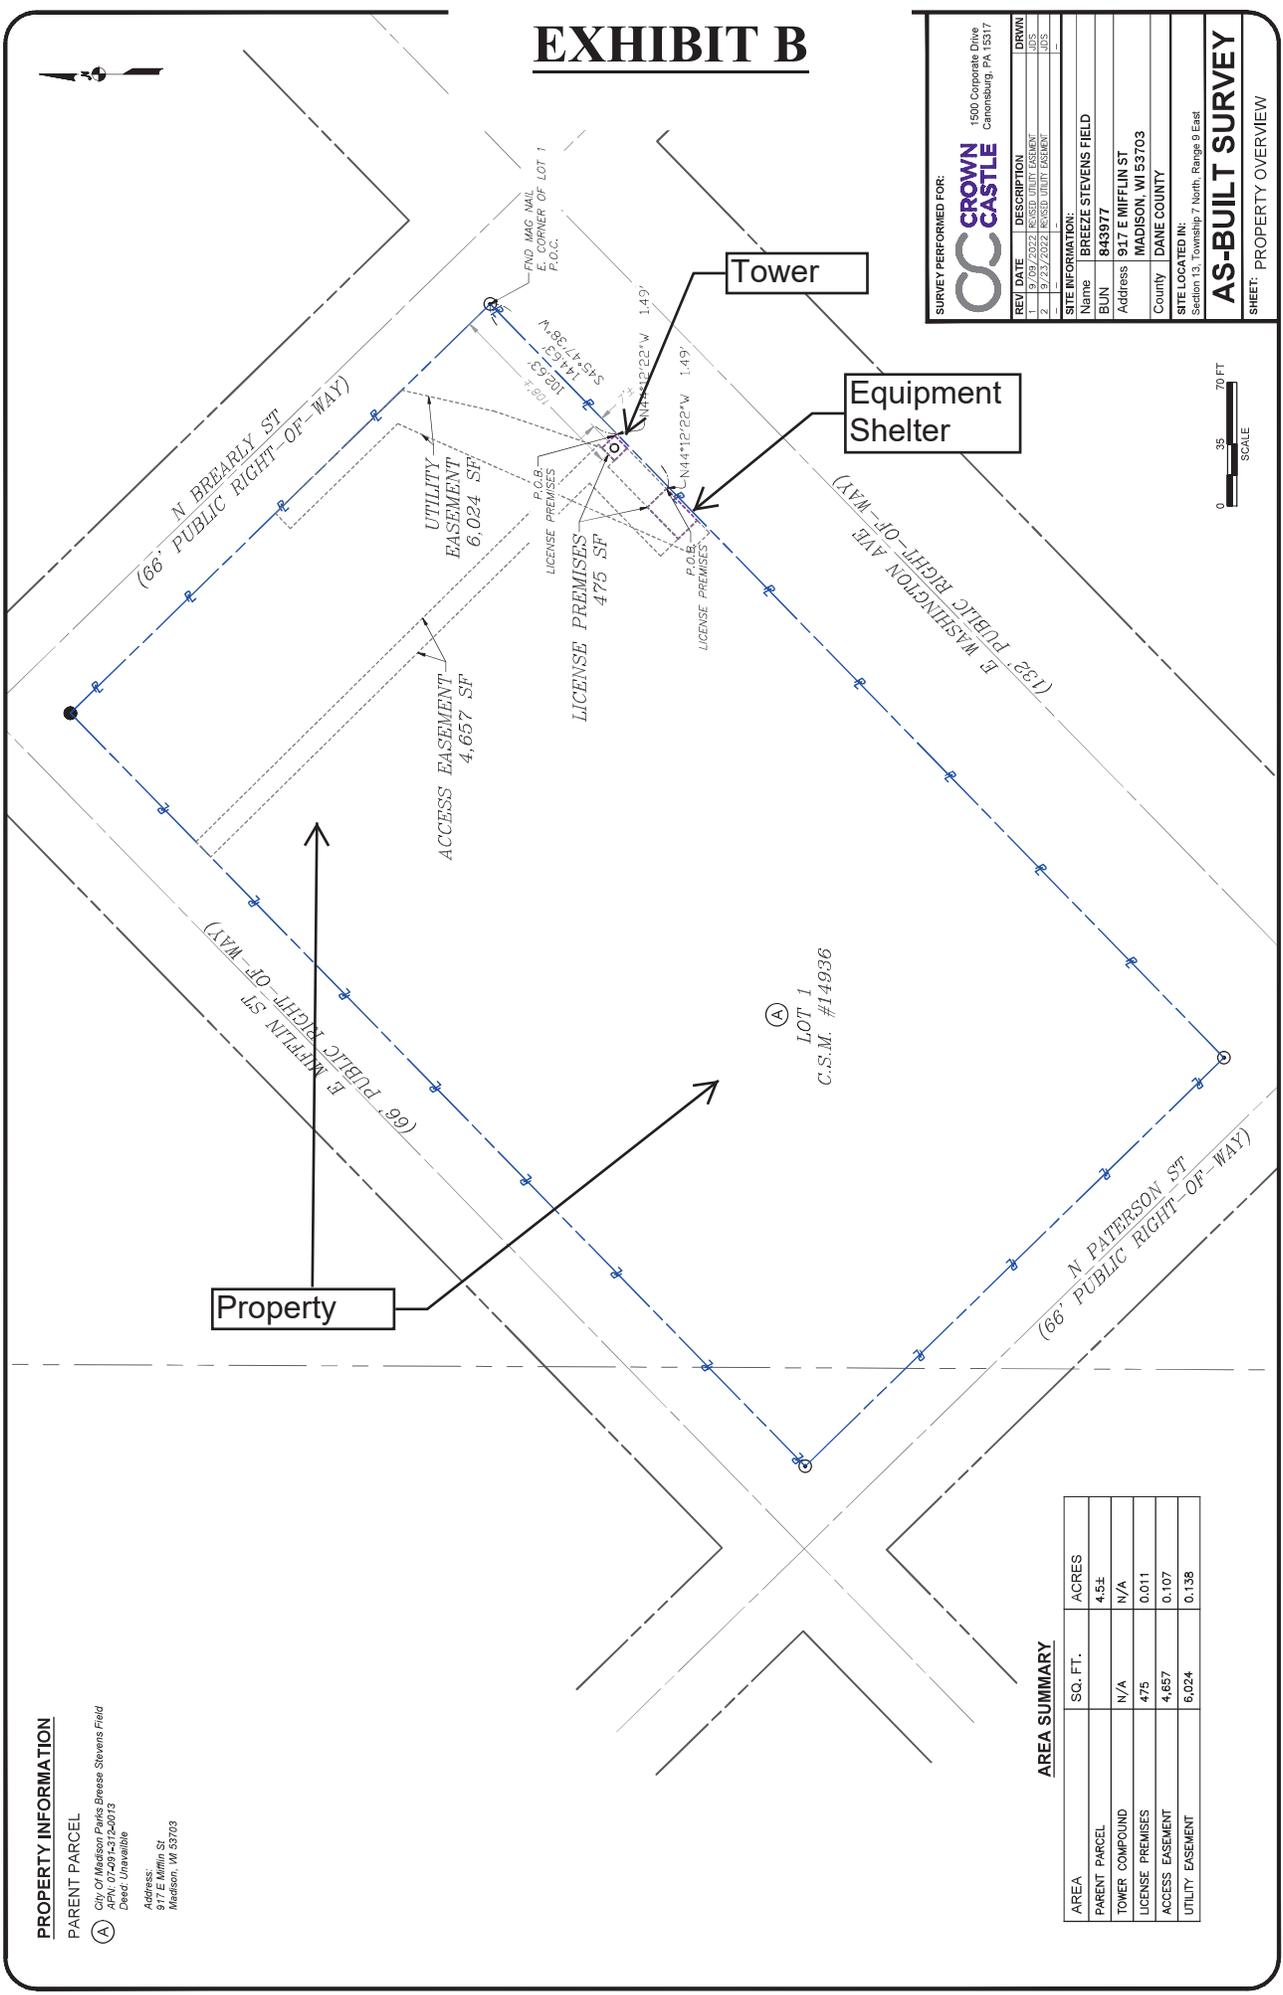

SURVEY PERFORMED FOR:

CROWN CASTLE
1500 Corporate Drive
Canonsburg, PA 15317

REV	DATE	DESCRIPTION	DRWN
1	9/09/2022	REISED UTILITY EASEMENT	JDS
2	9/23/2022	REISED UTILITY EASEMENT	JDS

SITE INFORMATION:

Name: BREEZE STEVENS FIELD
 BUJN: 843977
 Address: 917 E MIFFLIN ST
 County: MADISON, WI 53703
 DANE COUNTY

SITE LOCATED IN:
 Section 13, Township 7 North, Range 9 East

AS-BUILT SURVEY
 SHEET: PROPERTY OVERVIEW



PROPERTY INFORMATION

PARENT PARCEL
 City of Madison Parks Breeze Stevens Field
 APN: 07-209-1-312-0013
 Deed: Unavailable
 Address:
 917 E Miffin St
 Madison, WI 53703

AREA SUMMARY

AREA	SQ. FT.	ACRES
PARENT PARCEL		4.64
TOWER COMPOUND	N/A	N/A
LICENSE PREMISES	475	0.011
ACCESS EASEMENT	4,657	0.107
UTILITY EASEMENT	6,024	0.138

Property

Tower

Equipment Shelter

(A)
 LOT 1
 C.S.M. #14936