


SCALE: 1" = 10'-0"

PARKING FACILITY APPROVAL	
Address:	2405 S 770
Customer Name:	7700 Madison
Site:	40-274
Truck Register:	1/23/24
City Engineer:	1/23/24
Inspector:	1/23/24
Drawn By:	1/23/24
Scale:	1" = 10'-0"

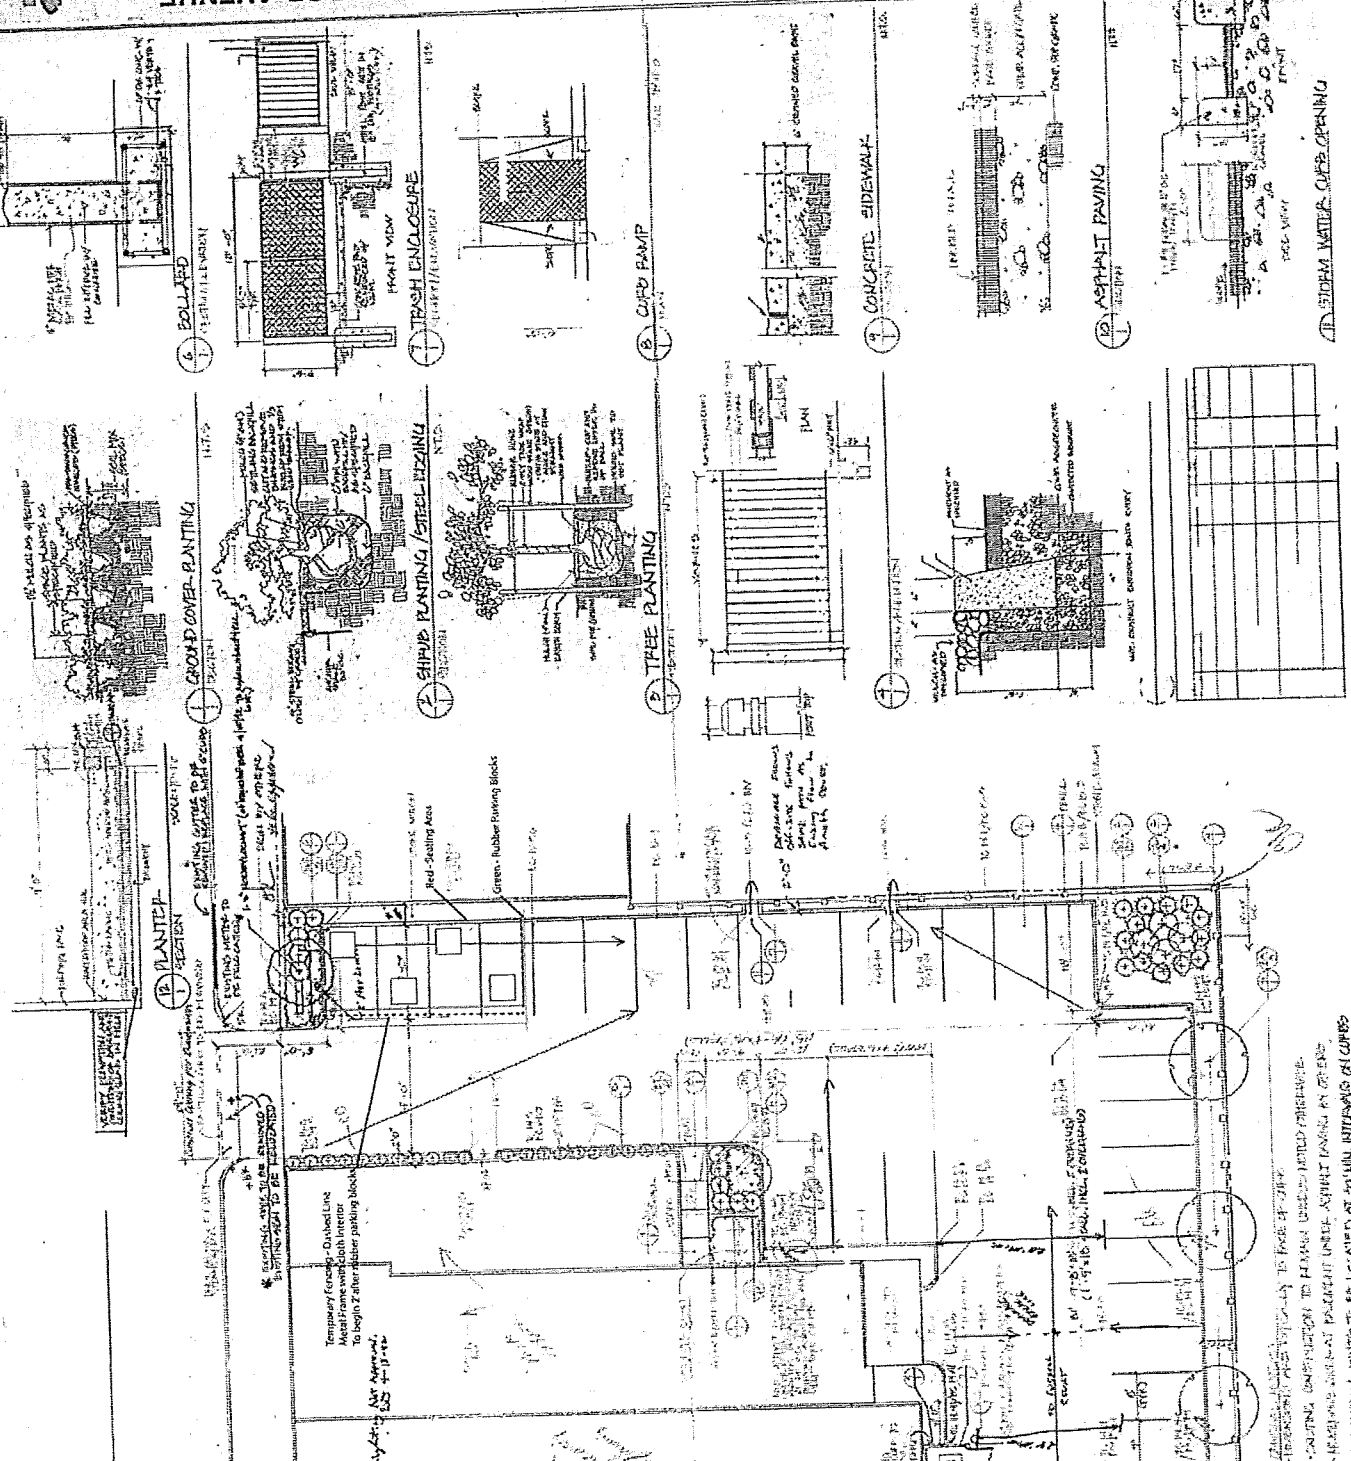

ATWOOD AVENUE
PARKING AREA
DEVELOPMENT PLAN

MADISON, WI

CONSULT: MADISON ARCHITECT
1000 UNIVERSITY AVENUE
MADISON, WI 53706

AFI
WATER UTILITIES MANAGER
FIRE MARSHALL
PLAN COMMISSION

RATO

SITE DEVELOPMENT
PLAN

BIOMIMETIC WATER OVER-OPENING

BIOMIMETIC WATER OVER-OPENING IS MADE OF STEEL
FRAMING CONSTRUCTION TO ALLOW WEATHER-RELATED PERFORMANCE.
FRAMING CONSTRUCTION TO ALLOW WEATHER-RELATED PERFORMANCE.
FRAMING CONSTRUCTION TO ALLOW WEATHER-RELATED PERFORMANCE.
FRAMING CONSTRUCTION TO ALLOW WEATHER-RELATED PERFORMANCE.

RUSSELL
LAFIT



Caitlin Suemnicht <caitlin.suemnicht@gmail.com>

Fwd: 2009 Atwood AVE and LNDSPR-2020-00075

Caitlin Suemnicht <csuemnicht@foodfightinc.com>
To: Caitlin Suemnicht <csuemnicht@foodfightinc.com>

Mon, Jul 6, 2020 at 11:27 AM

From: noreply@cityofmadison.com <noreply@cityofmadison.com>
Sent: Wednesday, July 1, 2020 4:45:32 PM
To: Krys Wachowiak <krys@foodfightinc.com>
Subject: 2009 Atwood AVE and LNDSPR-2020-00075

Notice of Site Plan Review approval:

Your project has been reviewed and approved by City staff. The approved plans are available to pick up at the Zoning counter. If your project requires permits, Zoning staff may be able to sign-off on permits at this time. Plans must be picked up from the Zoning counter within 6 months of approval.

To: Krys Wachowiak

From: Mark Jorgensen

Subject: Parking Lot Use, 2009 Atwood Avenue

Date: June 19, 2020

This will advise you, and any necessary parties, that as the landlord, we grant, to you, our consent to use 4 parking spaces, in the parking lot at 2009 Atwood Avenue, at your sole discretion, for supplemental outdoor seating. This consent remains in effect until you advise us it is no longer needed.

M&M Real Estate

By: Mark Jorgensen

