

Contract Name
 Madison Police Department Training Center - Phase 1

Date 11/15/2011

Change Order No. CO 21
 Contract No. 6660
 Project No. 53W1009
 Change Order Project No.

Change Order Description
 Add, new water softener, brine taank and piping to phase 1 water heater. Remove existing water heater from Office Building.
 Deduct, cost savings to change copper piping to PEX piping

Account Numbers for this Change Order:
 CB71-58401-810642-00-53W1009

Contractor: JOE DANIELS CONSTRUCTION CO INC
 919 APPLGATE RD
 MADISON, WI 53713-3295

You are authorized and directed to make the following changes in this contract:

Item No.	Description	Est. Qty	Unit	Unit Price	*N/B	Total
1	Add water softener, brine tank and associated piping	1.00	lump sum	13,332.00	N	13,332.00
2	Add, cost to demo and remove existing Office Building water heater and piping	1.00	lump sum	600.00	N	600.00
3	Deduct, Change 1" copper piping to PEX including labor savings	1.00	lump sum	(996.00)	N	(996.00)
4	Deduct, Change 1" copper piping to PEX including labor savings	1.00	lump sum	(690.00)	N	(690.00)
5	Add, contractor markup & bond	1.00	lump sum	740.88	N	740.88
						0.00
						0.00
Net Change Order						12,986.88
The Original Contract Total						2,534,900.00
Sum of previous Change Orders						97,930.39
The new Contract Sum including this Change Order will be						2,645,817.27

This Contract is a:	Calendar Days	Working Days	Completion Date
Original Contract Time/Completion Date		182	
Net Change in Contract Time by previous change order			
Contract Time/Completion Date prior to this change order		182	
Additional day(s) as a result of this Change Order		0	
Contract time/completion date as a result of this change order		182	


* Mark if negotiated (N) or bid (B) unit price

Contractor's Acceptance
 By: [Signature]
 Title: Project Manager
 Date: 11/14/11

City's Approval (see reverse side for instructions)
 Construction Inspector: [Signature] Date: 11/15/2011
 Construction Supervisor: [Signature] Date: 11/15/2011
 Engineer: [Signature]
 Board of Public Works: [Signature]

11/29/11 BCB
 11-15-11 MAN
 OK MRO
 11/17/2011

Request for Proposal

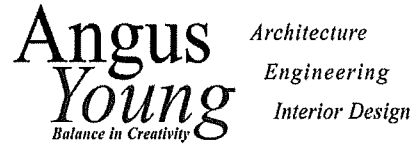

To: Mr. Joe Trainor, Project Manager
Joe Daniels Construction
919 Applegate Road
Madison, WI 53713

Request No.: GC 4
Contract for: General Construction
Initiation Date: 8/31/2011

Project: Madison Police Training Center

Response Date:

Owner: City of Madison
PROJ. #53W1009, CONTRACT#6660
5702 Femrite Drive
Madison, WI 53718

Architect's Project No.: 46451

Please submit an itemized quotation for changes in the Contract Sum and/or Time incidental to proposed modifications to the Contract Documents described herein. THIS IS NOT A CHANGE ORDER NOR A DIRECTION TO PROCEED WITH THE WORK DESCRIBED HEREIN.

Request: Sheet P101 First Floor Domestic Water Plan
Remove existing hot water heater in existing office janitors closet. Remove and cap existing gas line back to the main. Remove all vent piping. Patch existing roof as needed. Provide new piping from existing water softener to new water heater, and new hot water piping from new water heater to existng line that serves the existing office.

Provide a Capital water softener (WS-1) model FCM-NT-256-2.0" System 4 Simplex. Install brine and mineral tanks in existing janitors closet, where existing hot water heater was removed. Connect to existing 110V receptacle. Provide 2" piping from mezzanine to softener. New water softener shall serve all fixtures except; existing fixtures in existing offices, the future emergency eyewash/showers, the electric water cooler located in the shooting range, and the hose bibs located around the building. Provide new domestic hot and cold water piping from new water softener to existing piping already serving the Training Center (piping that was provided in the original bid). Route new 1" cold water line to hose bibs and water cooler located in shooting range. All other fixtures located in the shooting range area shall be softened by the existing 1.1/2" softened cold water line. RFP #4-A

When submitting pricing for this RFP please itemize each component. For example provide cost for the water softener, piping with quantity and cost per foot, removal of existng water heater, existing piping removed with quantity and cost per foot, etc.

Also, provide the pricing to do the following:

1. Change the 1" copper pipe in this RFP to PEX.
2. Change all of the copper pipe shown on P105, including the 1.12" DCW from the mezzanine and the 1" in this RFP, to PEX.

Attachment:

Action:

ARCHITECT:

Angus Young Associates, Inc.
555 South River Street
Janesville, WI 53545-4783

Mr. Adam Hertel, Project Manager, AAIA

Date _____


Copy to: File

Captain Tom Snyder, Captain of Police

Captain Sue Williams, Captain of Police

Mr. James Whitney, AIA, City Architect

Mr. Randy Wiesner, Project Manager

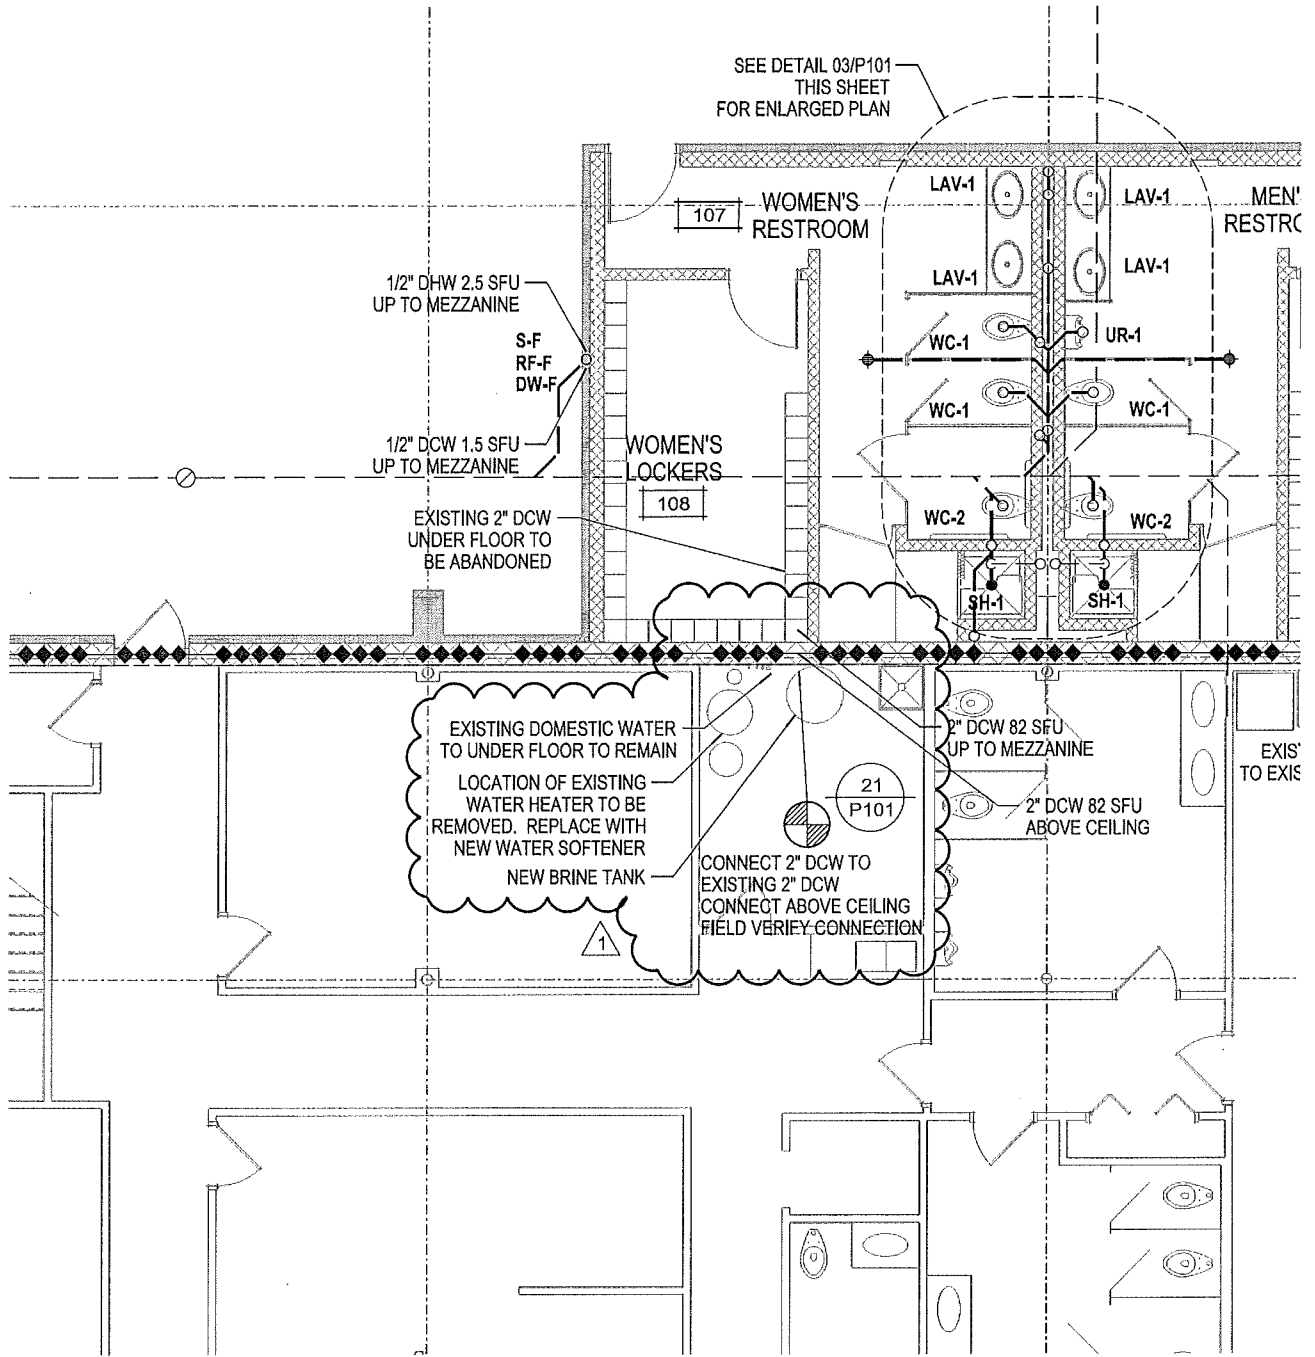

X:\46451\load\46451.dwg\SKP05.dgn

10:43:53 AM

9/22/2011

PLOTTED BY: AdamH

SCALE: 1/8" = 1'-0"

ORIGINAL SIZE = 8.5" x 11"

X:\46451\cad\46451dcSKP06.dgn


10:46:25 AM

9/22/2011

PLOTTED BY: AdamH

SCALE: 1/8" = 1'-0"

ORIGINAL SIZE = 8.5" x 11"

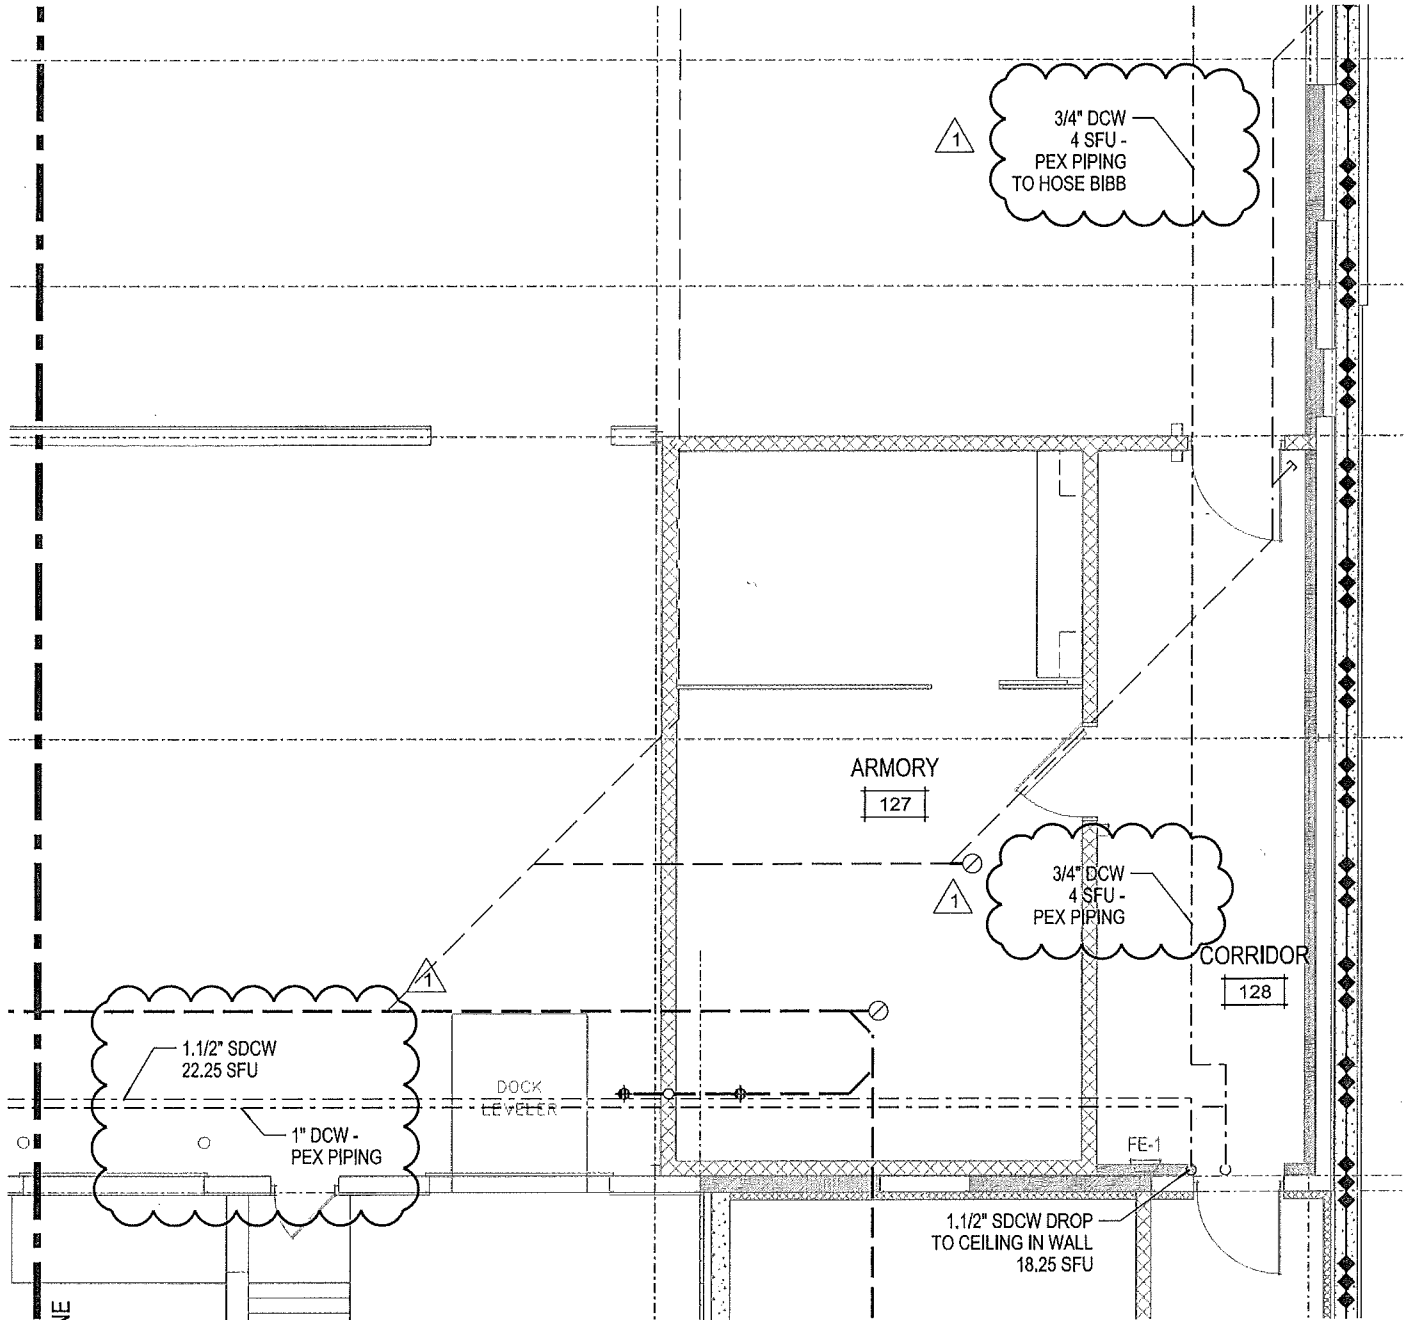

X:\46451\lead\46451dc\SKP07.dgn



10:51:22 AM


9/22/2011

PLOTTED BY: AdamH

SCALE: 1/8" = 1'-0"

ORIGINAL SIZE = 8.5" x 11"

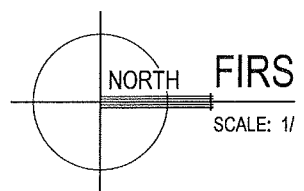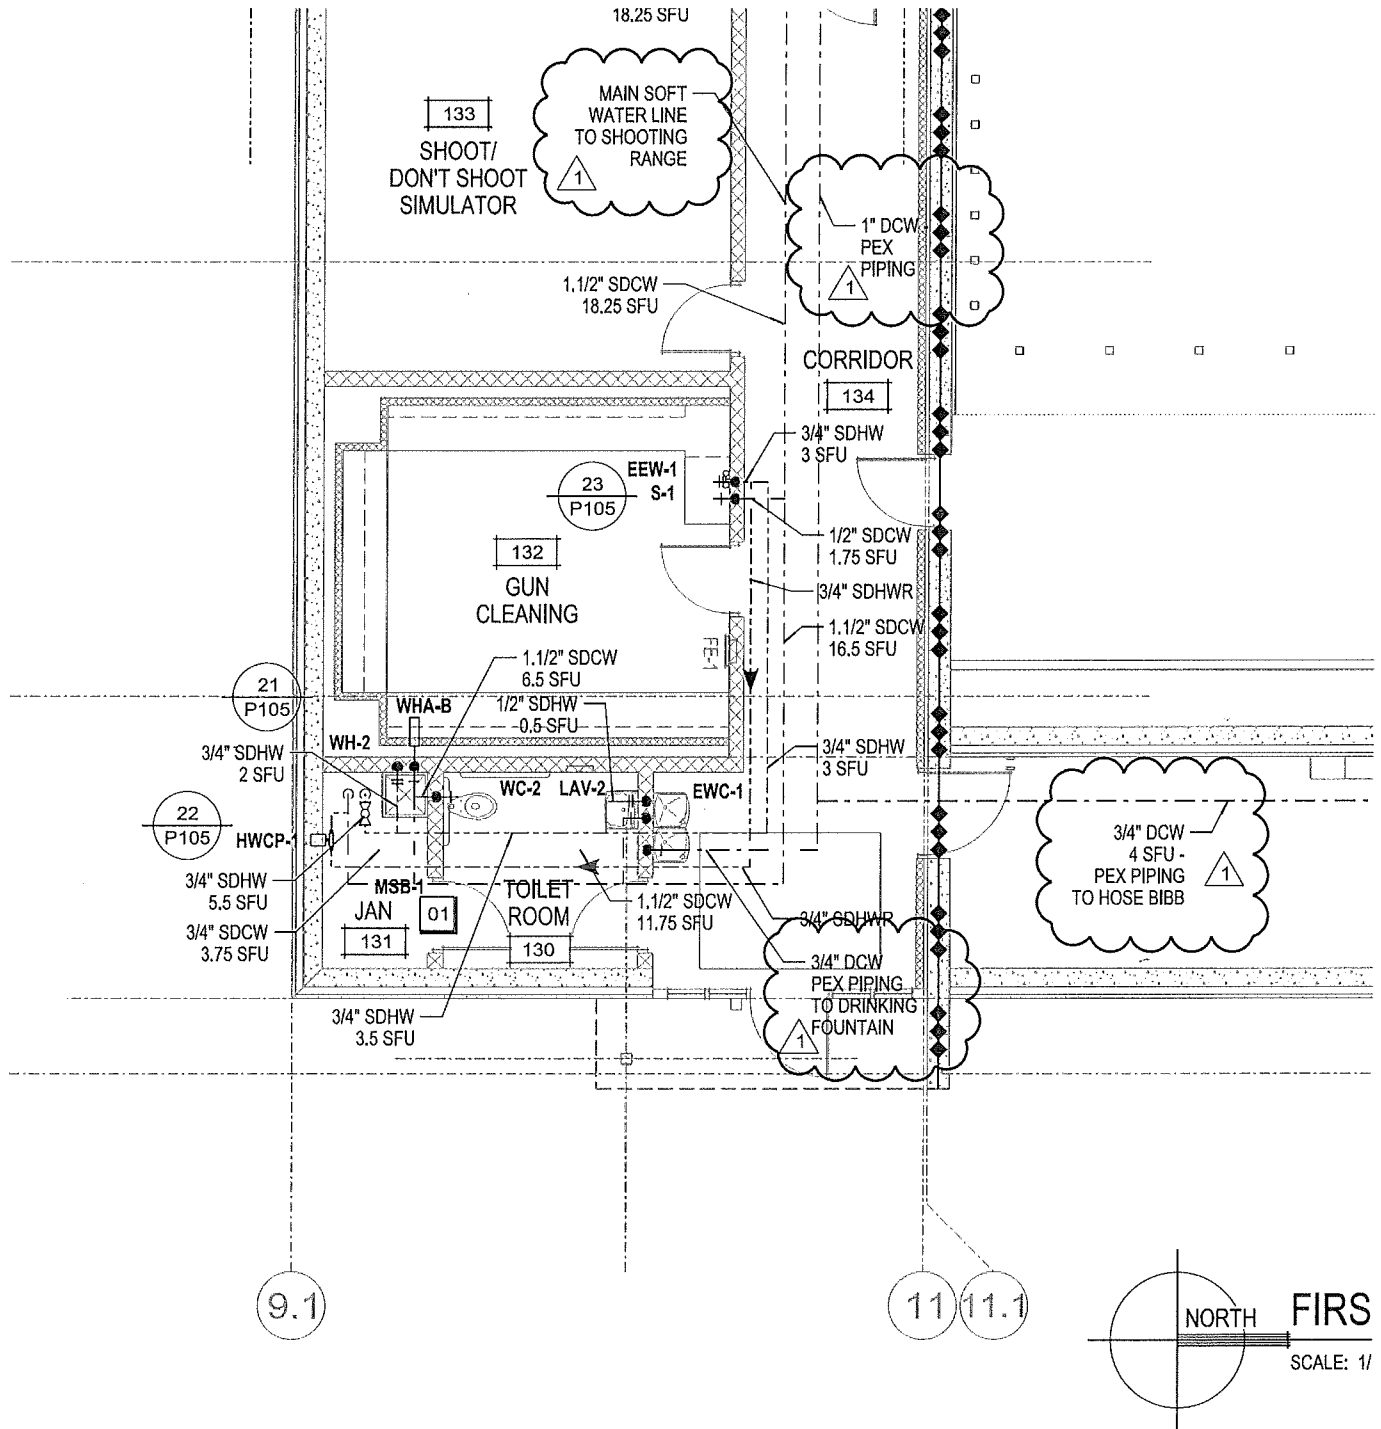

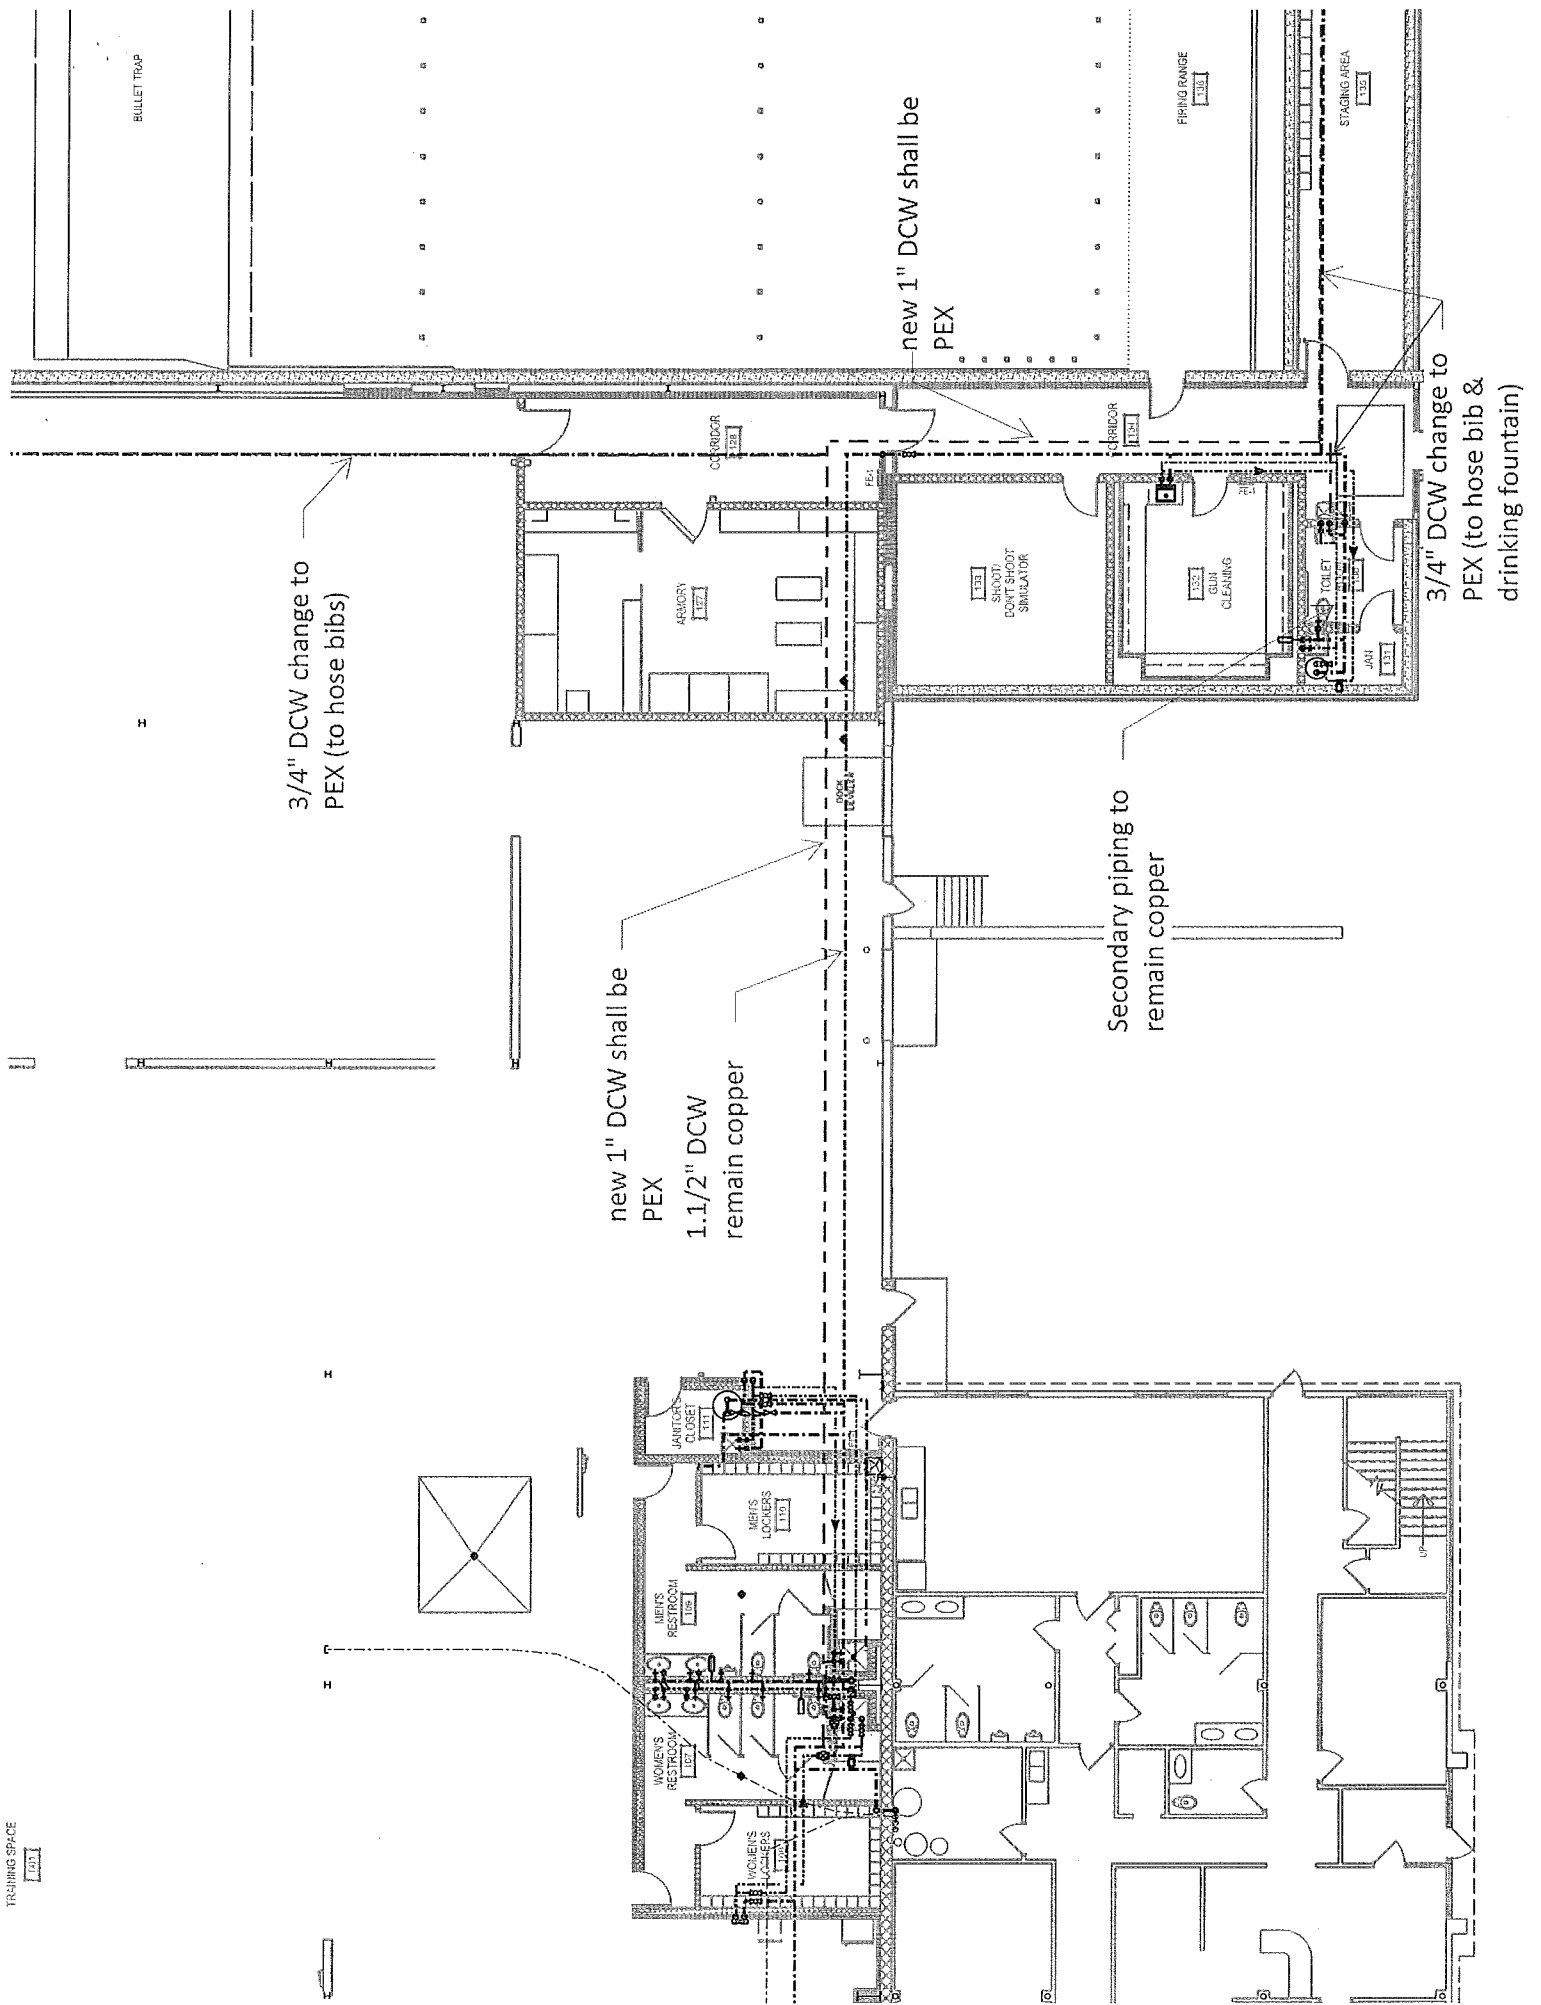

3/4" DCW change to PEX (to hose bibs)

new 1" DCW shall be PEX
1.1/2" DCW remain copper

new 1" DCW shall be PEX

Secondary piping to remain copper

3/4" DCW change to PEX (to hose bib & drinking fountain)

BULLET TRAP

CORRIDOR 1124

ARCHERY 1127

SHOOT/ DON'T SHOOT SIMULATOR 1132

GUN CLUB CLEANING 1133

TOILET 1134

JANITORY 1135

FIRING RANGE 1136

STAGING AREA 1137

JANITOR CLOSET 1111

MEN'S LOCKERS 1101

MEN'S RESTROOM 1102

WOMEN'S RESTROOM 1103

WOMEN'S LOCKERS 1104

H

H

H