

Application for Change of Licensed Premise

\$25 filing fee charged at time of application, and is not refundable. Complete application is due at 12 noon two weeks before ALRC meeting. Detailed floor plans (no larger than 8 1/2 x 14) must accompany this form, or the request will not be presented to the ALRC. Applicants must appear before the ALRC.

Please contact City Zoning (MMB LL-100, 608-266-4560). A Conditional Use Permit may be required. There is a fee for the Conditional Use Permit.

Prior to your appearance before the Alcohol License Review Committee (ALRC), you must contact

- The Alderperson of the District in which you intend to do business.
- The representative of the appropriate neighborhood association (if any).
- The Madison Police Department.

Alderperson Verveer can be reached at _____, at the Common Council Office (266-4071), or via e-mail at council@cityofmadison.com.

The name of the neighborhood association representative can be obtained by calling the Planning and Development Department at 266-4635 or online at www.ci.madison.wi.us/neighborhoods/contacts.htm.

Police Department Central District Captain ^{CARL GAOEPE} Mary Schauf (Sector 400) can be reached at 261-9694.

Police Department East District Captain Tom Snyder (Sector 600) can be reached at 267-2100.

Police Department North District Captain Cam Mclay (Sector 500) can be reached at 245-3652.

Police Department West District Captain Jay Lengfeld (Sectors 100-200) can be reached at 243-0503.

Police Department South District Captain Joe Balles (Sector 300) can be reached at 267-8687.

Corporate/Owner Name JOSEPH VALE

DBA TIKI SHACK

Address 126 STATE ST - 53703

Current Capacity (Indoor): 51 Proposed Capacity (Indoor): 99

Current Capacity (Outdoor): _____ Proposed Capacity (Outdoor): ~~99~~

Description of Proposed Changes: Change From 1 DINING

Room into 2 ~~outdoor~~ ~~seating~~

~~with 20 seats~~

Signature of Applicant [Signature] Date 1 MAR 2011

Application to be considered at the _____ ALRC meeting and the _____ Council meeting.


License Type _____ License # _____ Legistar # _____

Routed: City Zoning Building Inspection Madison Police Sector _____ Alder _____ (District _____)

Approved / Not Approved (Circle One)

LICPC 2011-00150

DAYTON STREET

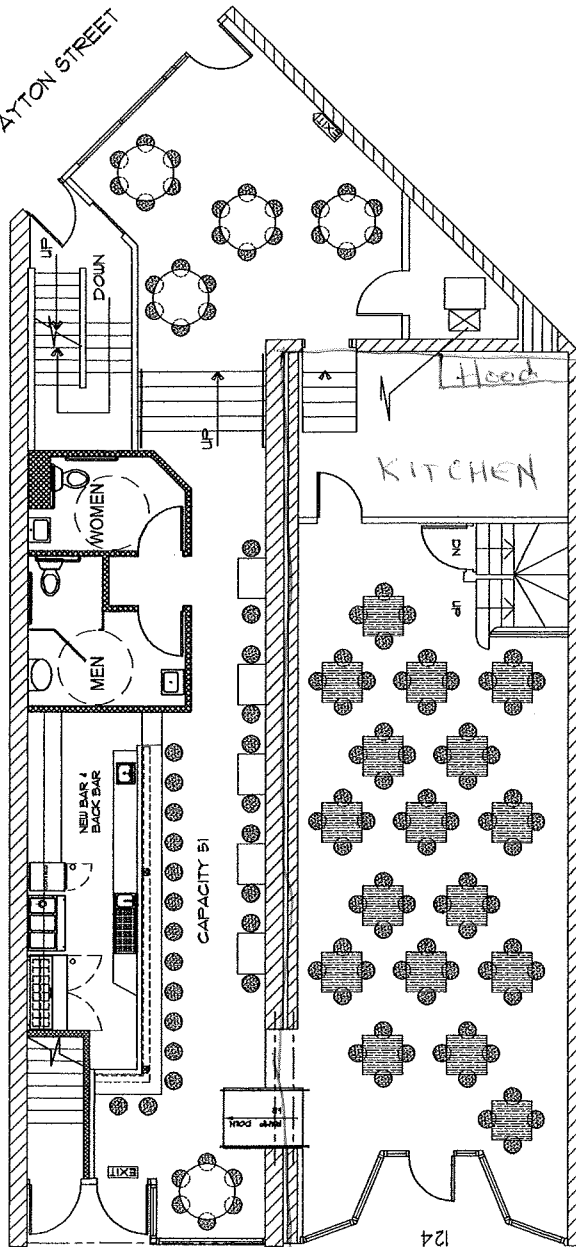

ADD
15' x 9'
KITCHEN
WITH
DINING
ROOM



FLOOR PLAN
1/8" = 1'-0"

STATE STREET