

Change of Premises

Fee: \$25.00

City of Madison Clerk
210 MLK Jr Blvd, Room 103
Madison, WI 53703

(Agenda Item Number)

(Legistar file number)

LICPCN-2022-00223
(License number)

(Alder District #) (Police Sector)
Office Use Only

Class A: Beer, Liquor, Cider
Class B: Beer, Liquor,
 Class C Wine

licensing@cityofmadison.com www.cityofmadison.com
608-266-4601

Licensed Premises Information

This application modifies existing alcohol license number: LICLIB-2019-00471

Business dba Name: Muskellounge and Sporting Club

Licensed Address: 4102 Monona Drive

Liquor/Beer Agent Name: Chad Vogel

84 % Alcohol, 15 % Food, 1 % Other Alder, District #: 15 Police Sector: East

Corporate Information

Business Legal Name (as on WI State Sellers Permit): Small Change LLC

Business Mailing Address: 4102 Monona Dr

Business Contact Name, Position: Chad Vogel owner/partner

Business Phone: 608-213-0771 Business Email: info@muskellounge.com

Current Capacity (indoor): 148 Current Capacity (outdoor): ~~148~~ 34

Proposed Capacity (indoor): ~~34~~ 148 Proposed Capacity (outdoor): 75

If your capacity is increasing, contact Building Inspection: (608) 266-4551, buildinginspection@cityofmadison.com www.cityofmadison.com

Description of Proposed Changes: Expansion of patio for ~~event~~ charity event
annually called Strip Mall Carnival w/ Clean Wisconsin
and Stateline

Detailed Floor Plans included (required)


[Signature], 4-19-22
Authorized Signature Date

- Orange sign and business card issued
 - "License Renewals & Changes" brochure with next steps issued
- Office Use Only



Proposed Change
* Fencing will be added for Event

08.27.18
CADDEN LIA
10.24.18
SITE APPROVAL
12.14.18
FINAL APPROVAL

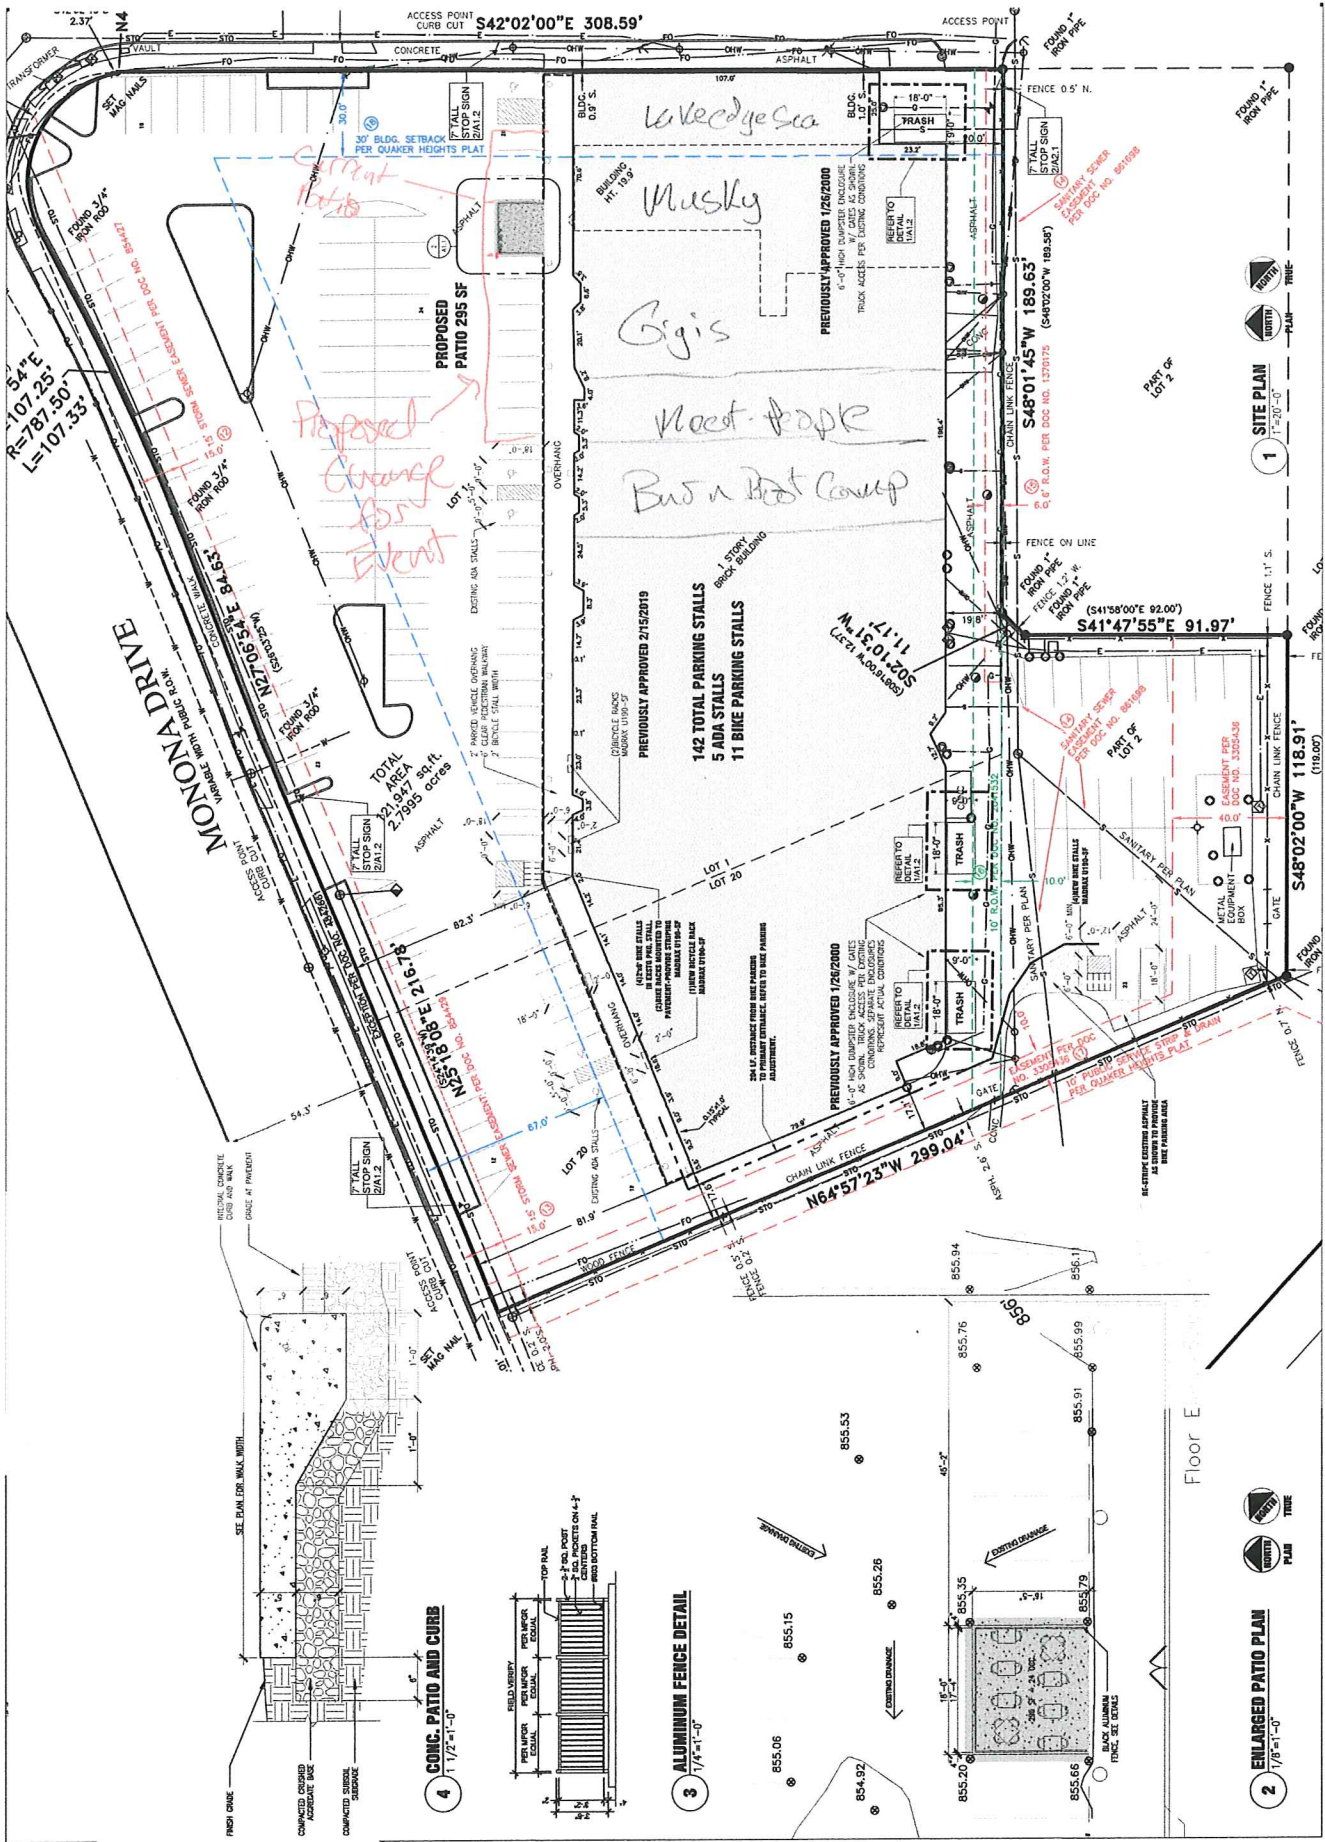


1 SITE PLAN
1" = 200'-0"



2 ENLARGED PATIO PLAN
1/8" = 1'-0"



3 ALUMINUM FENCE DETAIL
1/4" = 1'-0"

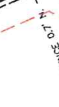

4 CONC. PATIO AND CURB
1 1/2" = 1'-0"



Floor E



4100-1130 MONONA DRIVE

MONONA DRIVE

ACCESS POINT CURB CUT

ACCESS POINT