




Hawks Woods Condominiums

Area of Proposed Change

Hawks Woods Condominiums

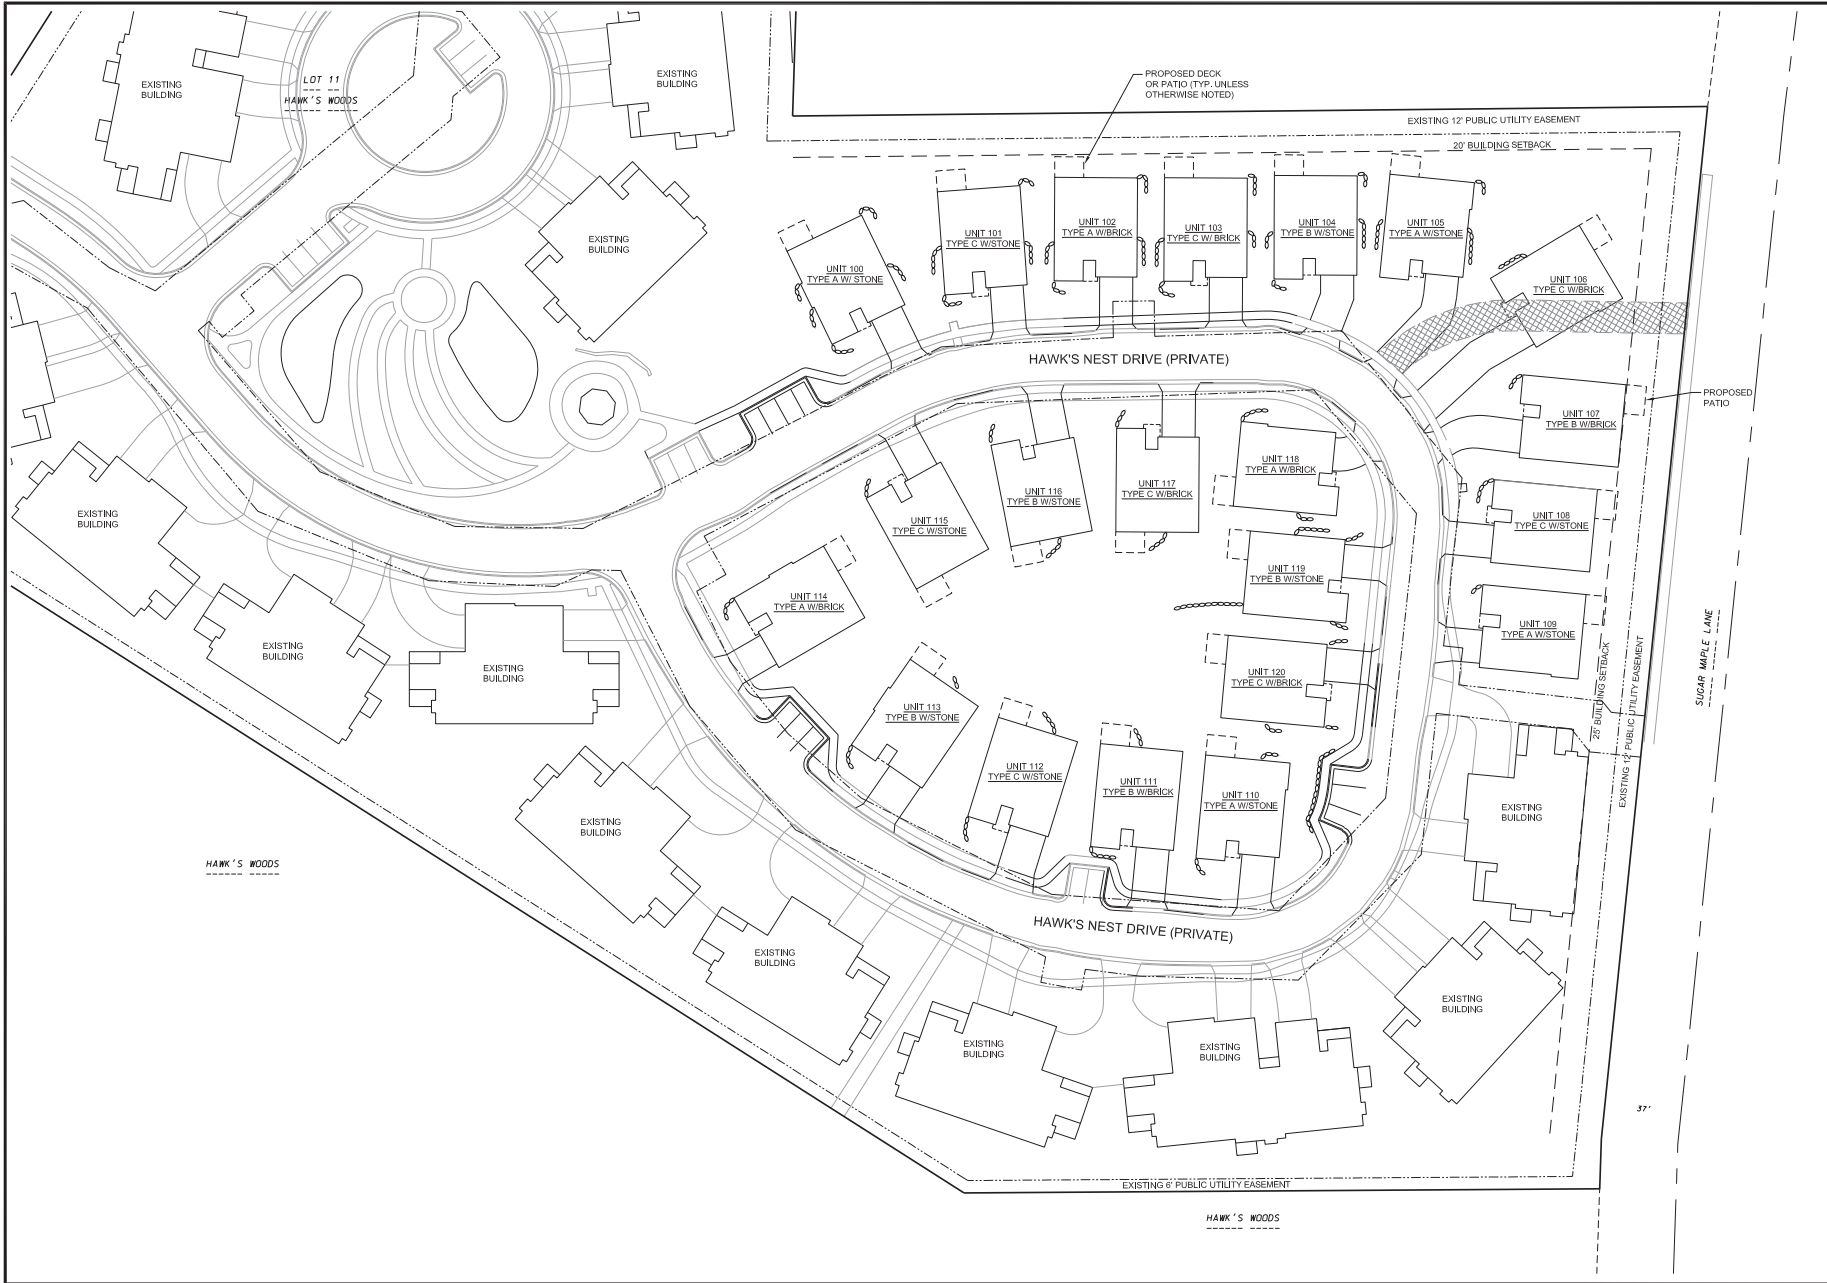

D DIONIG KOTTLE AND ASSOCIATES, INC.
 2750 Westward Way, Madison, WI 53717
 Phone: 608.555.2500 • Fax: 608.555.1109
 YOUR NATURAL RESOURCE FOR LAND DEVELOPMENT


BUILDING ELEVATION PLAN
HAWK'S WOODS CONDOMINIUM
 CITY OF MADISON, DANE COUNTY, WISCONSIN



SCALE: 1" = 30'
 (PAGE SIZE: 22x34)

DATE: 11-20-15
 REVISED:

 DRAWN BY: KJP
 FA: 14-05-157
 Sheet Number:

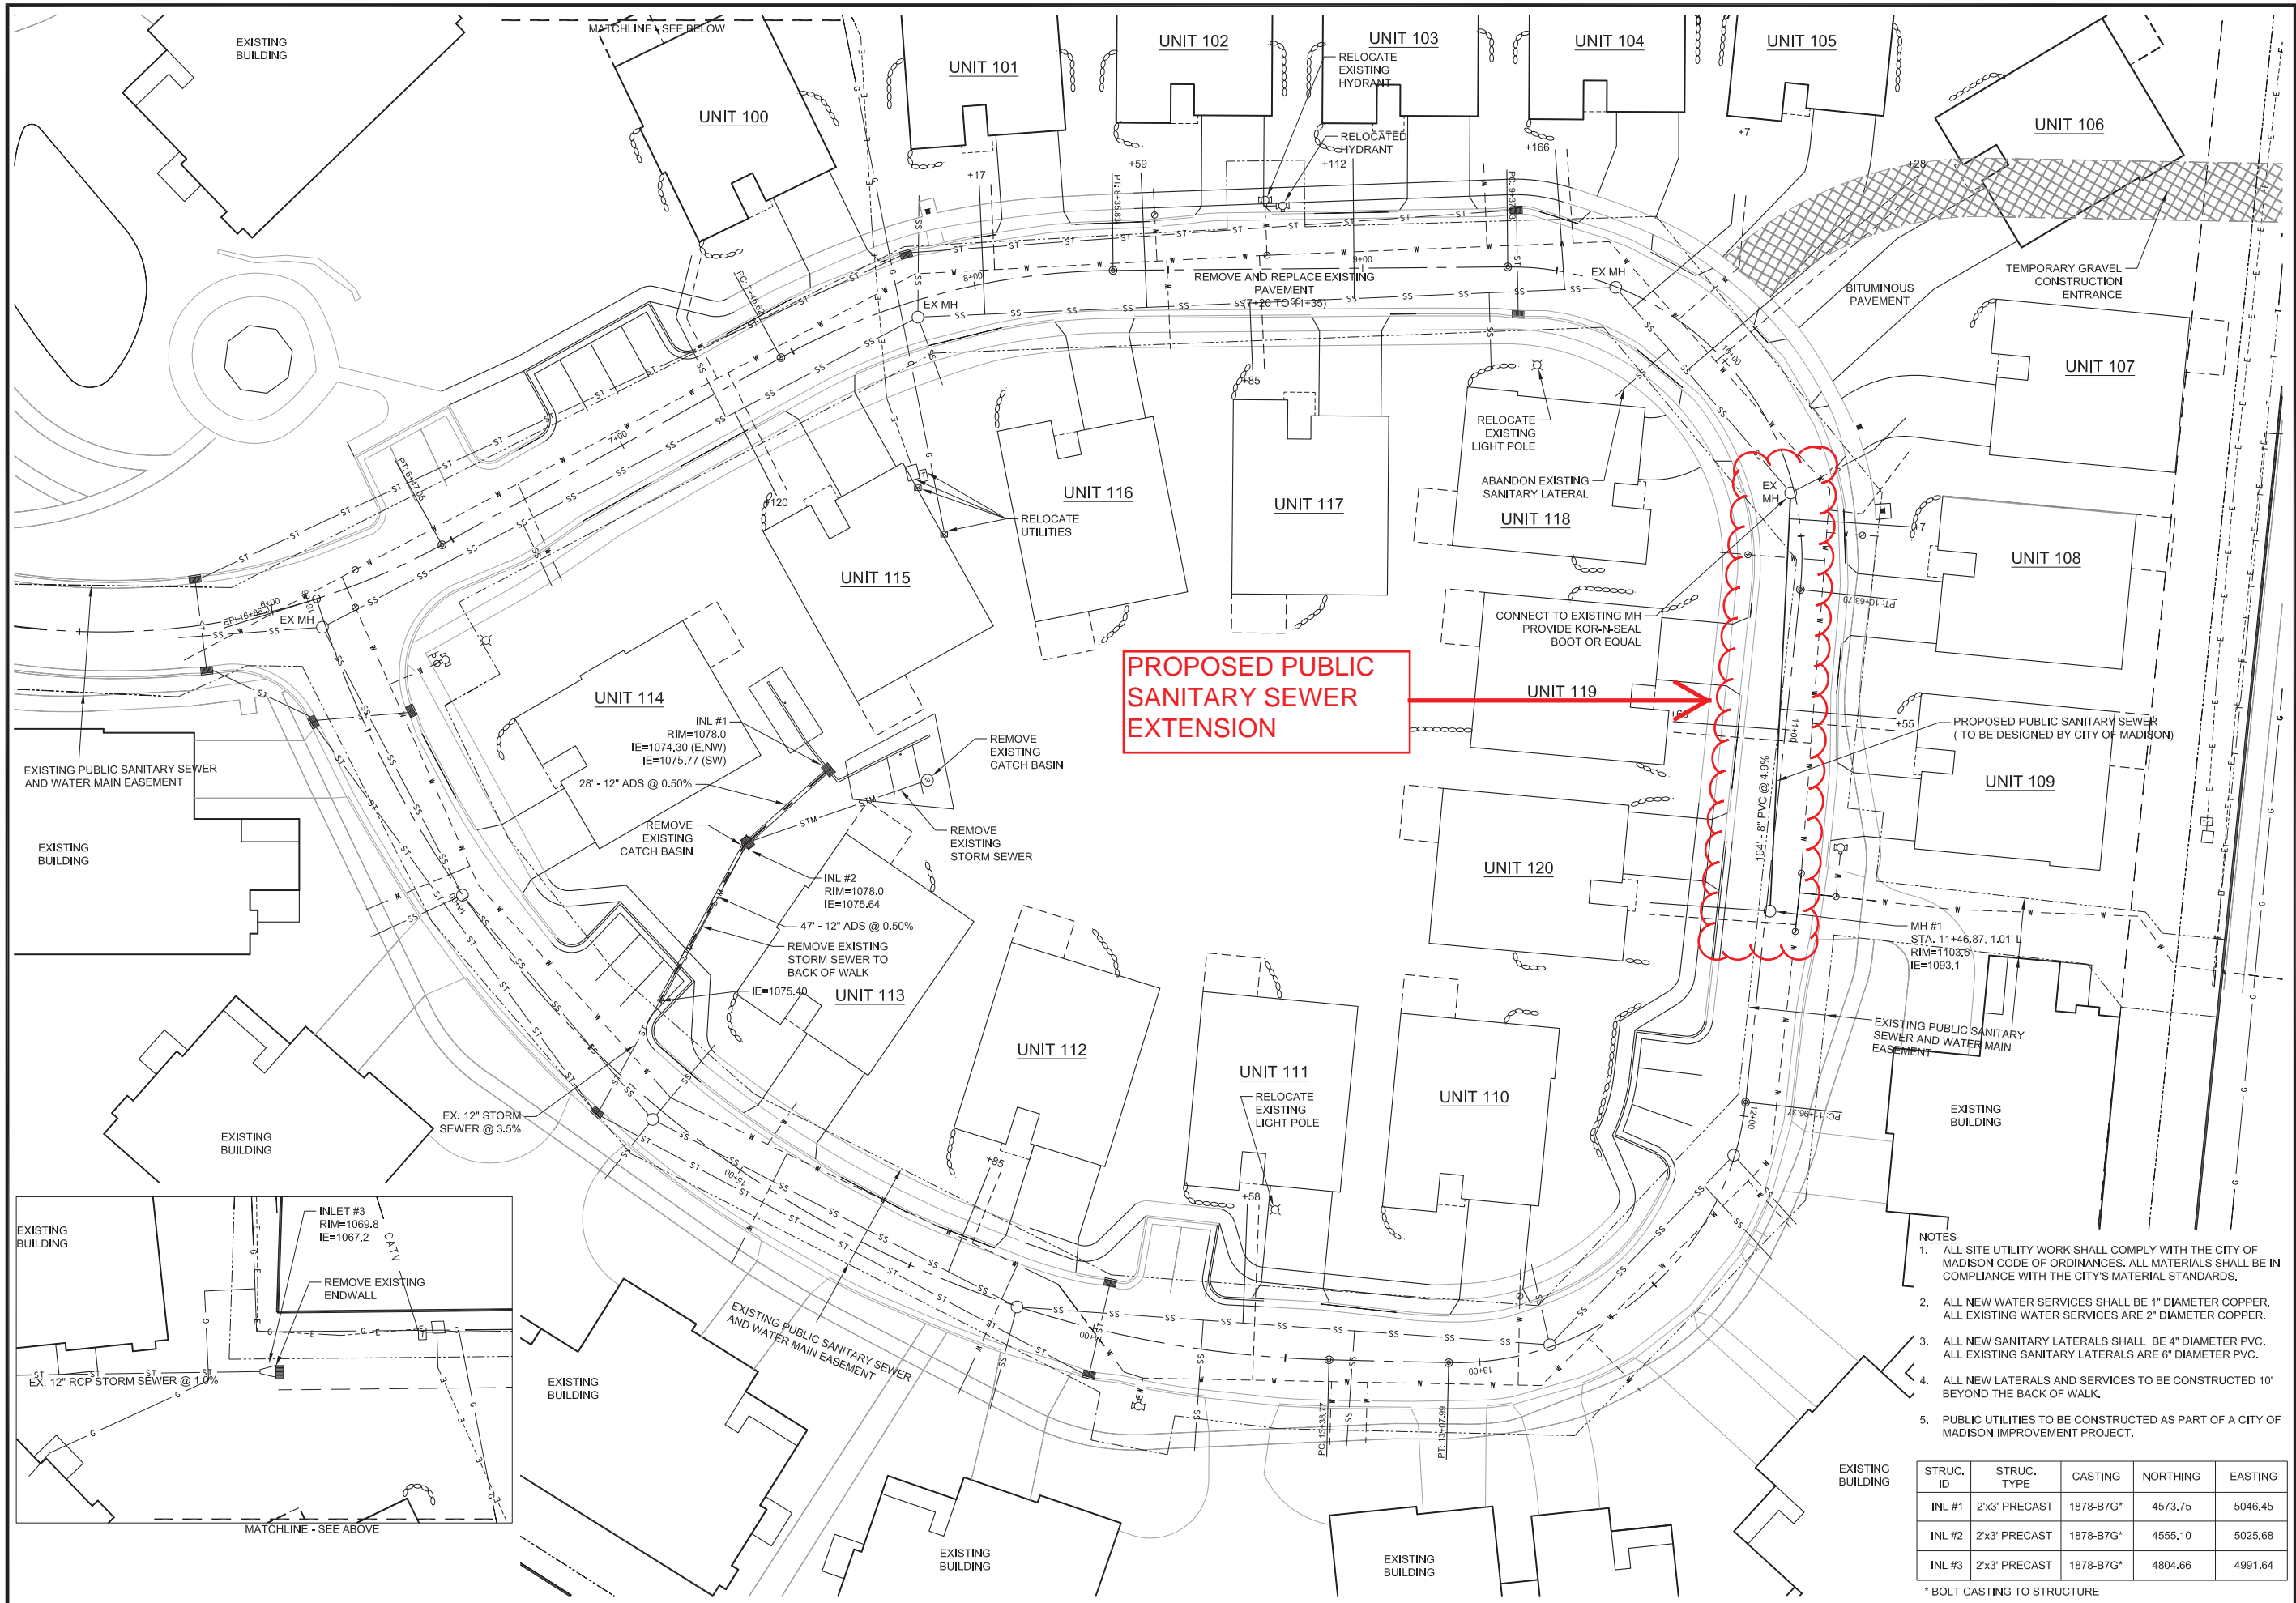

**PROPOSED PUBLIC
SANITARY SEWER
EXTENSION**


- NOTES**
1. ALL SITE UTILITY WORK SHALL COMPLY WITH THE CITY OF MADISON CODE OF ORDINANCES. ALL MATERIALS SHALL BE IN COMPLIANCE WITH THE CITY'S MATERIAL STANDARDS.
 2. ALL NEW WATER SERVICES SHALL BE 1" DIAMETER COPPER. ALL EXISTING WATER SERVICES ARE 2" DIAMETER COPPER.
 3. ALL NEW SANITARY LATERALS SHALL BE 4" DIAMETER PVC. ALL EXISTING SANITARY LATERALS ARE 6" DIAMETER PVC.
 4. ALL NEW LATERALS AND SERVICES TO BE CONSTRUCTED 10' BEYOND THE BACK OF WALK.
 5. PUBLIC UTILITIES TO BE CONSTRUCTED AS PART OF A CITY OF MADISON IMPROVEMENT PROJECT.

EXISTING BUILDING	STRUC. ID	STRUC. TYPE	CASTING	NORTHING	EASTING
	INL #1	2'x3' PRECAST	1878-B7G*	4573.75	5046.45
	INL #2	2'x3' PRECAST	1878-B7G*	4555.10	5025.68
	INL #3	2'x3' PRECAST	1878-B7G*	4804.66	4991.64

* BOLT CASTING TO STRUCTURE

D'ONOFRIO KOTKE AND ASSOCIATES, INC.
 7530 Westward Way, Madison, WI 53717
 Phone: 608.833.7550 • Fax: 608.833.1089
 YOUR NATURAL RESOURCE FOR LAND DEVELOPMENT

UTILITY PLAN
HAWK'S WOODS CONDOMINIUM
 CITY OF MADISON, DANE COUNTY, WISCONSIN

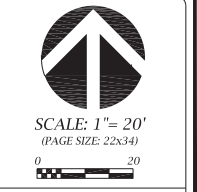

DATE: 11-20-15
 REVISED:

DRAWN BY: KJP
 FN: 14-05-157
 Sheet Number:
 8 of 10