
4221 Marsh Road

Private Development Contract: 9032, Project: 13500 Addendum #1



The developer, Realtime Properties, LLC, was required to build new sidewalk adjacent to Lot 1 of Certified Survey Map 10313 as part of this Private Developer Agreement. The Developer has proposed a new Certified Survey Map to subdivide Lot 1 of Certified Survey Map No 10313 located at 4229 Marsh Road into two lots. The Developer and the City have since mutually agreed to update the scope of work for the project to remove the southern 292 lineal feet of sidewalk construction from Lot 1 of Certified Survey Map No 10313. The owner of proposed Lot 2 will construct the 292 lineal feet of sidewalk with a separate Contract with the City of Madison.

Contract: 9032, Project: 13500 CSM No. 10313 (page 1 only)

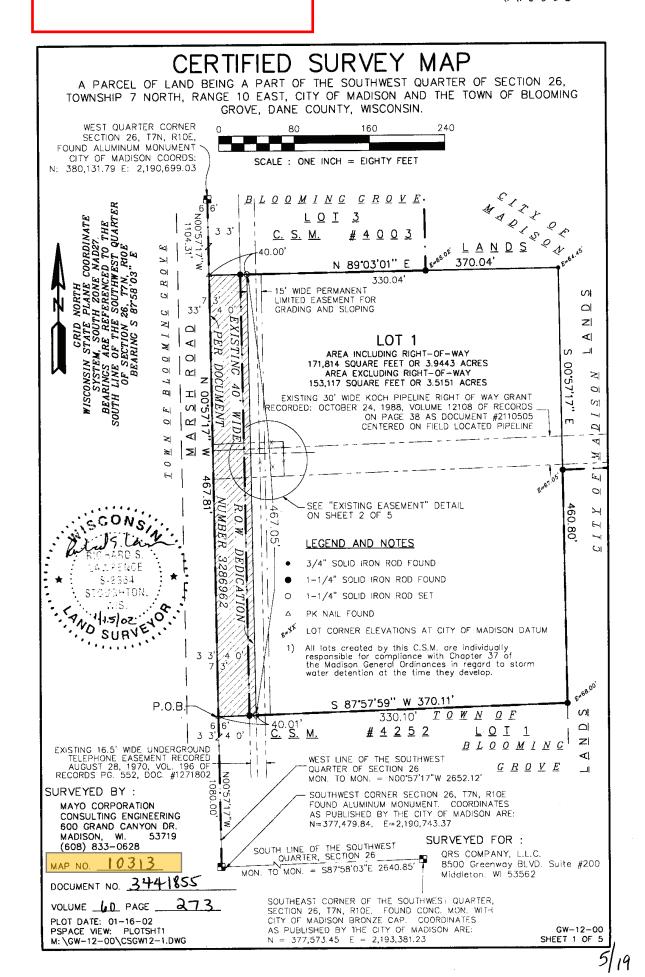

Shown in green. Contract: 9275, Project: 14498. Shown in pink. PROP'D 6" SAN SWR PROP'D 12" STO SWR PROP'D 8" SAN SV SIDEWALK HF STA. 11+00.0 ELEV. 910.02 www.kellerbuilds.com PROVIDE CURB CUT FOR **GREAT LAKES ROOFING CORPORATION ROAD** MARSH 2" MILL AND OVERLAY NOTES:
1. THE RIGHT-OF-MAY IS THE SOLE JURISDICTION OF THE CITY
1. THE RIGHT-OF-MAY IS THE SOLE JURISDICTION OF THE CITY
THE RECOMMENDATION OF THE THE THE THE PREVIOUS OF THE RECOMMENDATION OF THE THE THE ENOUNCERNO AND
CITY FEIGHWEERING DEPARTMENTS.
2. ALL WORK WITHIN THE CITY FROMT-OF-MAY AND ALL PUBLIC
MARKOVEMENTS TO SERVE THE PROJECT SHALL BE
COONLISTED FOR THE CITY OF MARGON RESIDED PLANS
2. MARGH ROAD CENTERLINE IS 38.09 RIGHT OF REPERENCE
THE BOC STA 10+68.31 ELEV. MATCH EXIST 64.65 RT CONCRETE DRIVEWAY APRON, SEE COMMERCIAL DRIVEWAY PERMIT LNDSPR-2021-00022. (M:DESIGN:TRAFFICIMAPS_PLANSIPARKINGLOTPLANSTEIMMARSH RD 4221/MARSH RD 4221 PERMIT_210521.PDF) REMOVE AND REPLACE CONCRETE CURB & GUTTER PROPOSED CONCRETE -"COPYRIGHT NOTICE" 900 PROP'D 8" SAN SWR T. PULLARA 890 DESIGNER: C. MEISEL DRAWN BY: G. DEPREY EXPEDITOR: C. HOYER SUPERVISOR D. CRAKER PRELIMINARY NO: 880 CONTRACT NO: 74145 6/24/2021

Contract: 9032, Project: 13500.

Ruekert • Mielke

Waukesha • Kenosha • Madison

Global Water Center • Fox Valley

4221 Marsh Road Contract: 9032, Project: 13500 Addendum #1

Public sidewalk installed from STA. 10+00 to STA 11+75

with Contract 9032, Project: 13500.

PROPOSED SIDEWALK

Addendum No. 1 will remove the construction of sidewalk from Sta. 11+75 to STA 14+68.24 from

Sidewalk from 11+75 to STA 14+68.24 will be installed with a new private developer agreement

"ISSUED FOR CONSTRUCTION"