


LARGES: MONTELEONE, SERVO, FINE
 CHAIRS: MONTELEONE, SERVO, FINE
 CHAIRS: MONTELEONE, SERVO, FINE

- FULL PANEL W/ HIDDEN LOCK
- 1/4" TYP. FROM SEMI-RECESSED
- WHITE

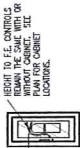

WHITE
 LINE WITH 3/8" DIA.
 TO INSTALLING F.E. CAB

FINISHED FLOOR

FIRE CABINET
 SCALE INT.S


3

GENERAL KITCHEN PLAN NOTES

1. WALL IN KITCHEN TO BE EITHER PAINTED WITH AN EPOXY PAINT, OR APPLIED WITH TILE OR FRP. C.C. TO COORDINATE WITH OWNER.
2. FLOORING IN KITCHEN TO BE APPLIED ON WALL BEHIND UTILITY HOOD AS CASE REQUIRES.
3. FLOORING IN KITCHEN TO BE EITHER TILE OR EPOXY. C.C. TO COORDINATE WITH OWNER.
4. CEILING IN KITCHEN TO BE CHANGABLE SURFACE. C.C. TO COORDINATE WITH OWNER.
5. C.C. TO COORDINATE WITH OWNER ALL ELECTRICAL, OUTLET, NEEDS/LOCATIONS.
6. C.C. TO COORDINATE WITH OWNER ALL ELECTRICAL, OUTLET, NEEDS/LOCATIONS.
7. ALL HARDWARE: COUNTRY, DOOR, LEGS TO BE COORDINATED BY C.C. WITH THE OWNER.
8. SERVING TOTALS:
9. 1. STUOLS: 4
10. 2. STUOLS: 4

PLAN/EQUIP. KEY

- 1 WORK BURNER
- 2 STOVE BURNER
- 3 DEEP Fryer
- 4 DISHWASHER
- 5 ICE MACHINE
- 6 ESPRESSO
- 7 SINGLE PREP SINK
- 8 IN-COUNTER HAND SINK
- 9 PREP REFRIGERATOR
- 10 3-COMPARTMENT SINK
- 11 IN-COUNTER 3-COMPARTMENT SINK
- 12 HAND SINK
- 13 ICE BIN
- 14 P.O.S.
- 15 TRASH CAN
- 16 42" H. COUNTERTOP
- 17 36" H. COUNTERTOP
- 18 FIRE RETARDANT PRESSURIZED WALL PANEL FROM FLOOR TO SOFFIT, CONTRIN COLOR WITH OWNER.
- 19 48" H. SERVING WINDOW COUNTER

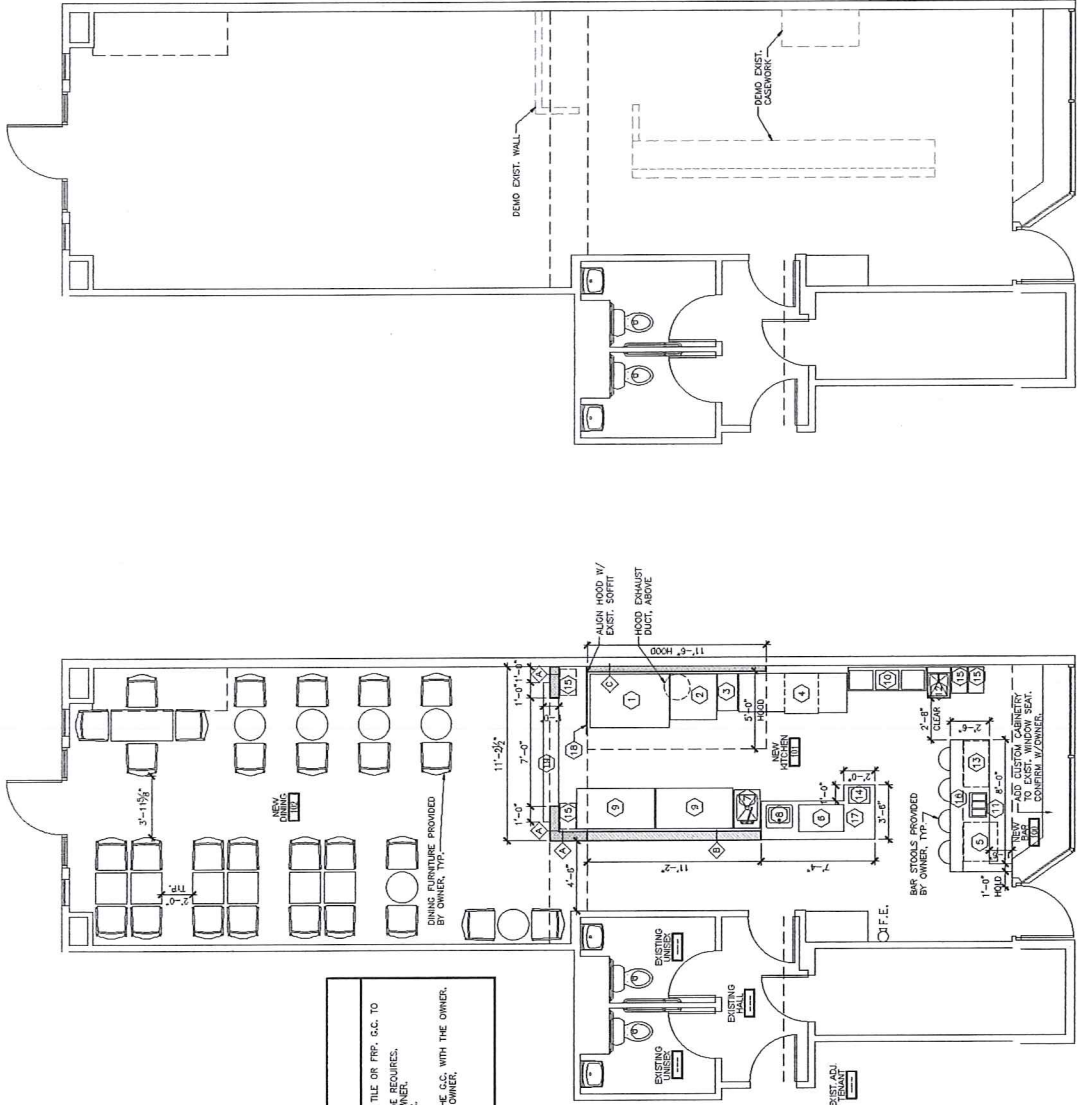

THRIVE ARCHITECTS
 Architect
 259 South Street, Suite A
 WAUKESHA, WI 53186
 P: 833-380-8180

Project Info. — 22107
Monsoon Siam 2
 Interior Remodel
 2326 Ashwood Ave.
 Madison, WI

Sheet Title
FLOOR PLANS

Drawn by
 JAU
 Checked by
 JDB

No.	Date	Description
01	01.04.2023	Plan Review /
02	04.25.2023	Plan Review /
03	04.25.2023	Plan Review /
04	04.25.2023	Resubmitted

Sheet No.
A1.0

2023-04-25 Plan Review Resubmittal

DEMO FLOOR PLAN
 SCALE: 1/4"=1'-0" (22x34), 1/8"=1'-0" (11x17)



EQUIPMENT FLOOR PLAN
 SCALE: 1/4"=1'-0" (22x34), 1/8"=1'-0" (11x17)

Sheet Title
**SECOND FLOOR PLAN,
 WALL TYPES, AND
 DETAILS**

Drawn by	JAU	Checked by	JDB
----------	-----	------------	-----

No.	Date	Description
01.06.2023	01.06.2023	Plan Review / Permit
04.25.2023	04.25.2023	Permit Review / Resubmitted

2023-04-25 Plan Review Resubmittal

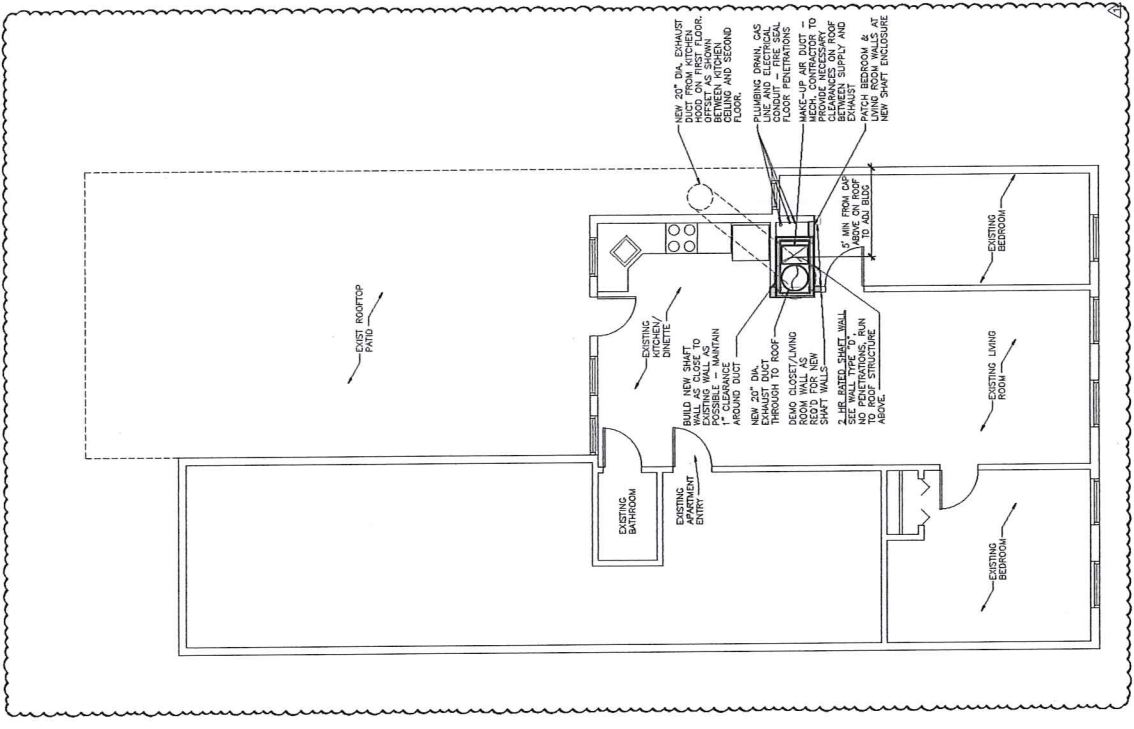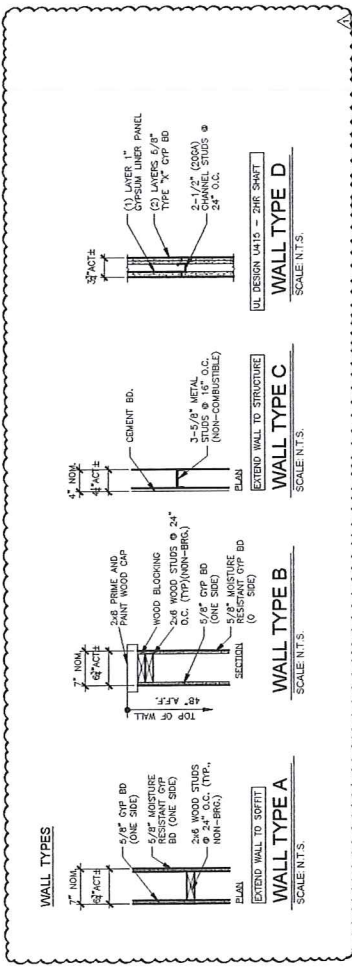

PARTIAL SECOND FLOOR PLAN
 SCALE: 1/4"=1'-0" (2x24), 1/8"=1'-0" (11x17)