




01 - Mint Mark - Locator Map

Project Name - 2024.02
February 12, 2024



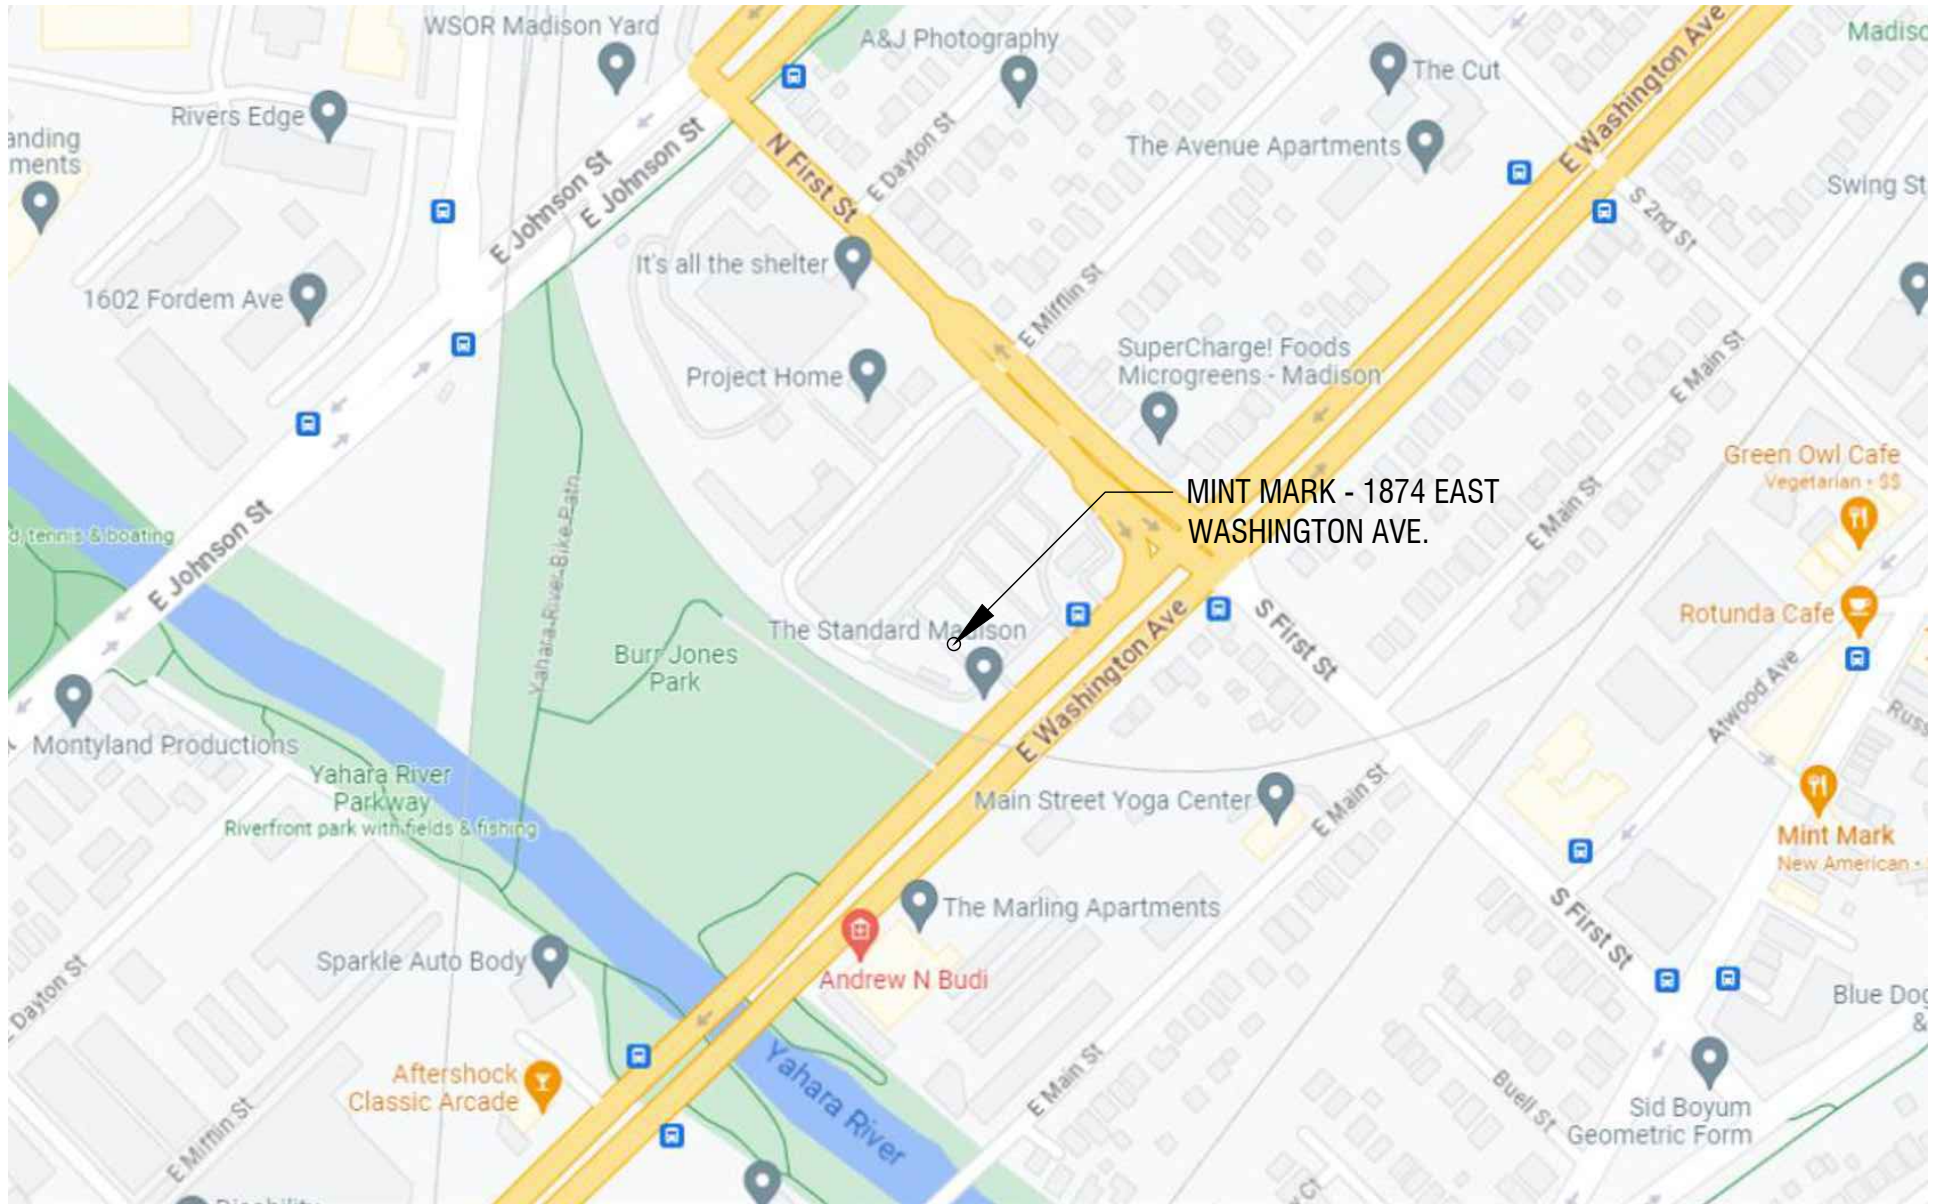


02 - Mint Mark - Building Location Map

Project Name - 2024.02

February 12, 2024



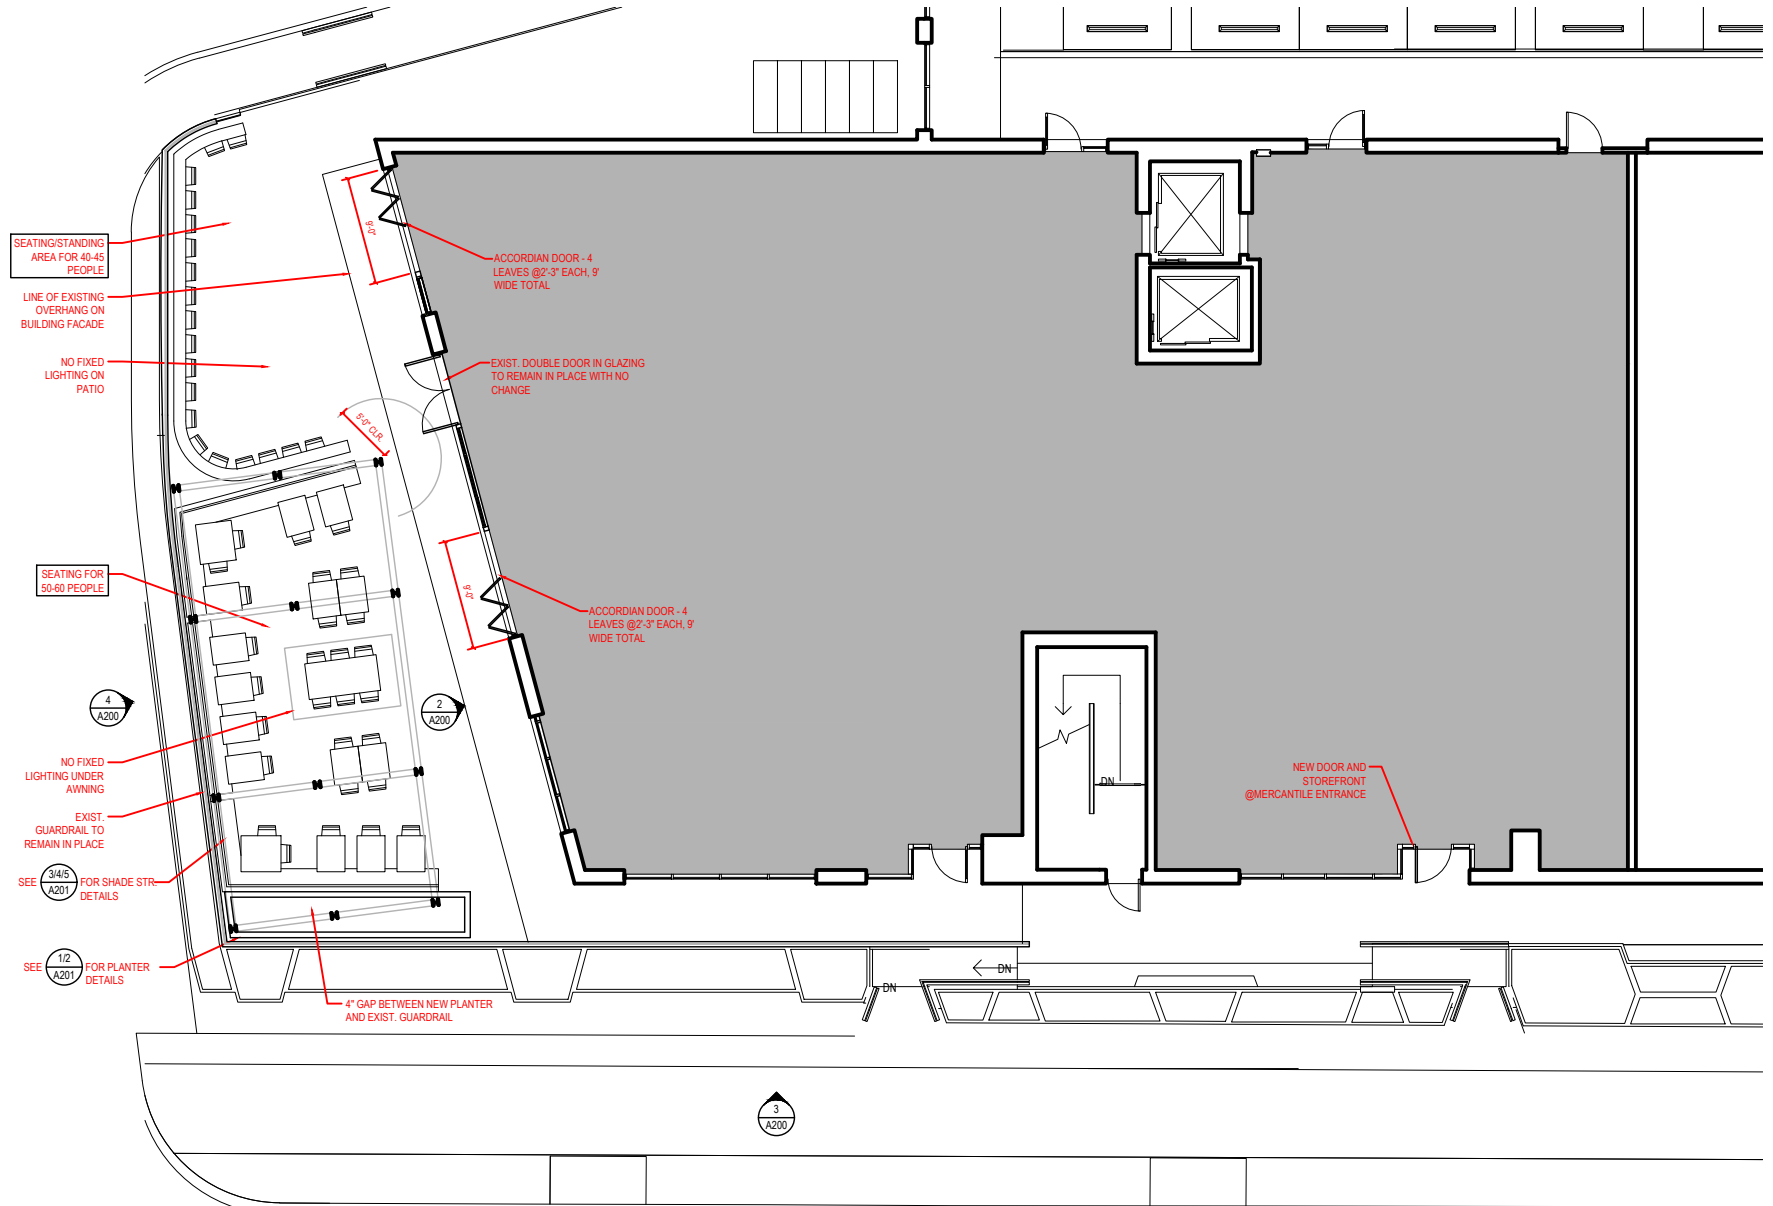

03 - Mint Mark - Patio Plan Detail

Project Name - 2024.02

February 12, 2024

MINT MARK
RESTAURANT


1874 E. Washington Ave.
Madison, Wisconsin 53704

Project #: 2024.02

Date	Issuance/Revisions
PLAN REVIEW	06-12-23
PLAN REVIEW - REV 1	08-04-23
MINOR ALT	09-05-23
MINOR ALT UPDATE	10-30-23
PLAN REVIEW - UPDATE	11-08-23
PROGRESS UPDATE	11-09-23
CONST. UPDATE 1	01-02-24
MINOR ALT	01-29-24

FLOOR PLAN

A101

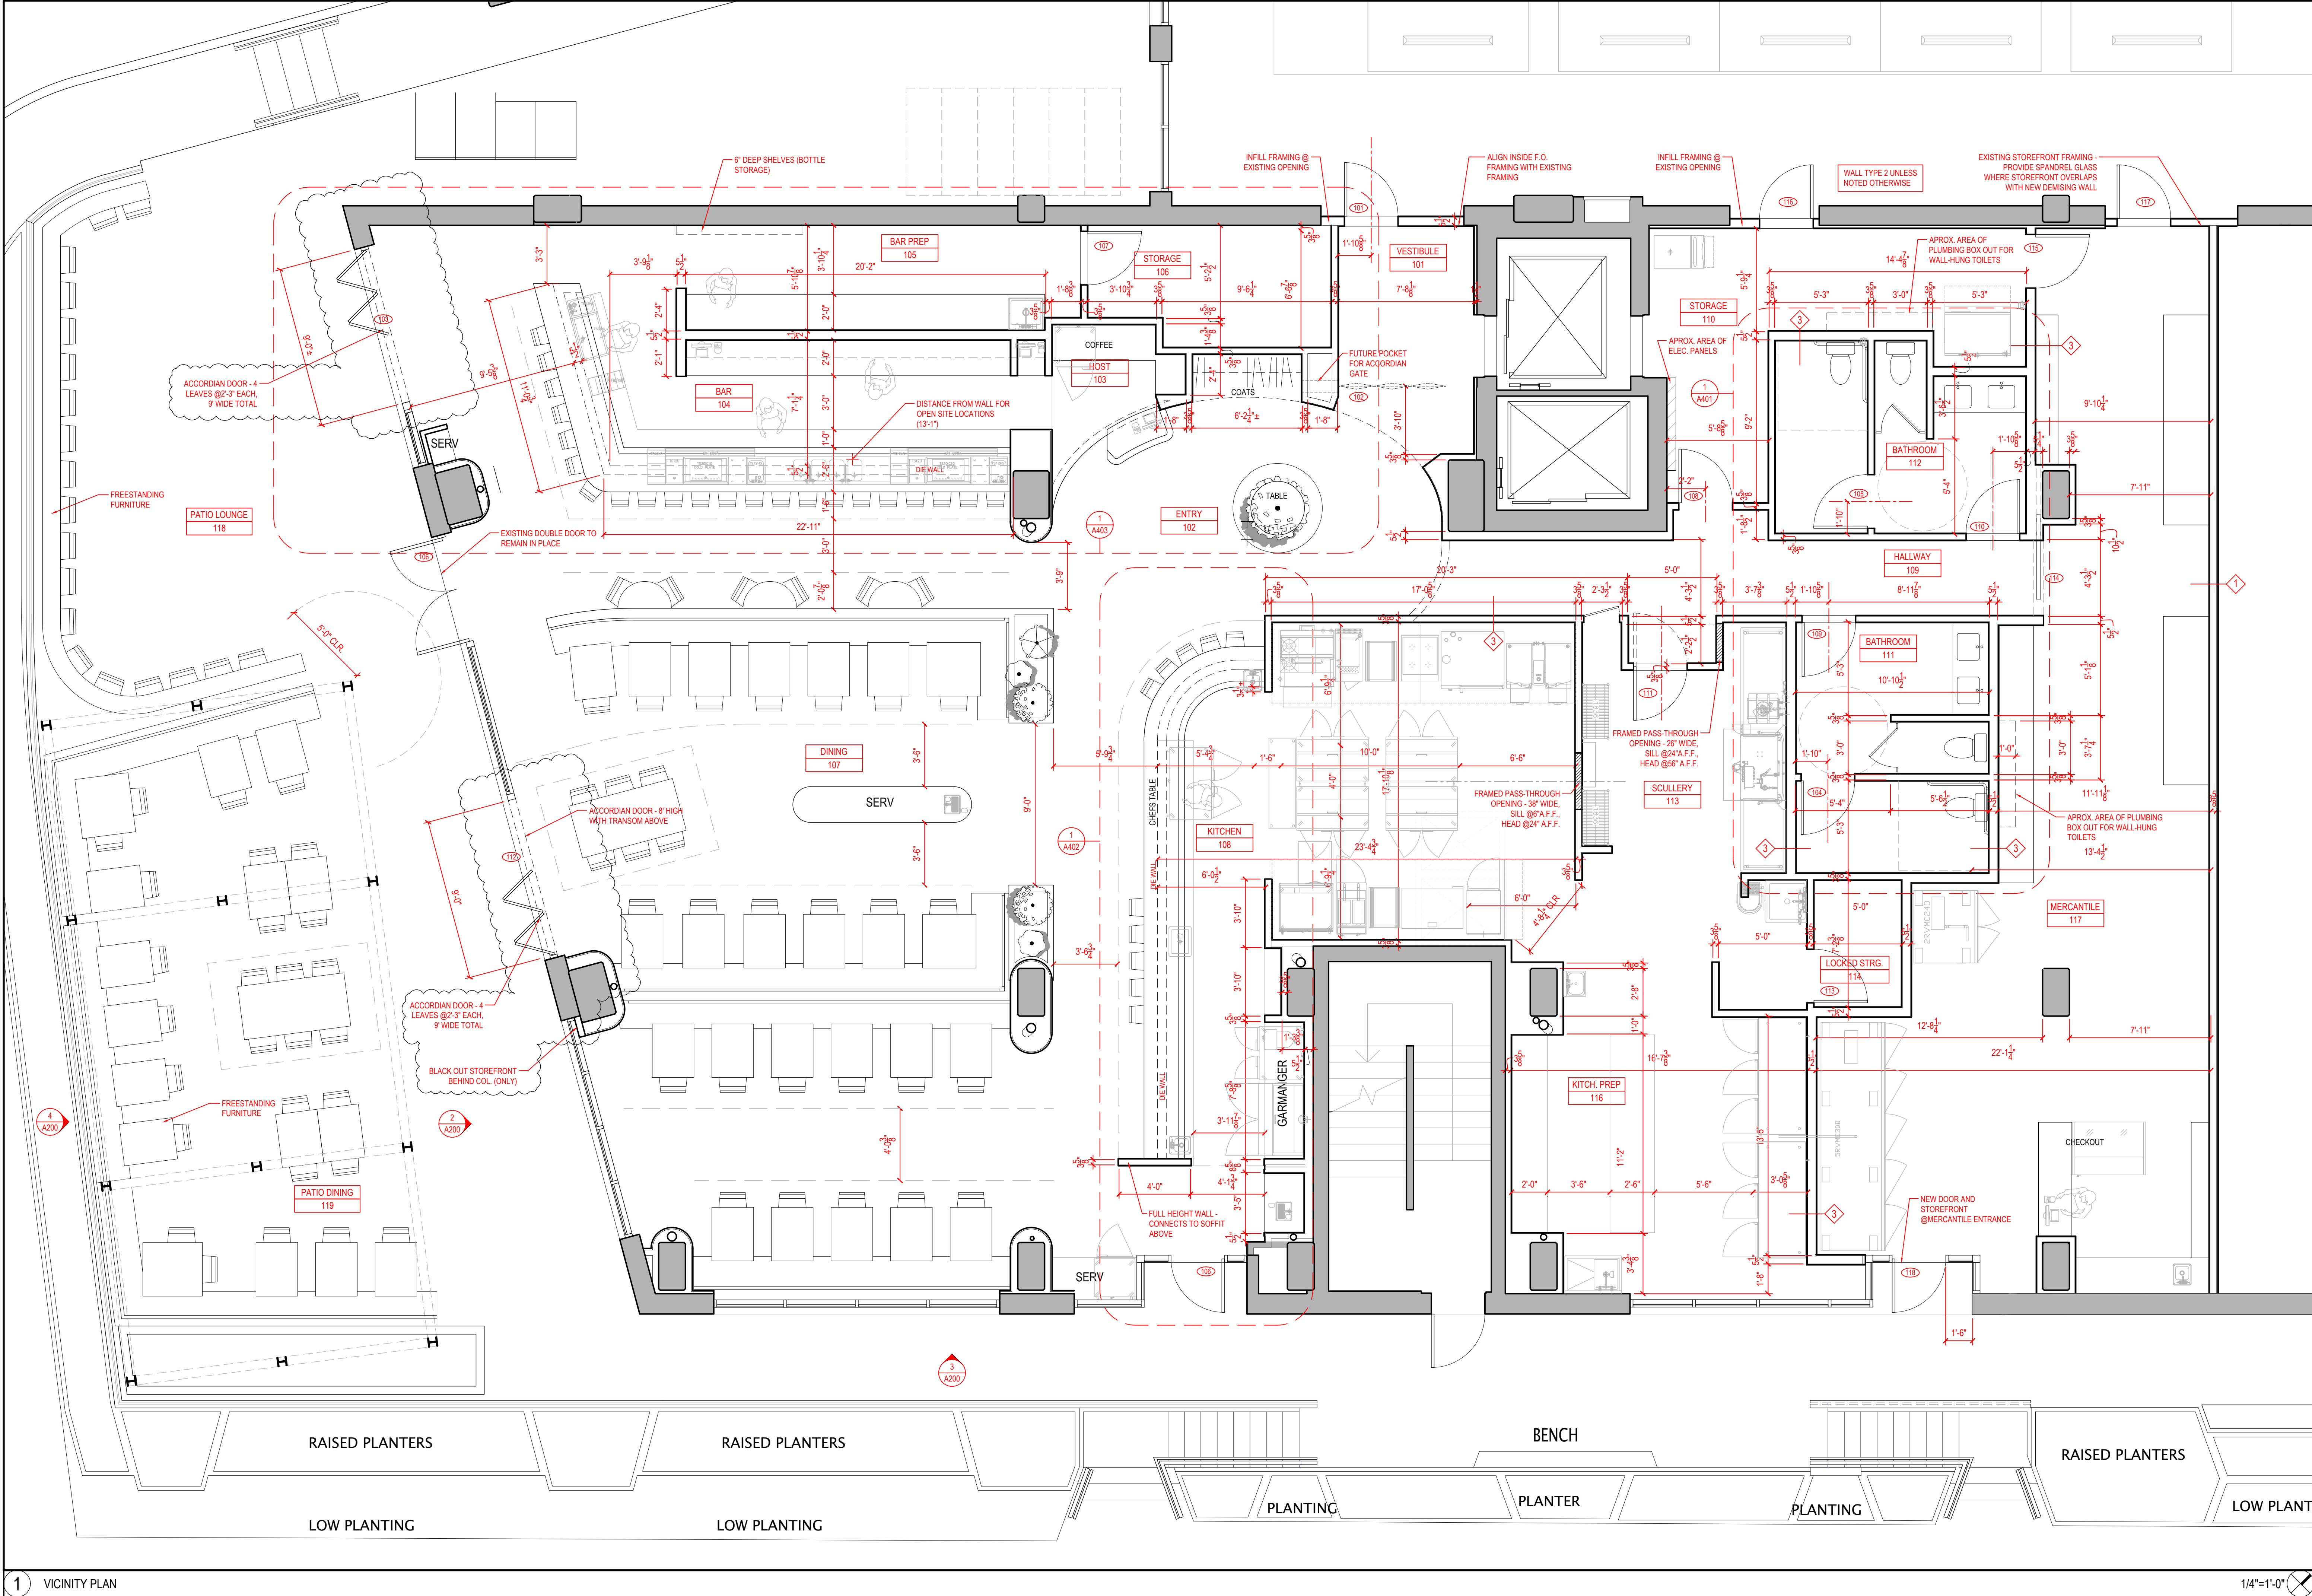

MINT MARK
RESTAURANT






1874 E. Washington Ave.
Madison, Wisconsin 53704

Project #: 2024.02

Date	Issuance/Revisions
PLAN REVIEW	06-12-23
PLAN REVIEW - REV 1	08-04-23
MINOR ALT	09-05-23
MINOR ALT UPDATE	10-30-23
PLAN REVIEW - UPDATE	11-08-23
PROGRESS UPDATE	11-09-23
CONST. UPDATE 1	01-02-24
MINOR ALT	01-29-24



EXT. ELEV.

A200

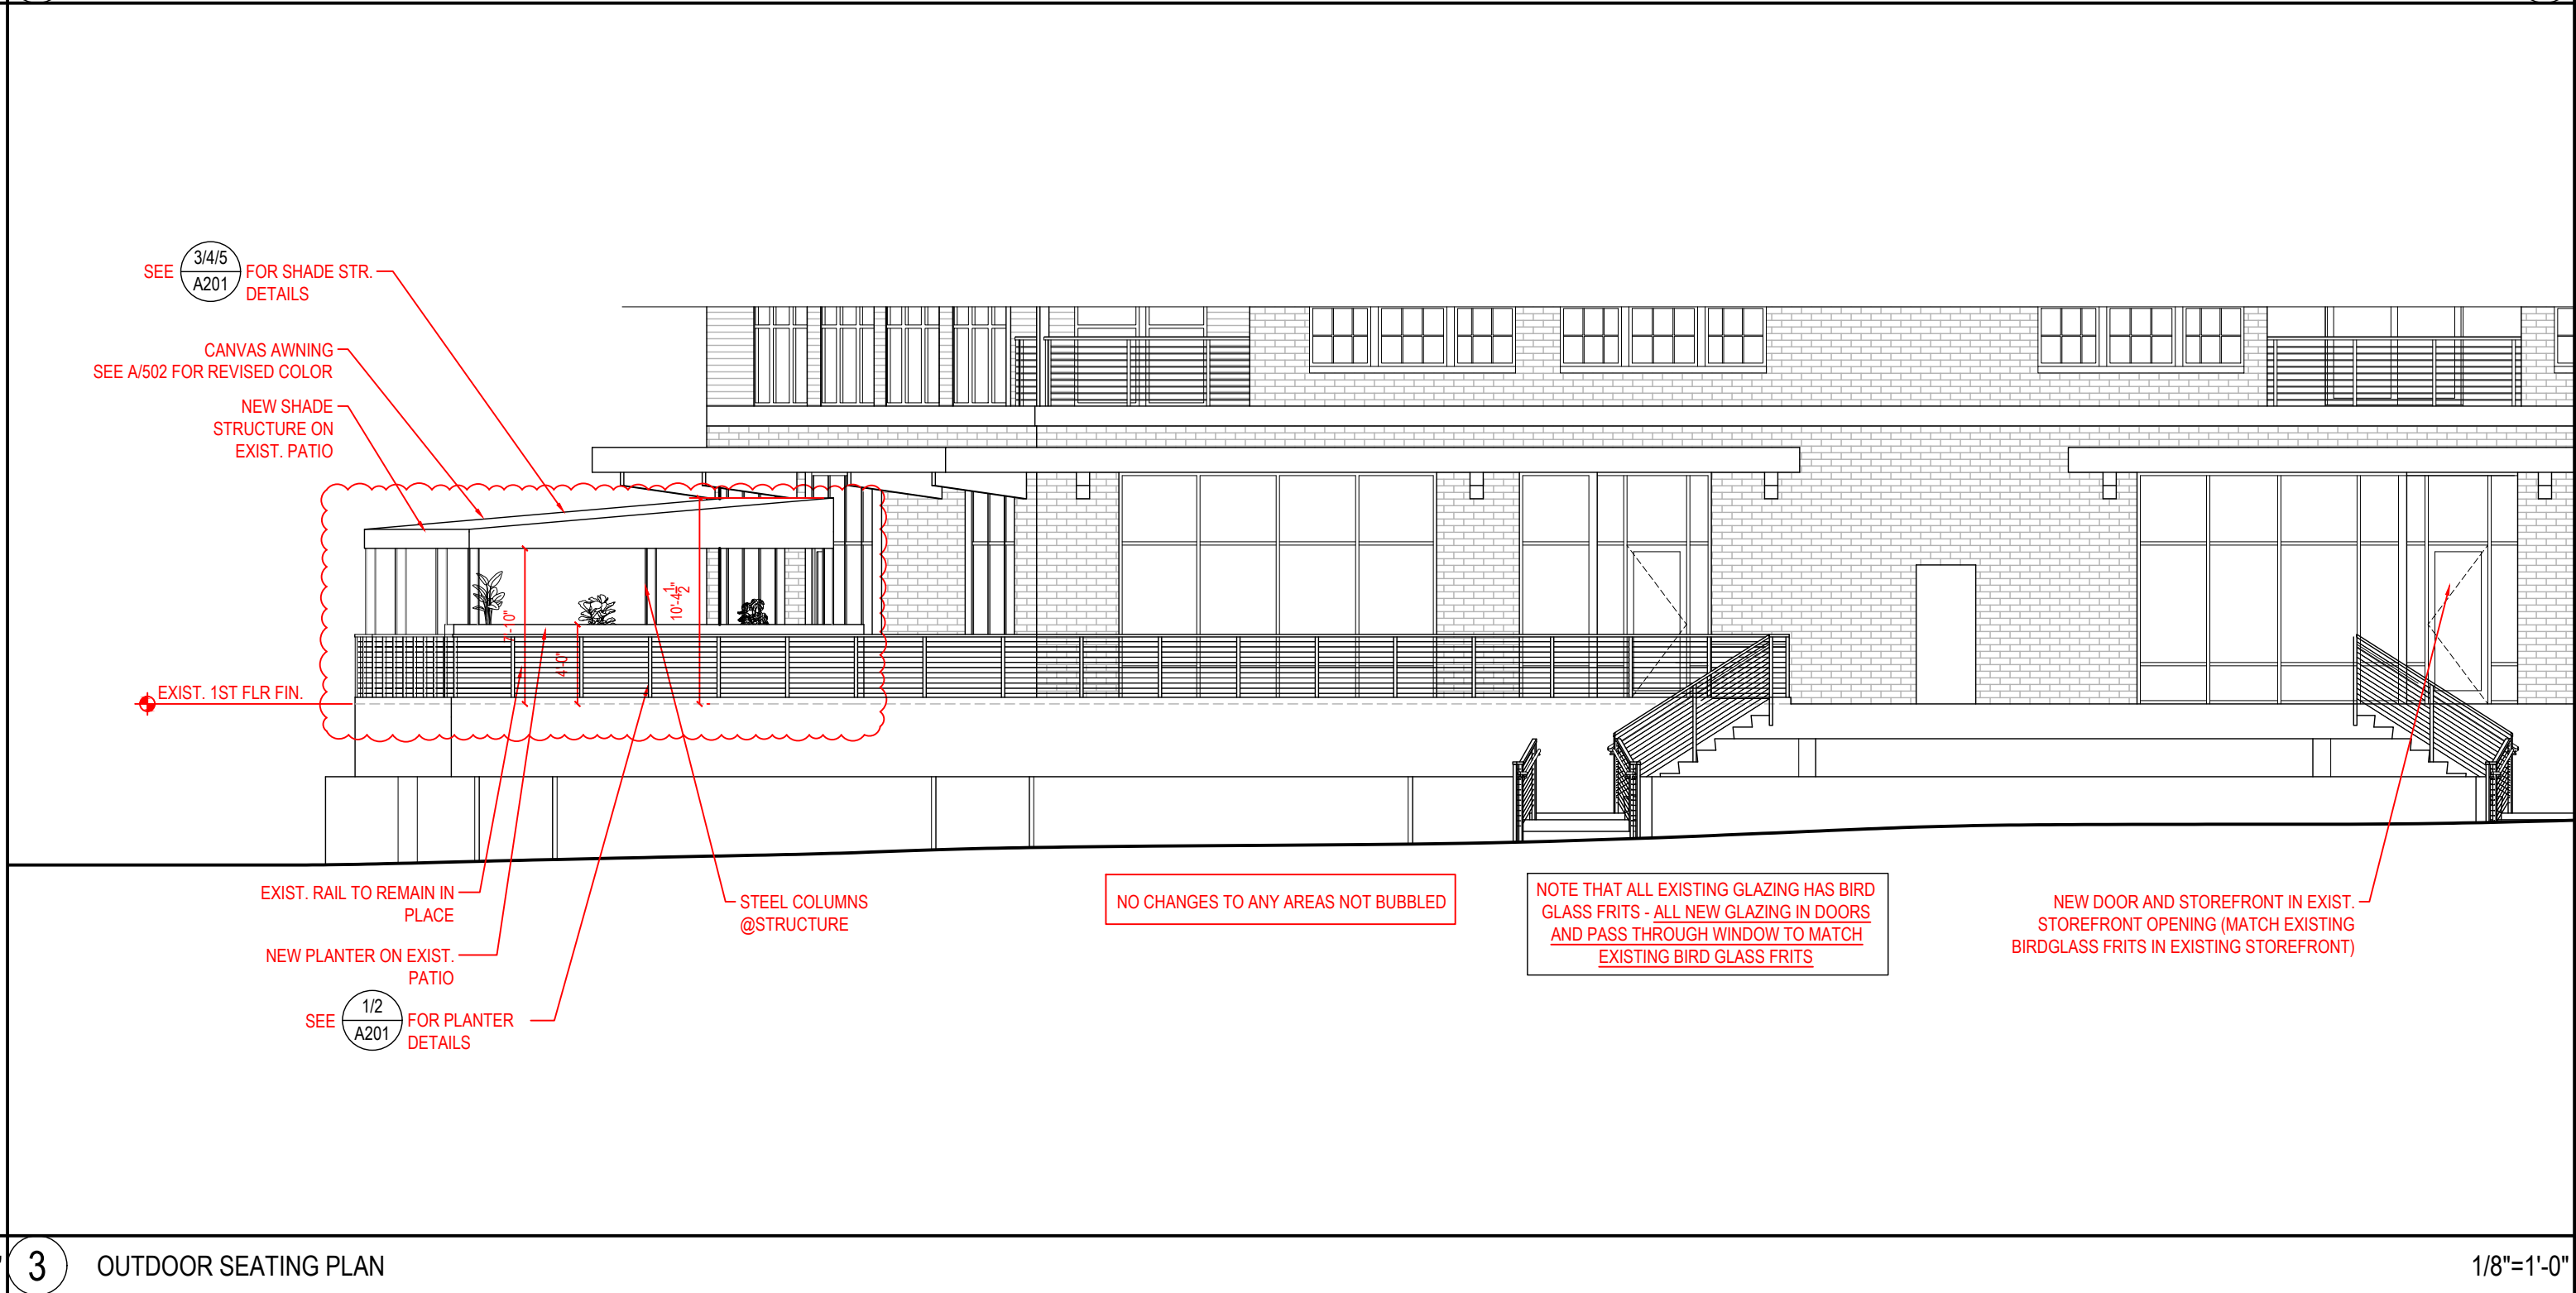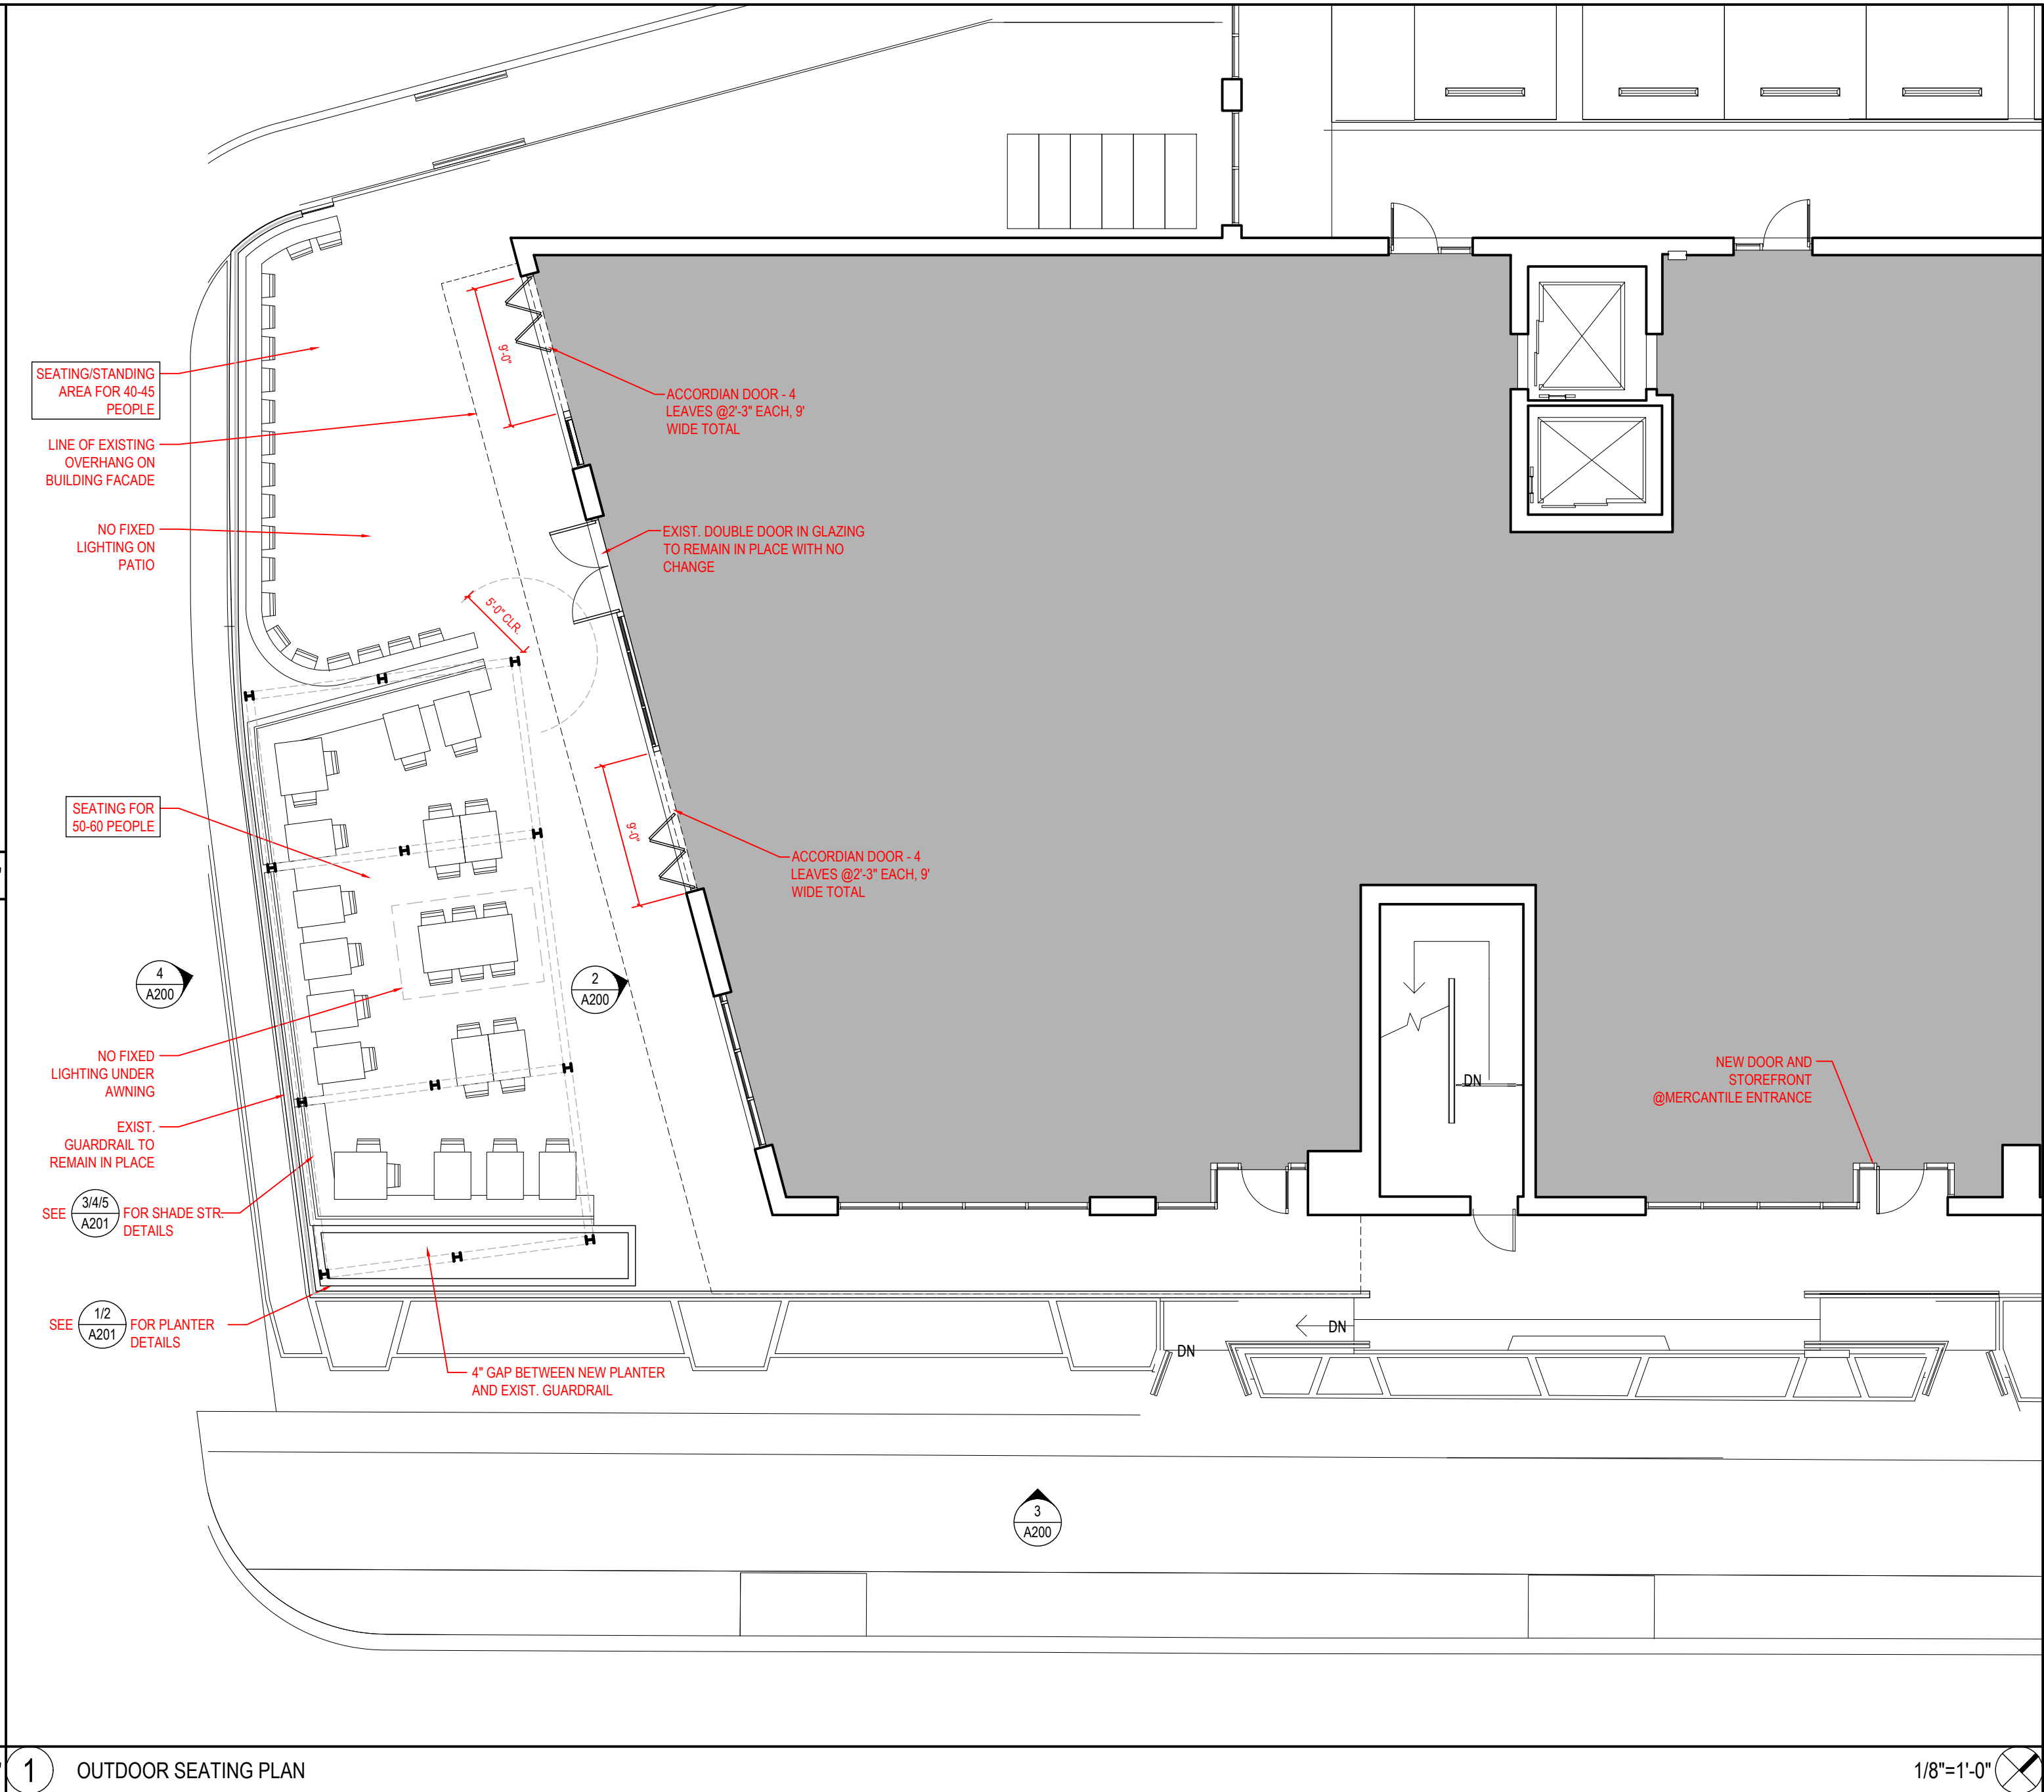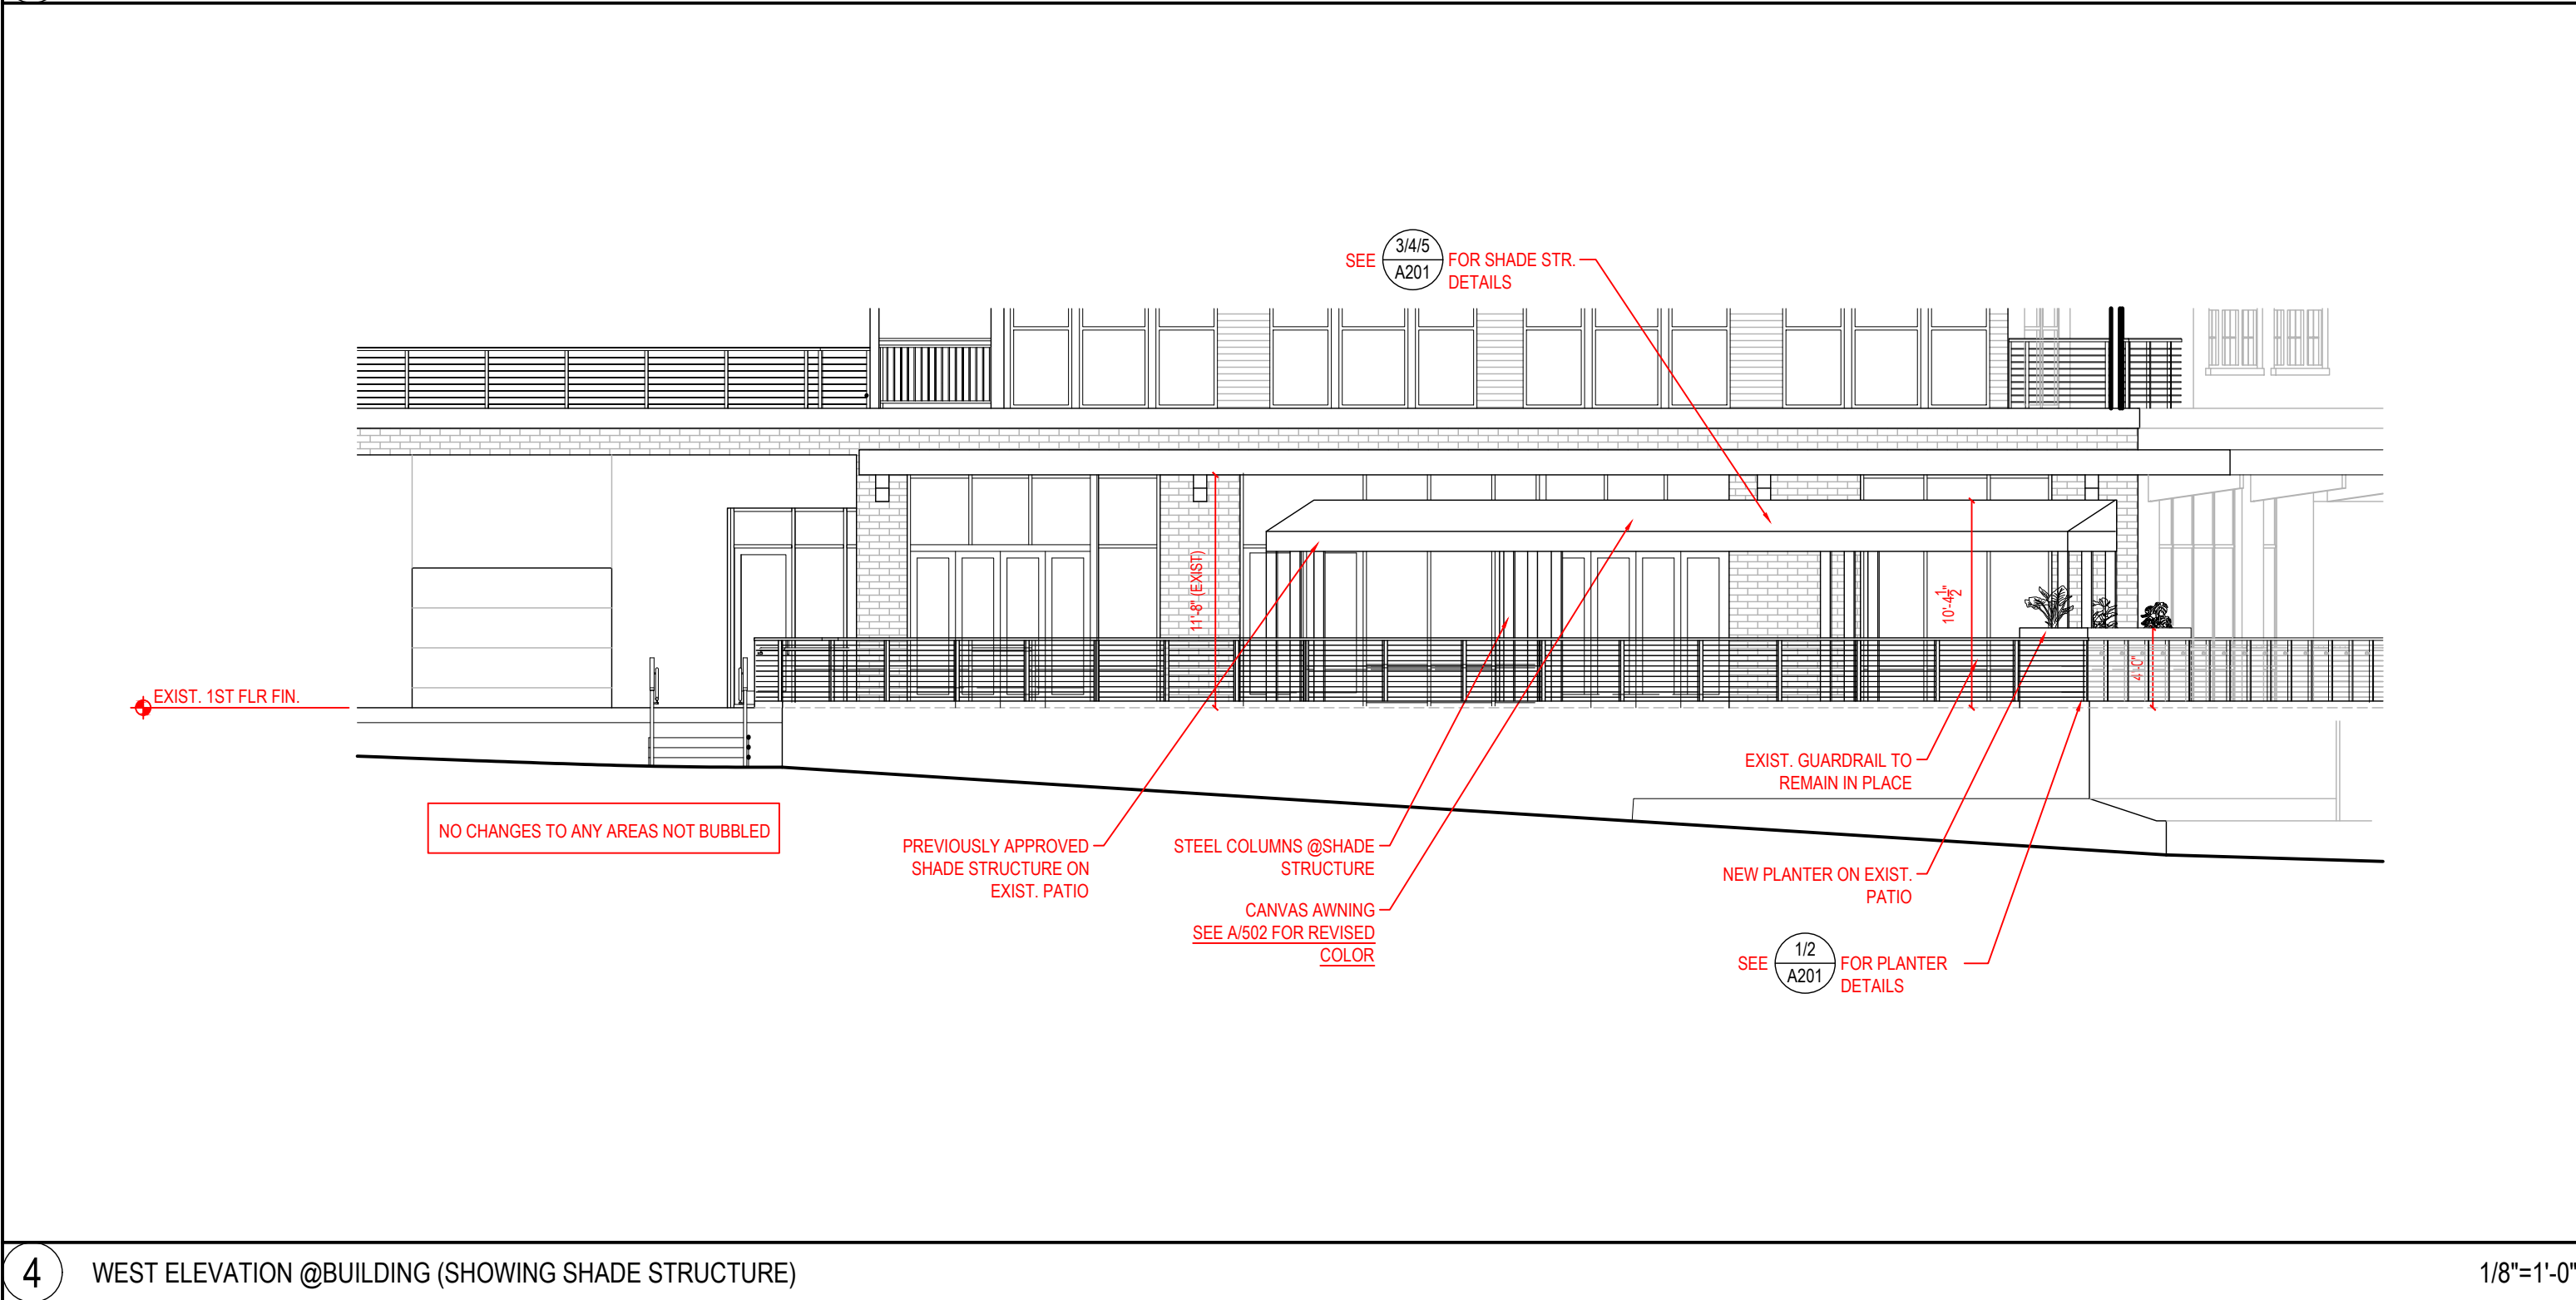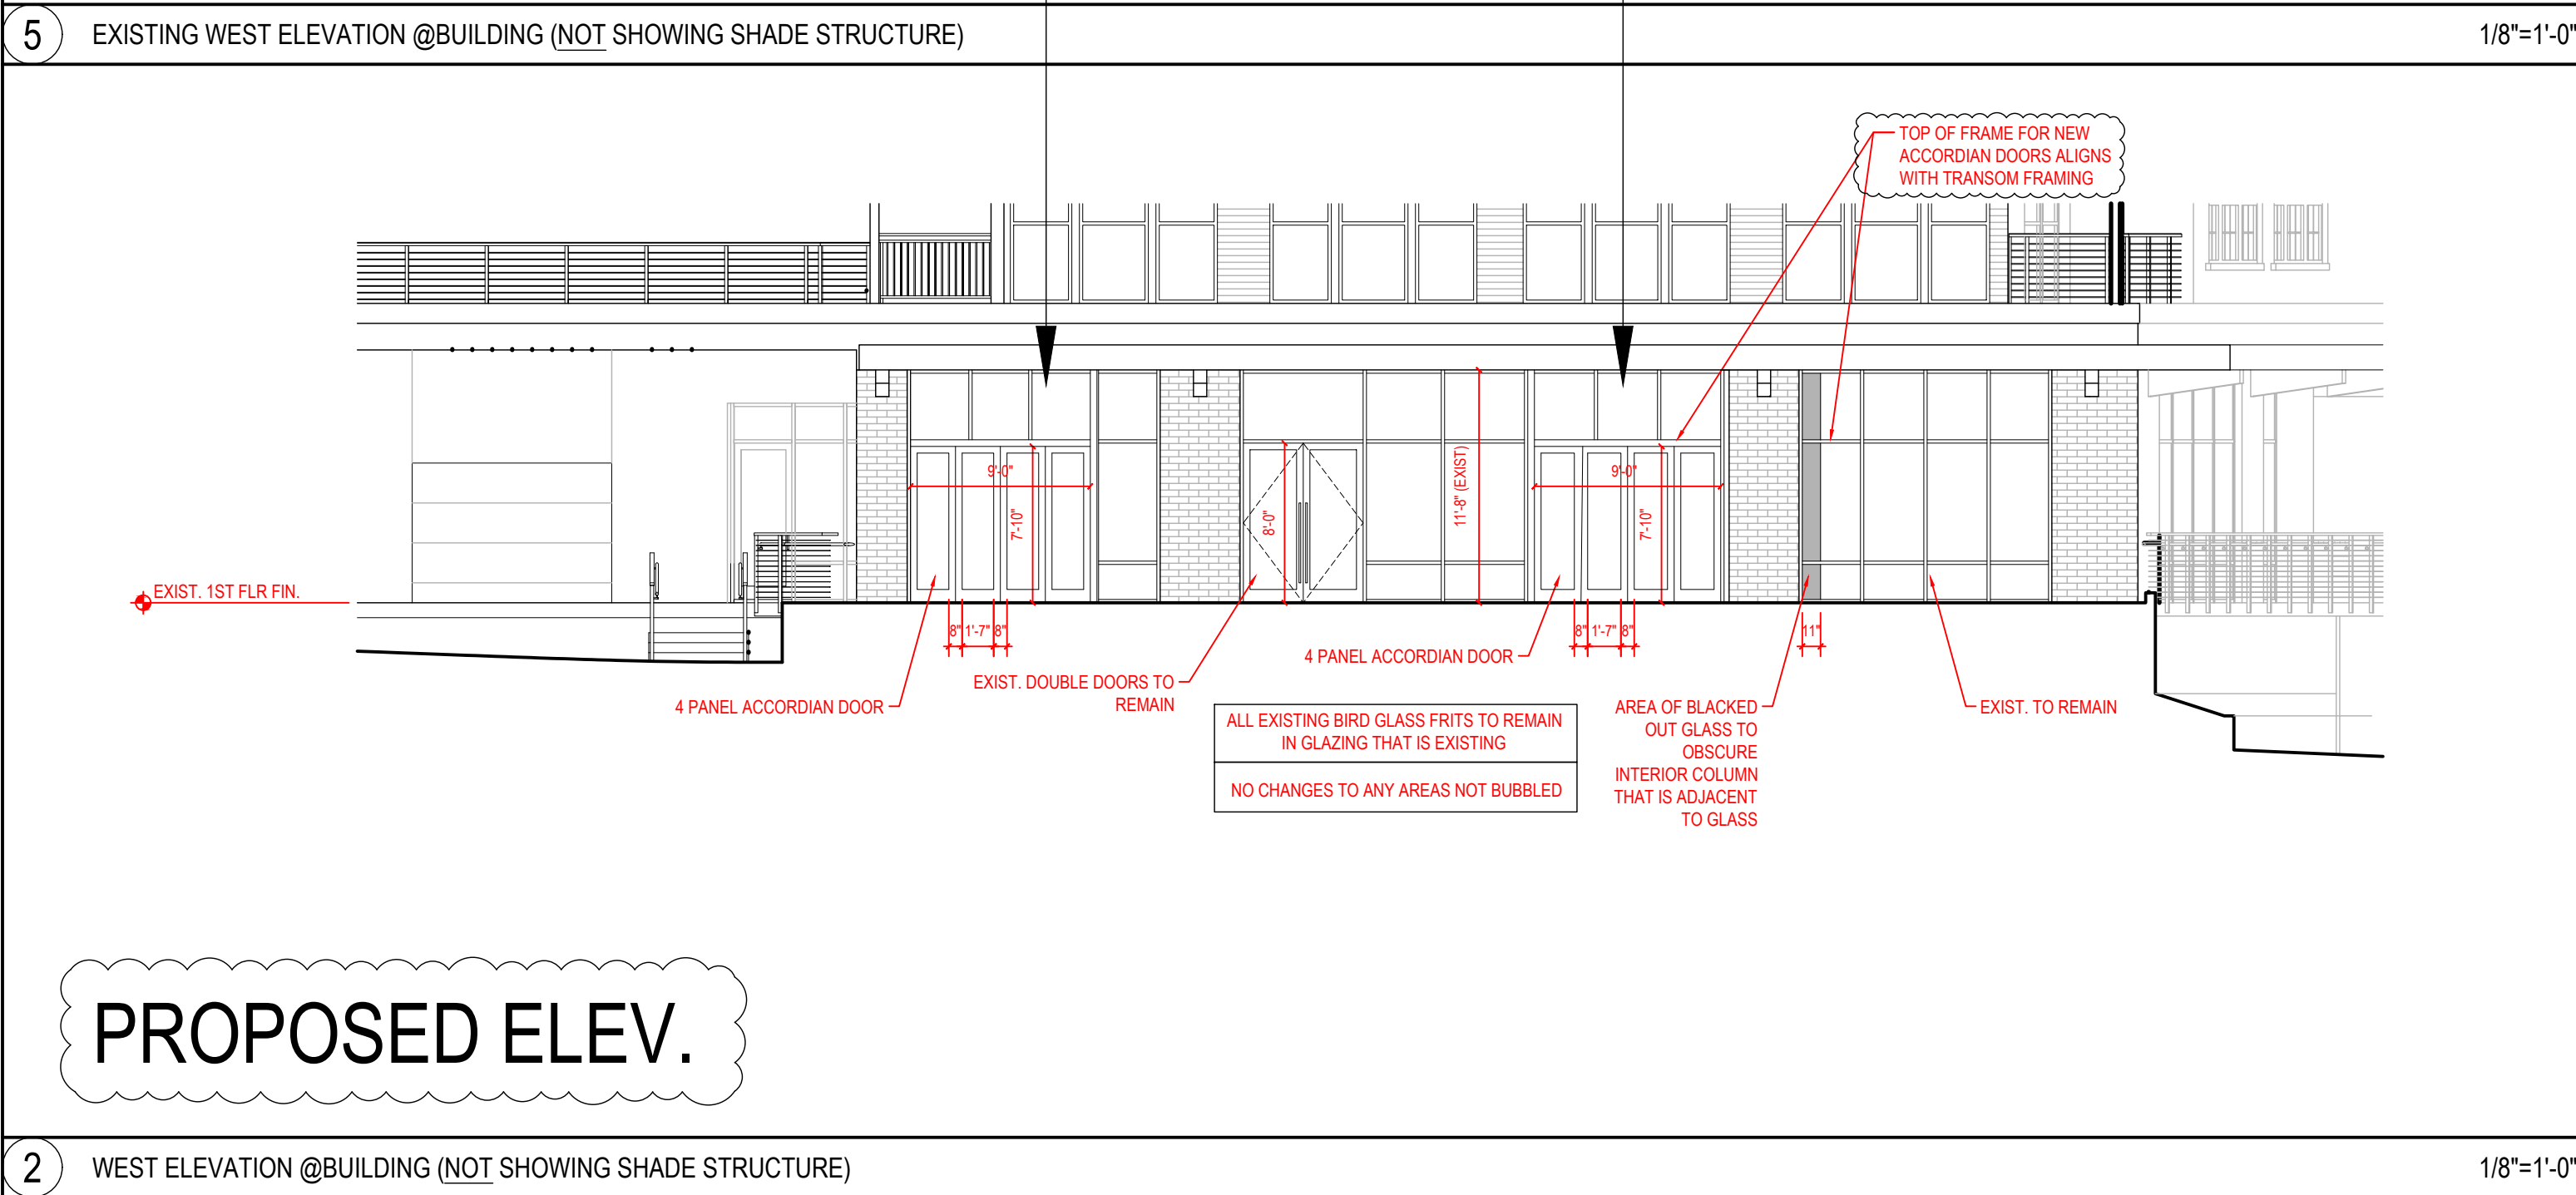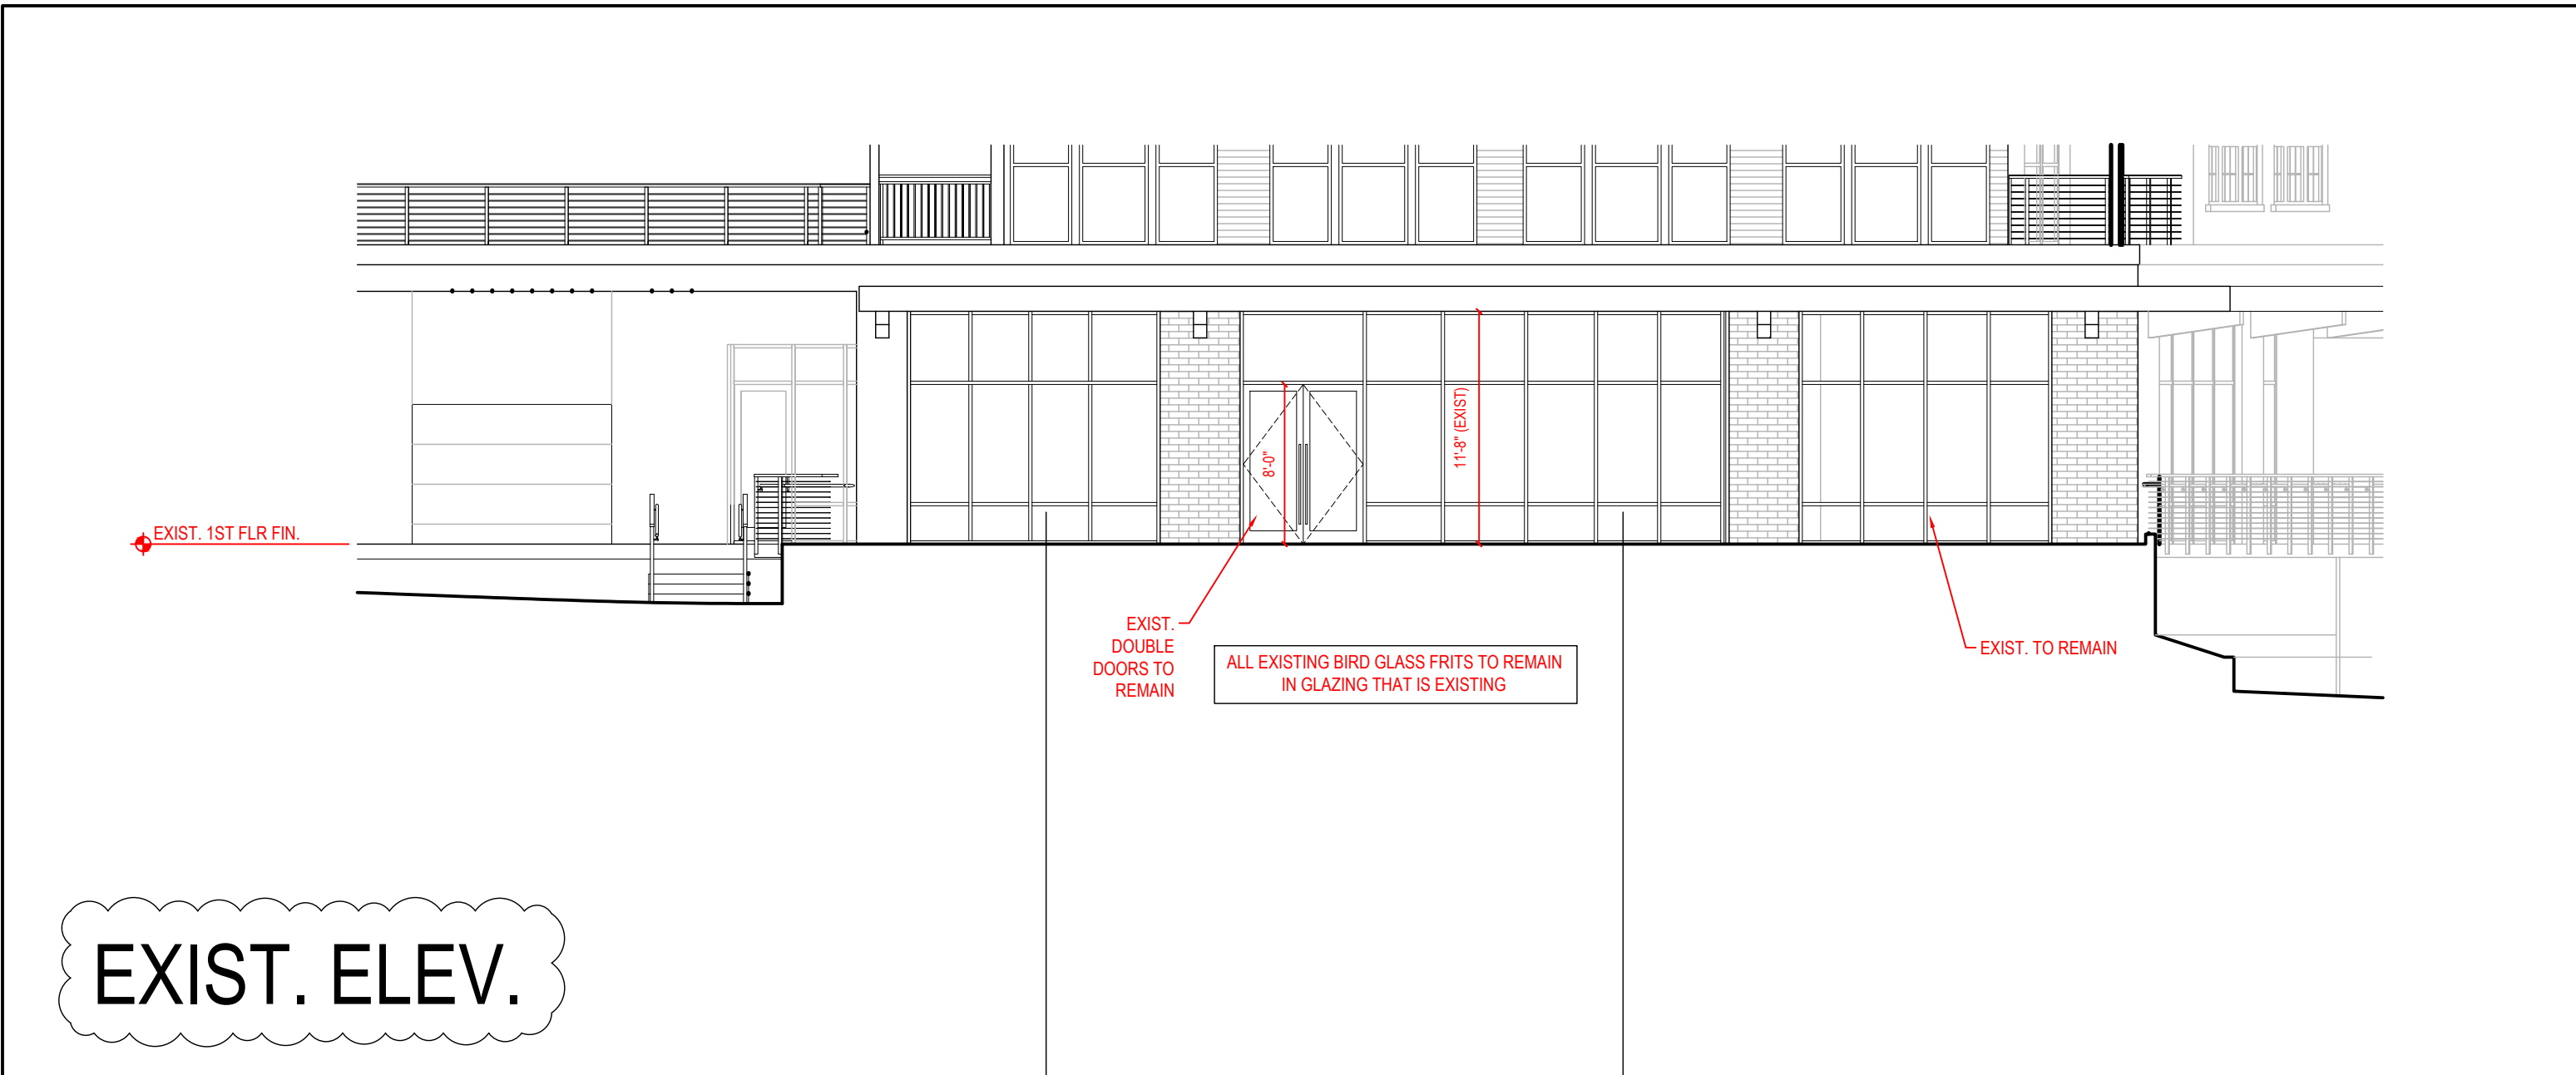





Success by Design

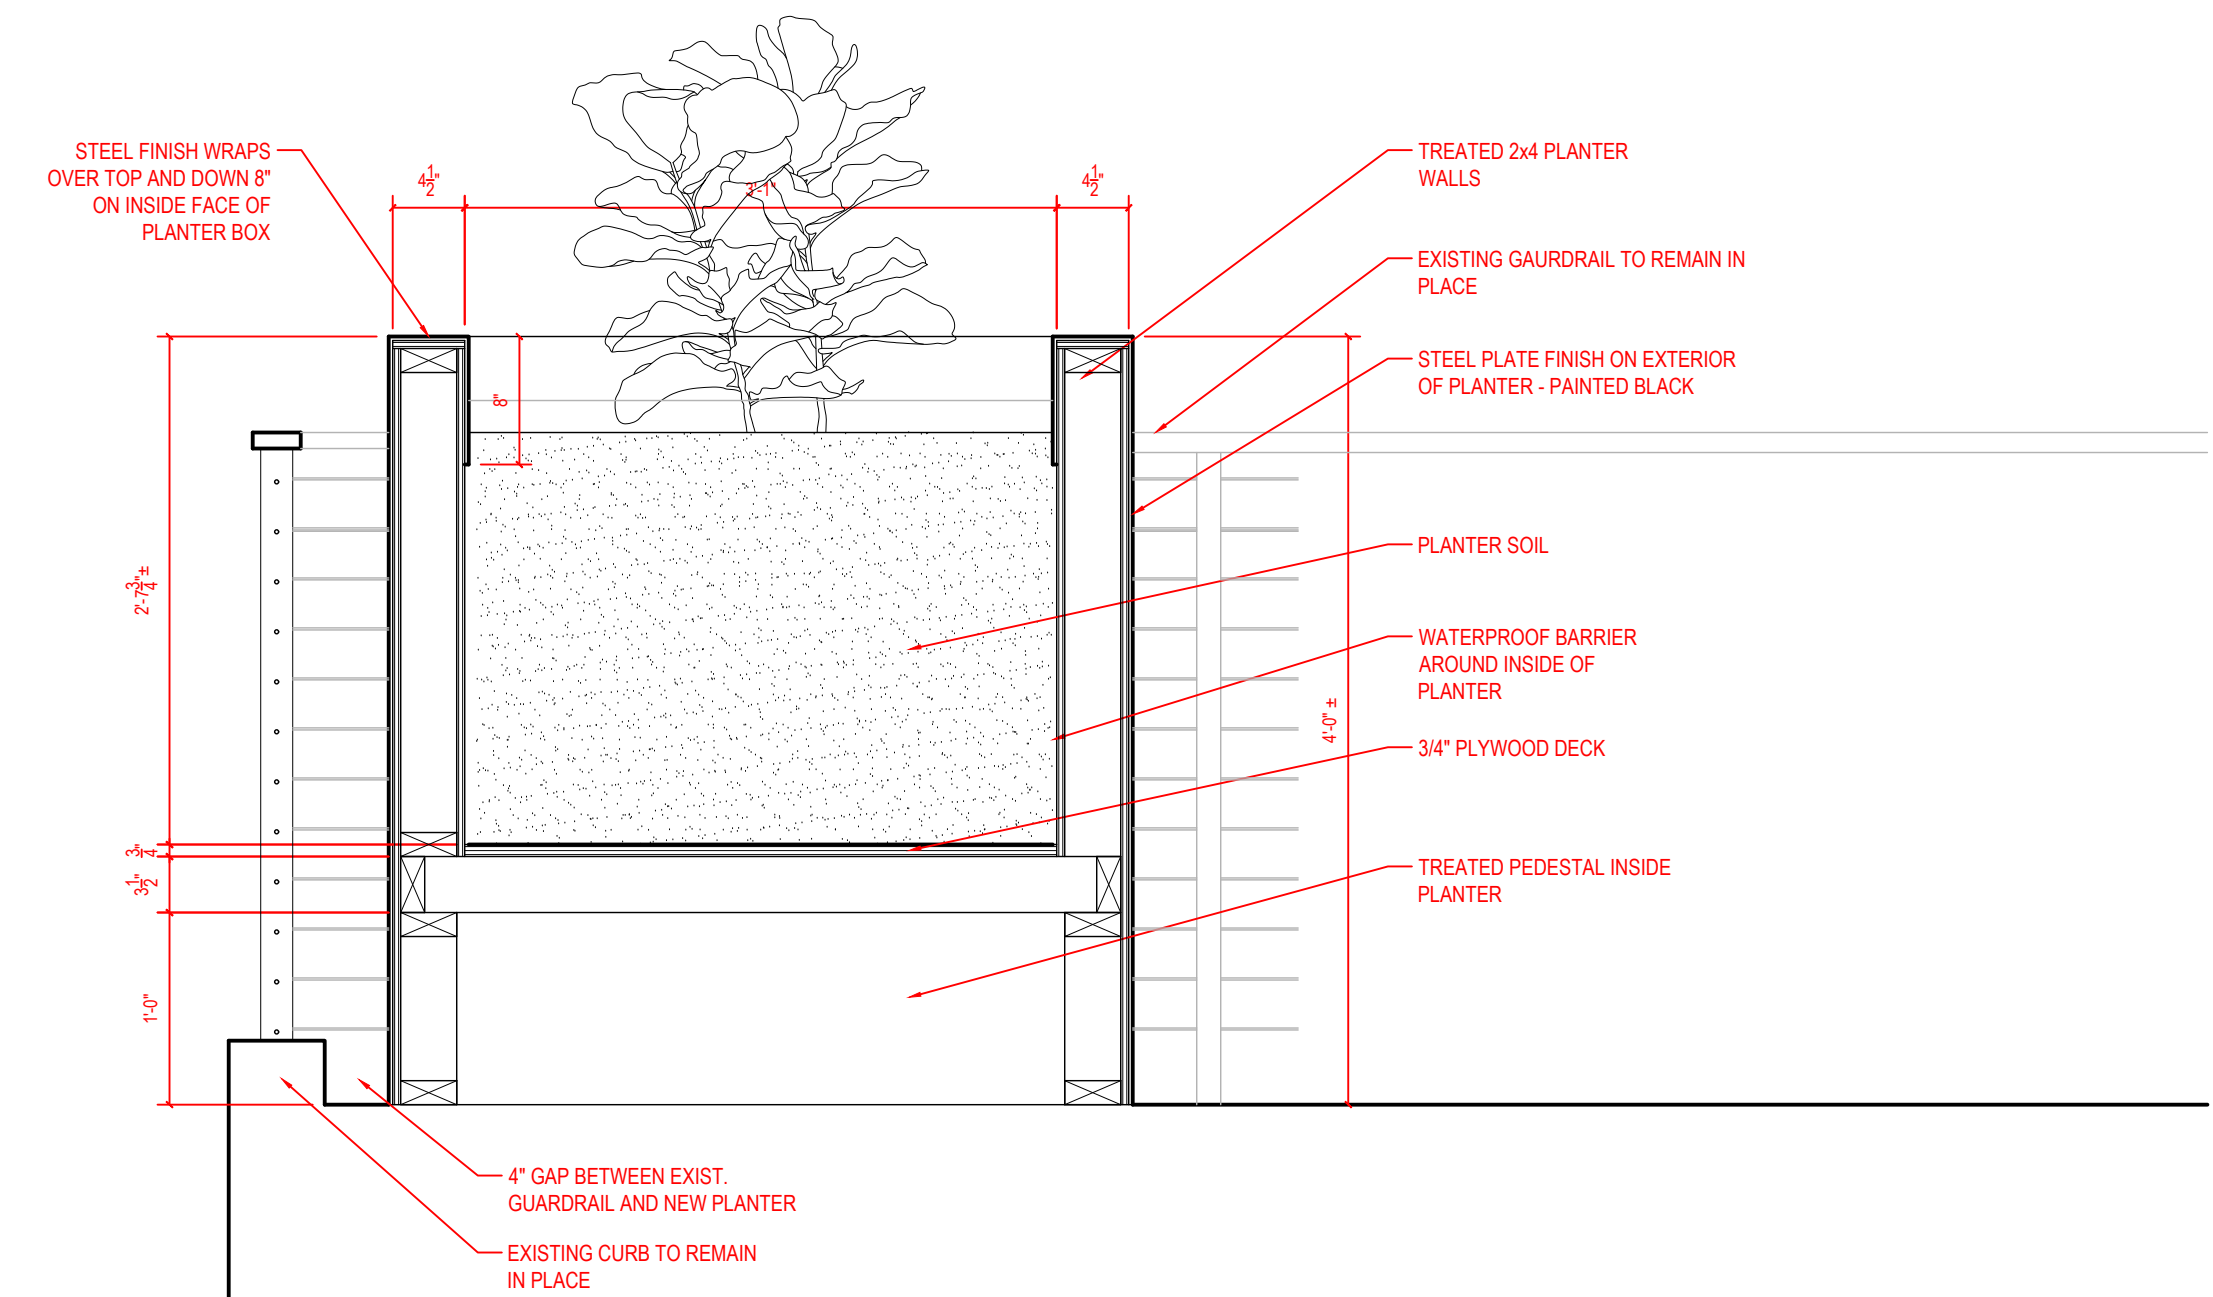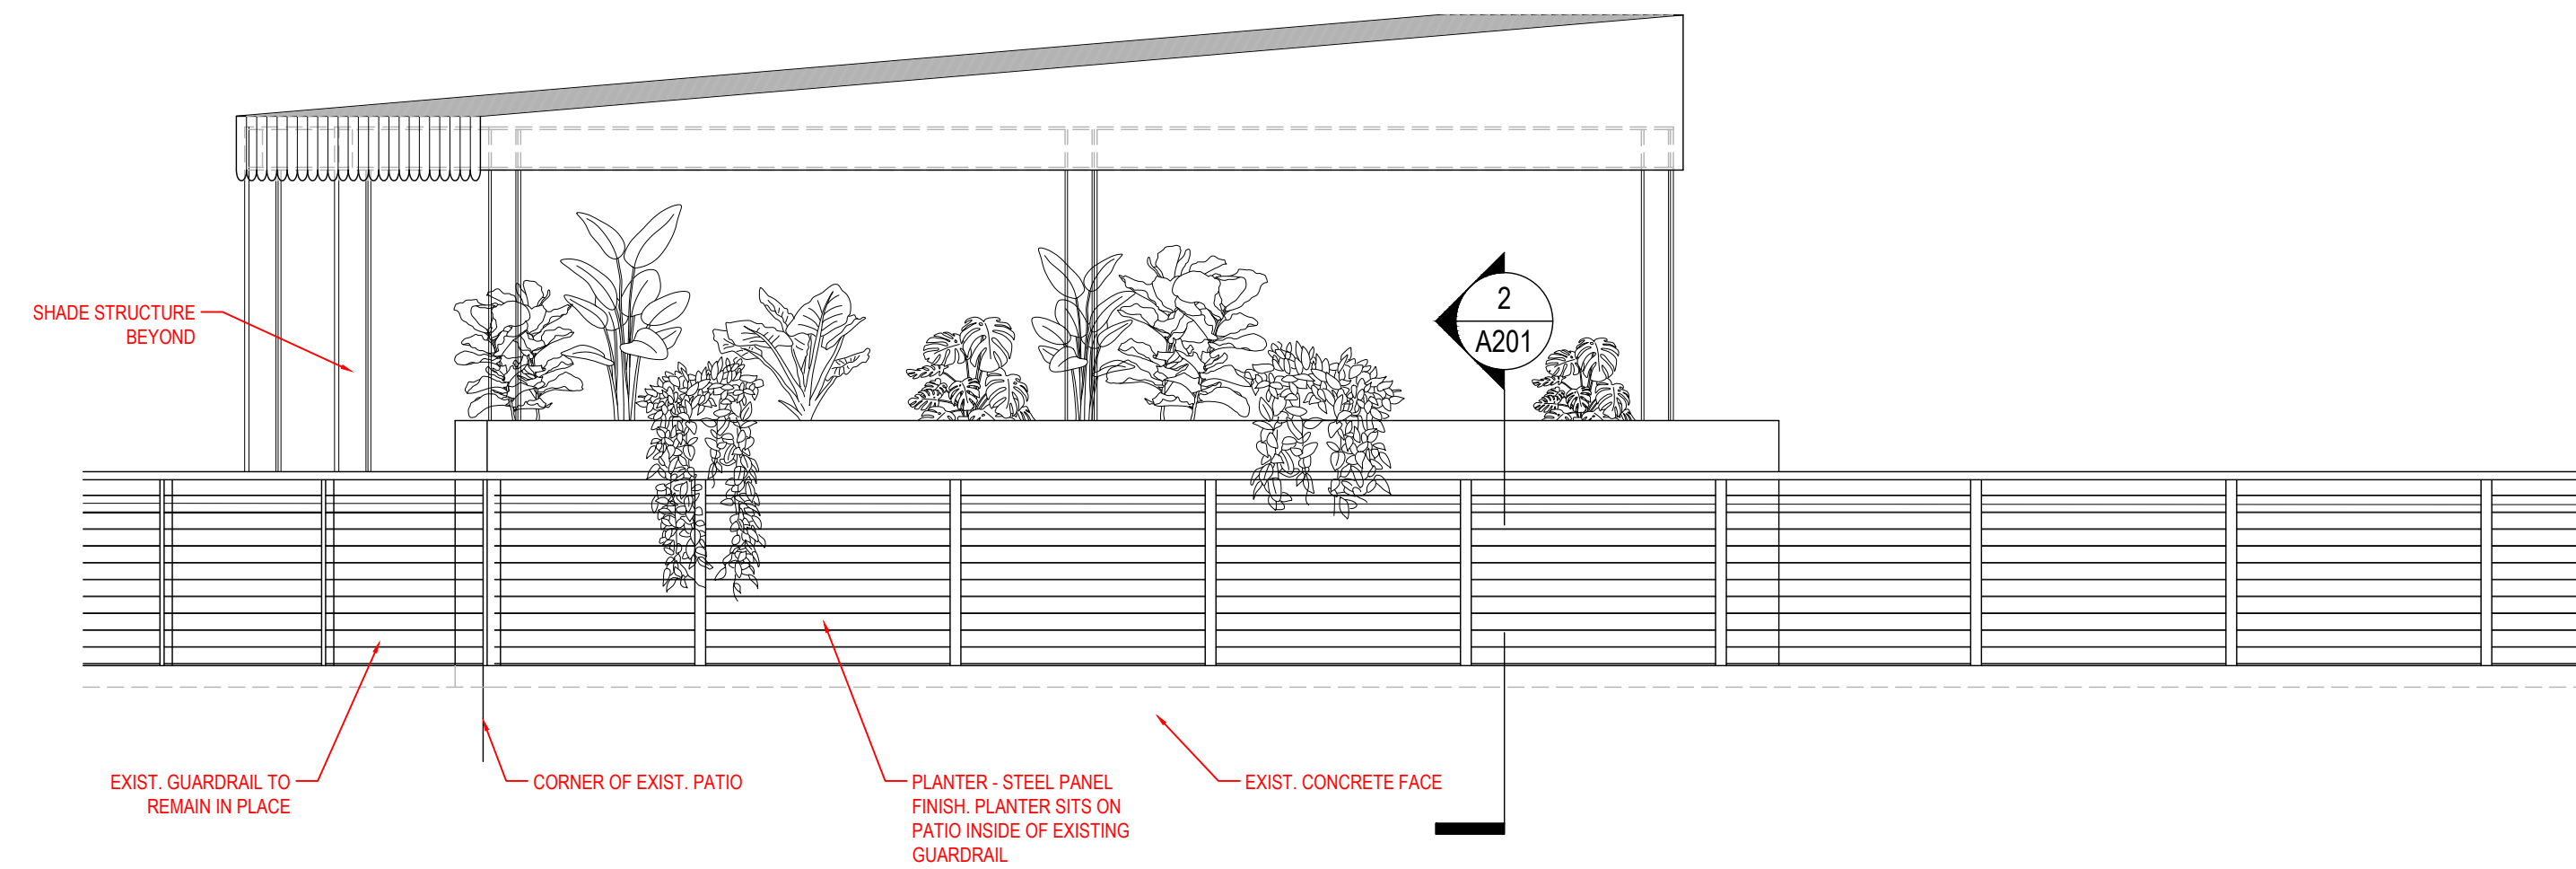


1 WEST ELEVATION @BUILDING (NOT SHOWING SHADE STRUCTURE)

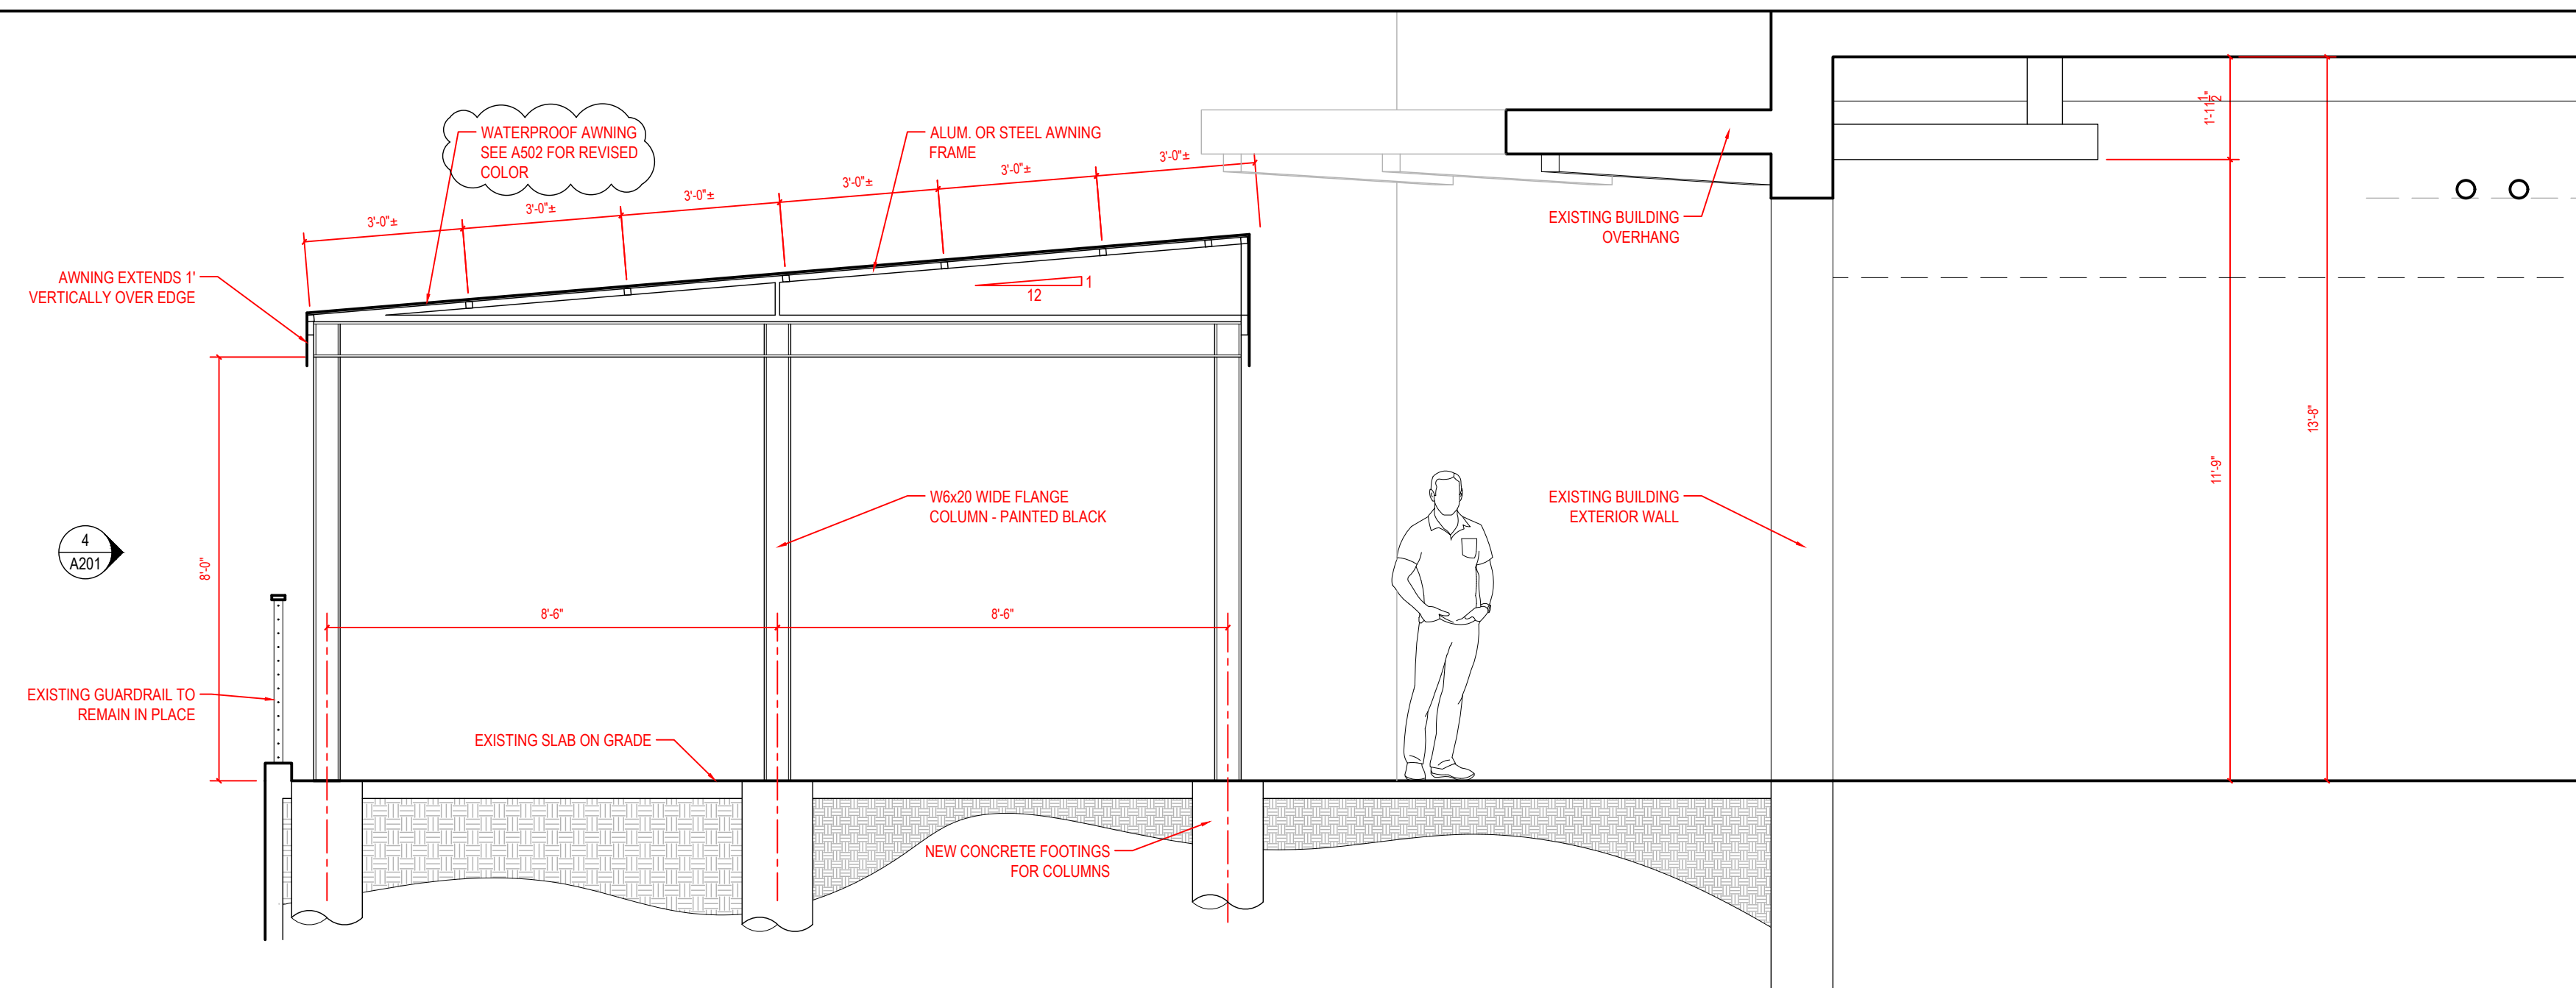

3/8"=1'-0" **2** WEST ELEVATION @BUILDING (NOT SHOWING SHADE STRUCTURE)

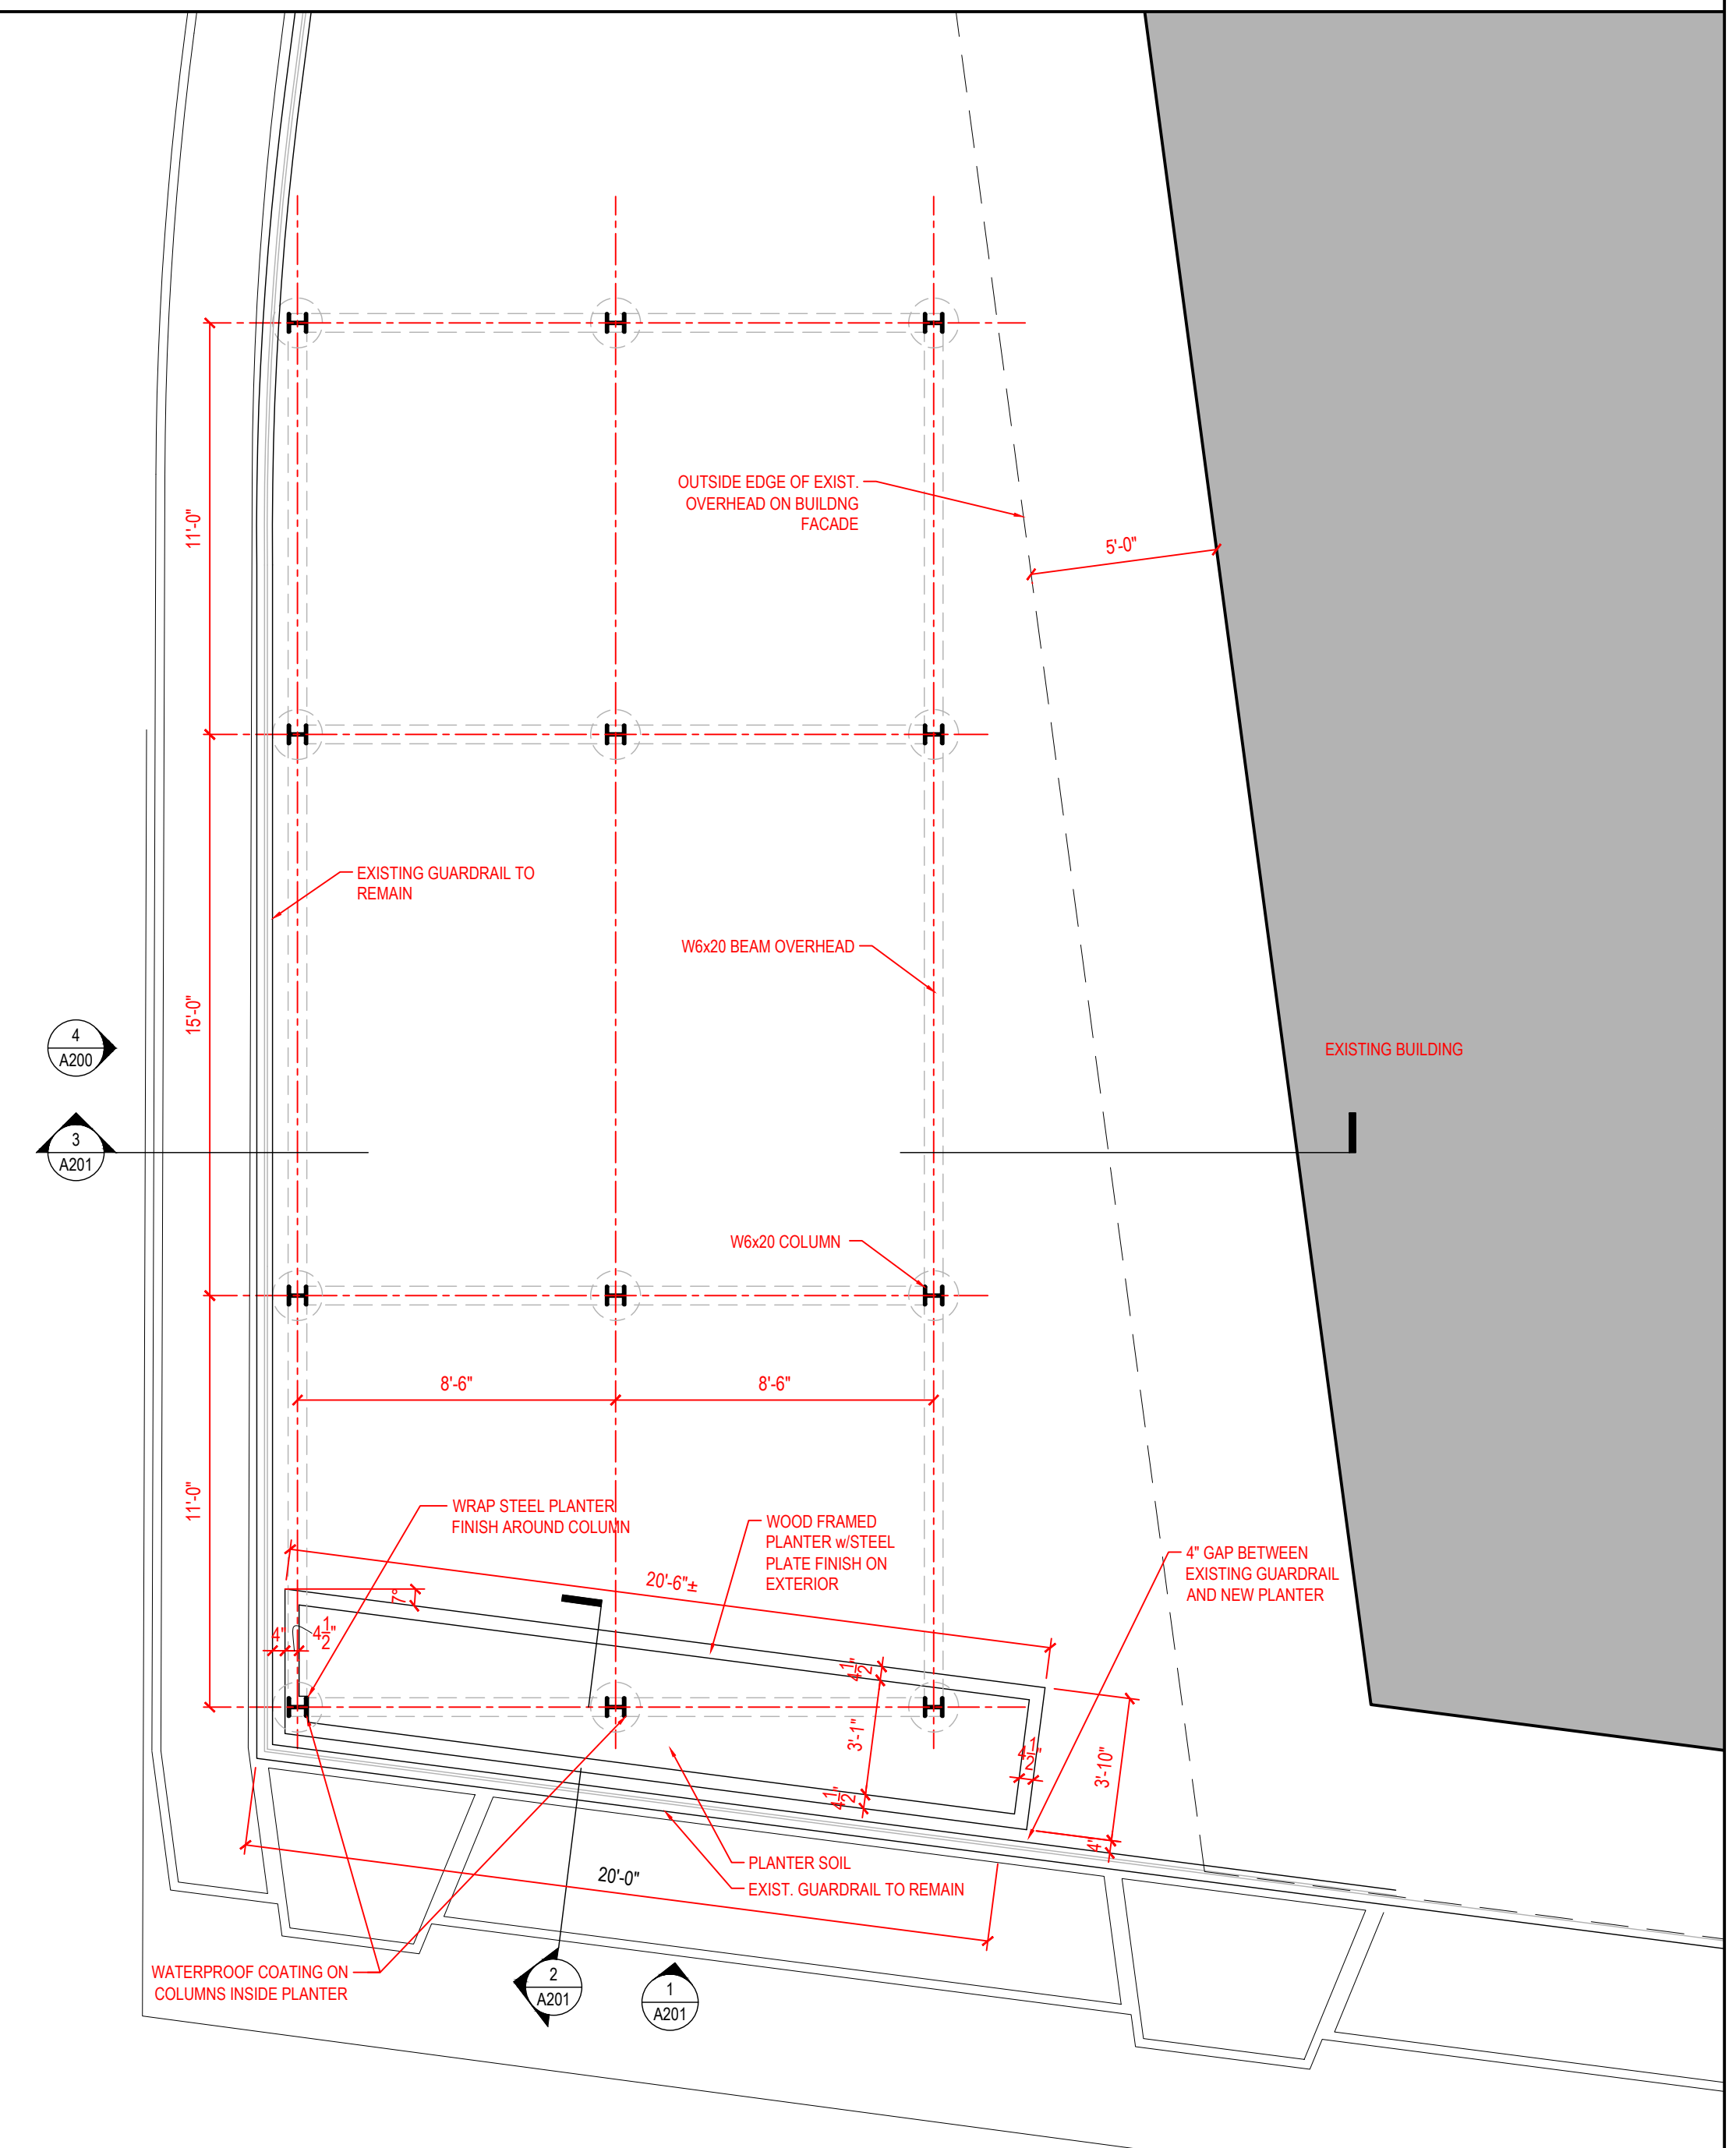

3 WEST ELEVATION @BUILDING (NOT SHOWING SHADE STRUCTURE)

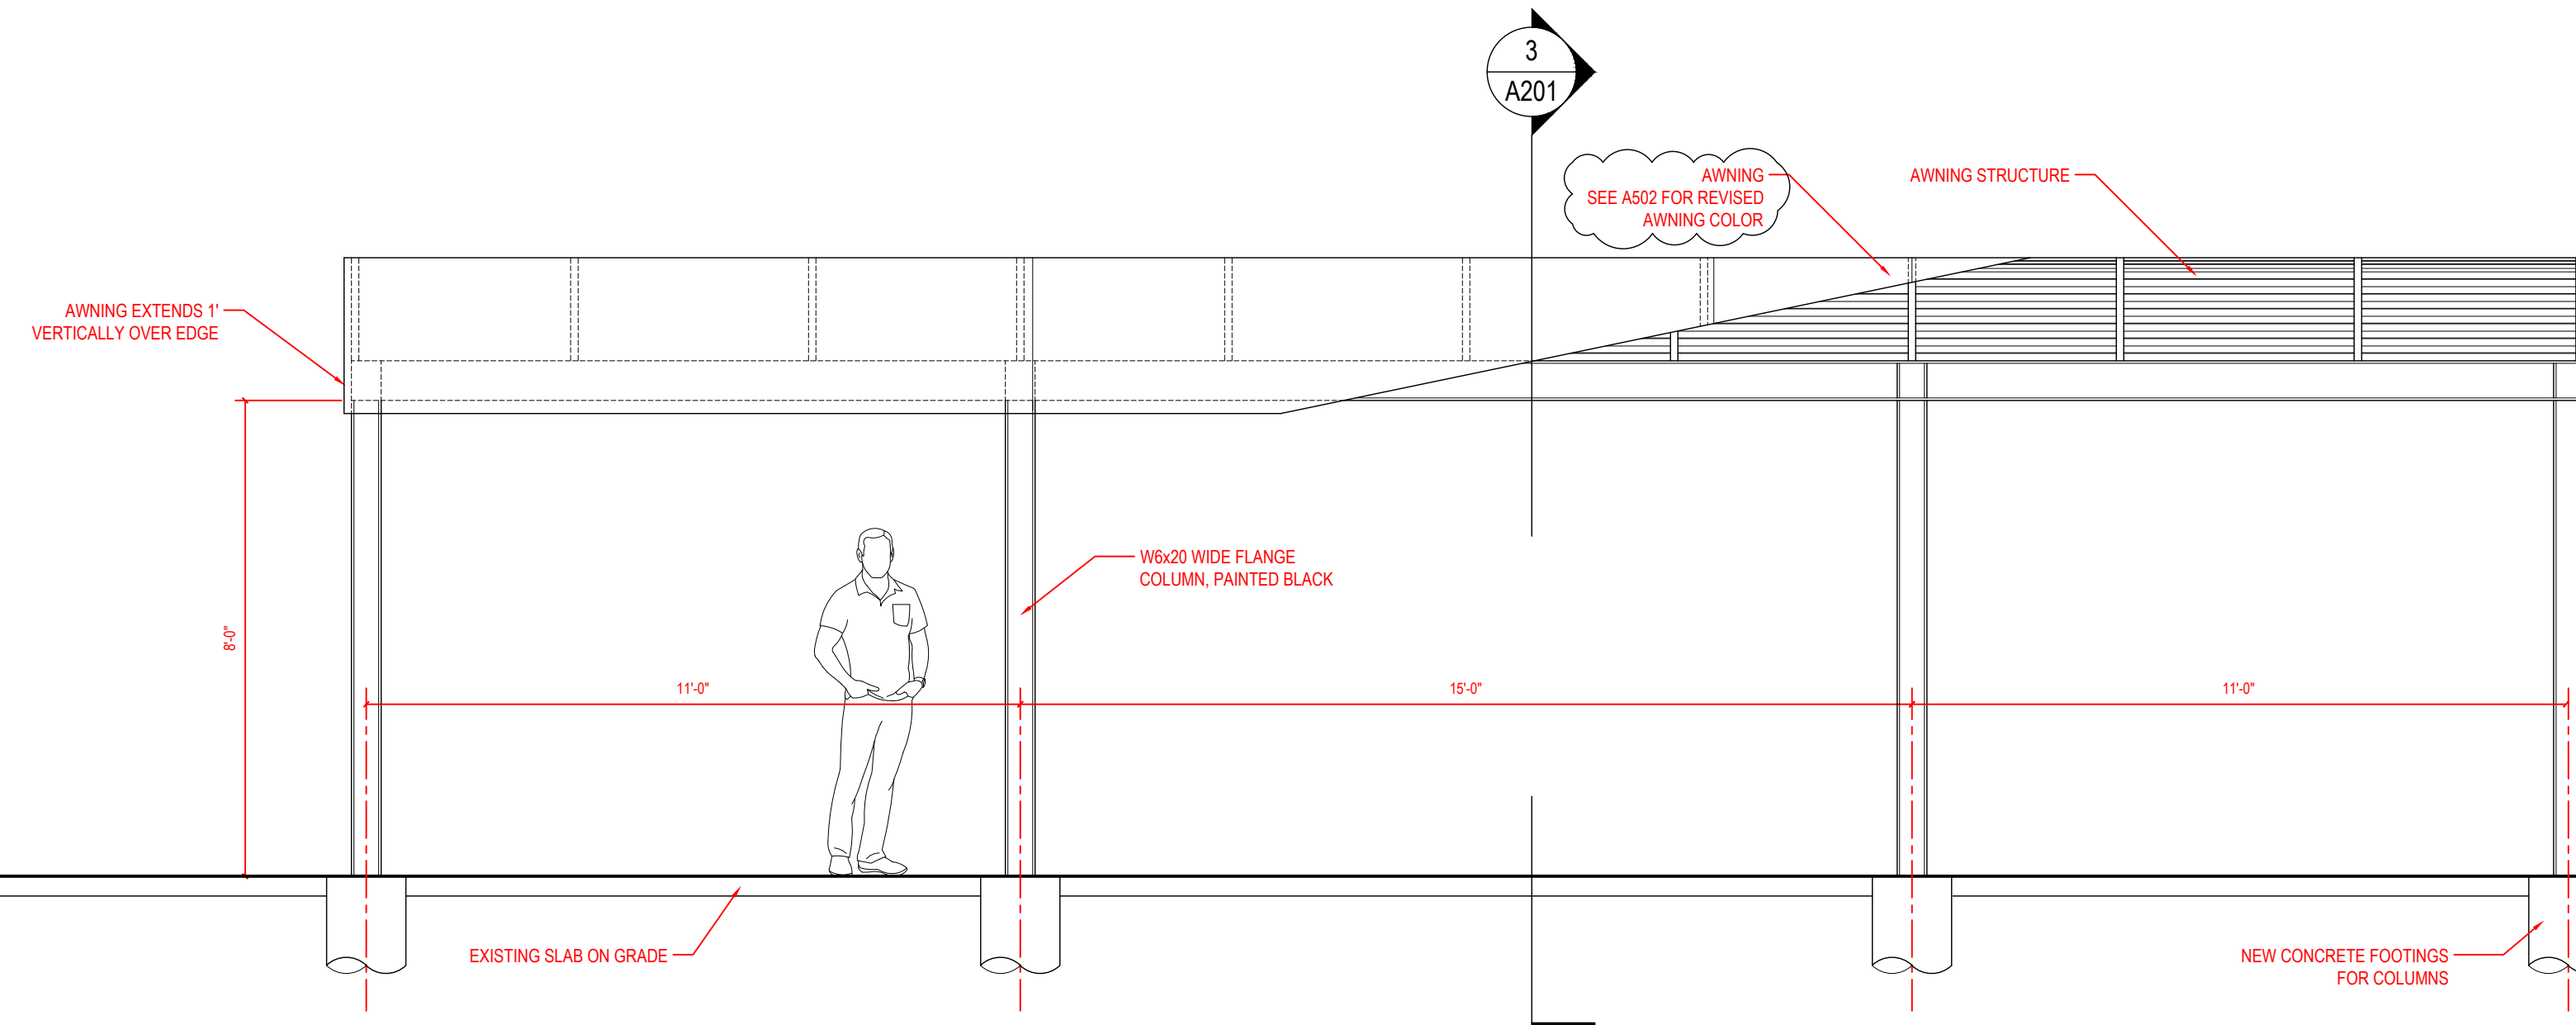

3/8"=1'-0" 5 SHADE STRUCTURE/PLANTER DETAIL PLAN

MINT MARK
RESTAURANT

1874 E. Washington Ave.
Madison, Wisconsin 53704

Project #: 2024.02

Date	Issuance/Revisions
PLAN REVIEW	06-12-23
PLAN REVIEW - REV 1	08-04-23
MINOR ALT	09-05-23
MINOR ALT UPDATE	10-30-23
PLAN REVIEW - UPDATE	11-08-23
PROGRESS UPDATE	11-09-23
CONST. UPDATE 1	01-02-24
MINOR ALT	01-29-24

SHADE STRUCTURE AND PLANTER

A201