### URBAN DESIGN COMMISSION Project # REVIEW AND APPROVAL Legistar # **Action Requested** DATE SUBMITTED: Informational Presentation Initial Approval and/or Recommendation UDC MEETING DATE: ✓ Final Approval and/or Recommendation PROJECT ADDRESS: 仏仏28 ALDERMANIC DISTRICT: 13- Sue Ellingson OWNER/DEVELOPER (Partners and/or Principals) ARCHITECT/DESIGNER/OR AGENT: Knowne 3. Bruce Architect, ILC Jim Carzoran 2607 Monroest Swife 15 Madison, WI <del>5370</del>1 53711 CONTACT PERSON: Randy Bruce Address: Phone: Fax: E-mail address: vbruce(a) Knothebruce.com TYPE OF PROJECT: (See Section A for:) Planned Unit Development (PUD) General Development Plan (GDP) Specific Implementation Plan (SIP) Winor attention Planned Community Development (PCD) General Development Plan (GDP) Specific Implementation Plan (SIP) Planned Residential Development (PRD) New Construction or Exterior Remodeling in an Urban Design District \* (A public hearing is required as well as a fee) School, Public Building or Space (Fee may be required) New Construction or Addition to or Remodeling of a Retail, Hotel or Motel Building Exceeding 40,000 Sq. Ft. Planned Commercial Site (See Section B for:) New Construction or Exterior Remodeling in C4 District (Fee required) (See Section C for:) R.P.S.M. Parking Variance (Fee required) (See Section D for:)

AGENDA ITEM #

\*Public Hearing Required (Submission Deadline 3 Weeks in Advance of Meeting Date)

Where fees are required (as noted above) they apply with the first submittal for either initial or final approval of a project.

Comprehensive Design Review\* (Fee required)
Street Graphics Variance\* (Fee required)

APPLICATION FOR

#### October 16, 2013



Al Martin Urban Design Commission City of Madison 215 Martin Luther King Jr. Blvd PO Box 2985 Madison, Wisconsin 53701

Re:

**UDC Submittal for Minor Alteration** 

2628 Arbor Drive Madison, Wisconsin

Dear Mr. Martin,

Attached are the drawings for a minor alteration for Wingra Shores Apartments, located at 2628 Arbor Drive. The revisions to the previously approved plans are described below and shown on the attached drawings, which are submitted for review and approval by the Urban Design Commission


#### A-2.1 & A-2.2 Elevations:

- The roofline on the Southeast Elevation (along Arbor Drive) has been modified to remove the four parapet elements at the upper roof level. This revision is made to reduce the perceived height of the building and limit the attention that is drawn to the upper level.
- One window on the fourth floor of the Southeast Elevation was removed due to a floor plan revision.

Thank you for your time in reviewing our proposal.

Very Truly Yours,

J./Ralldy Bruce, A/A Managing Member

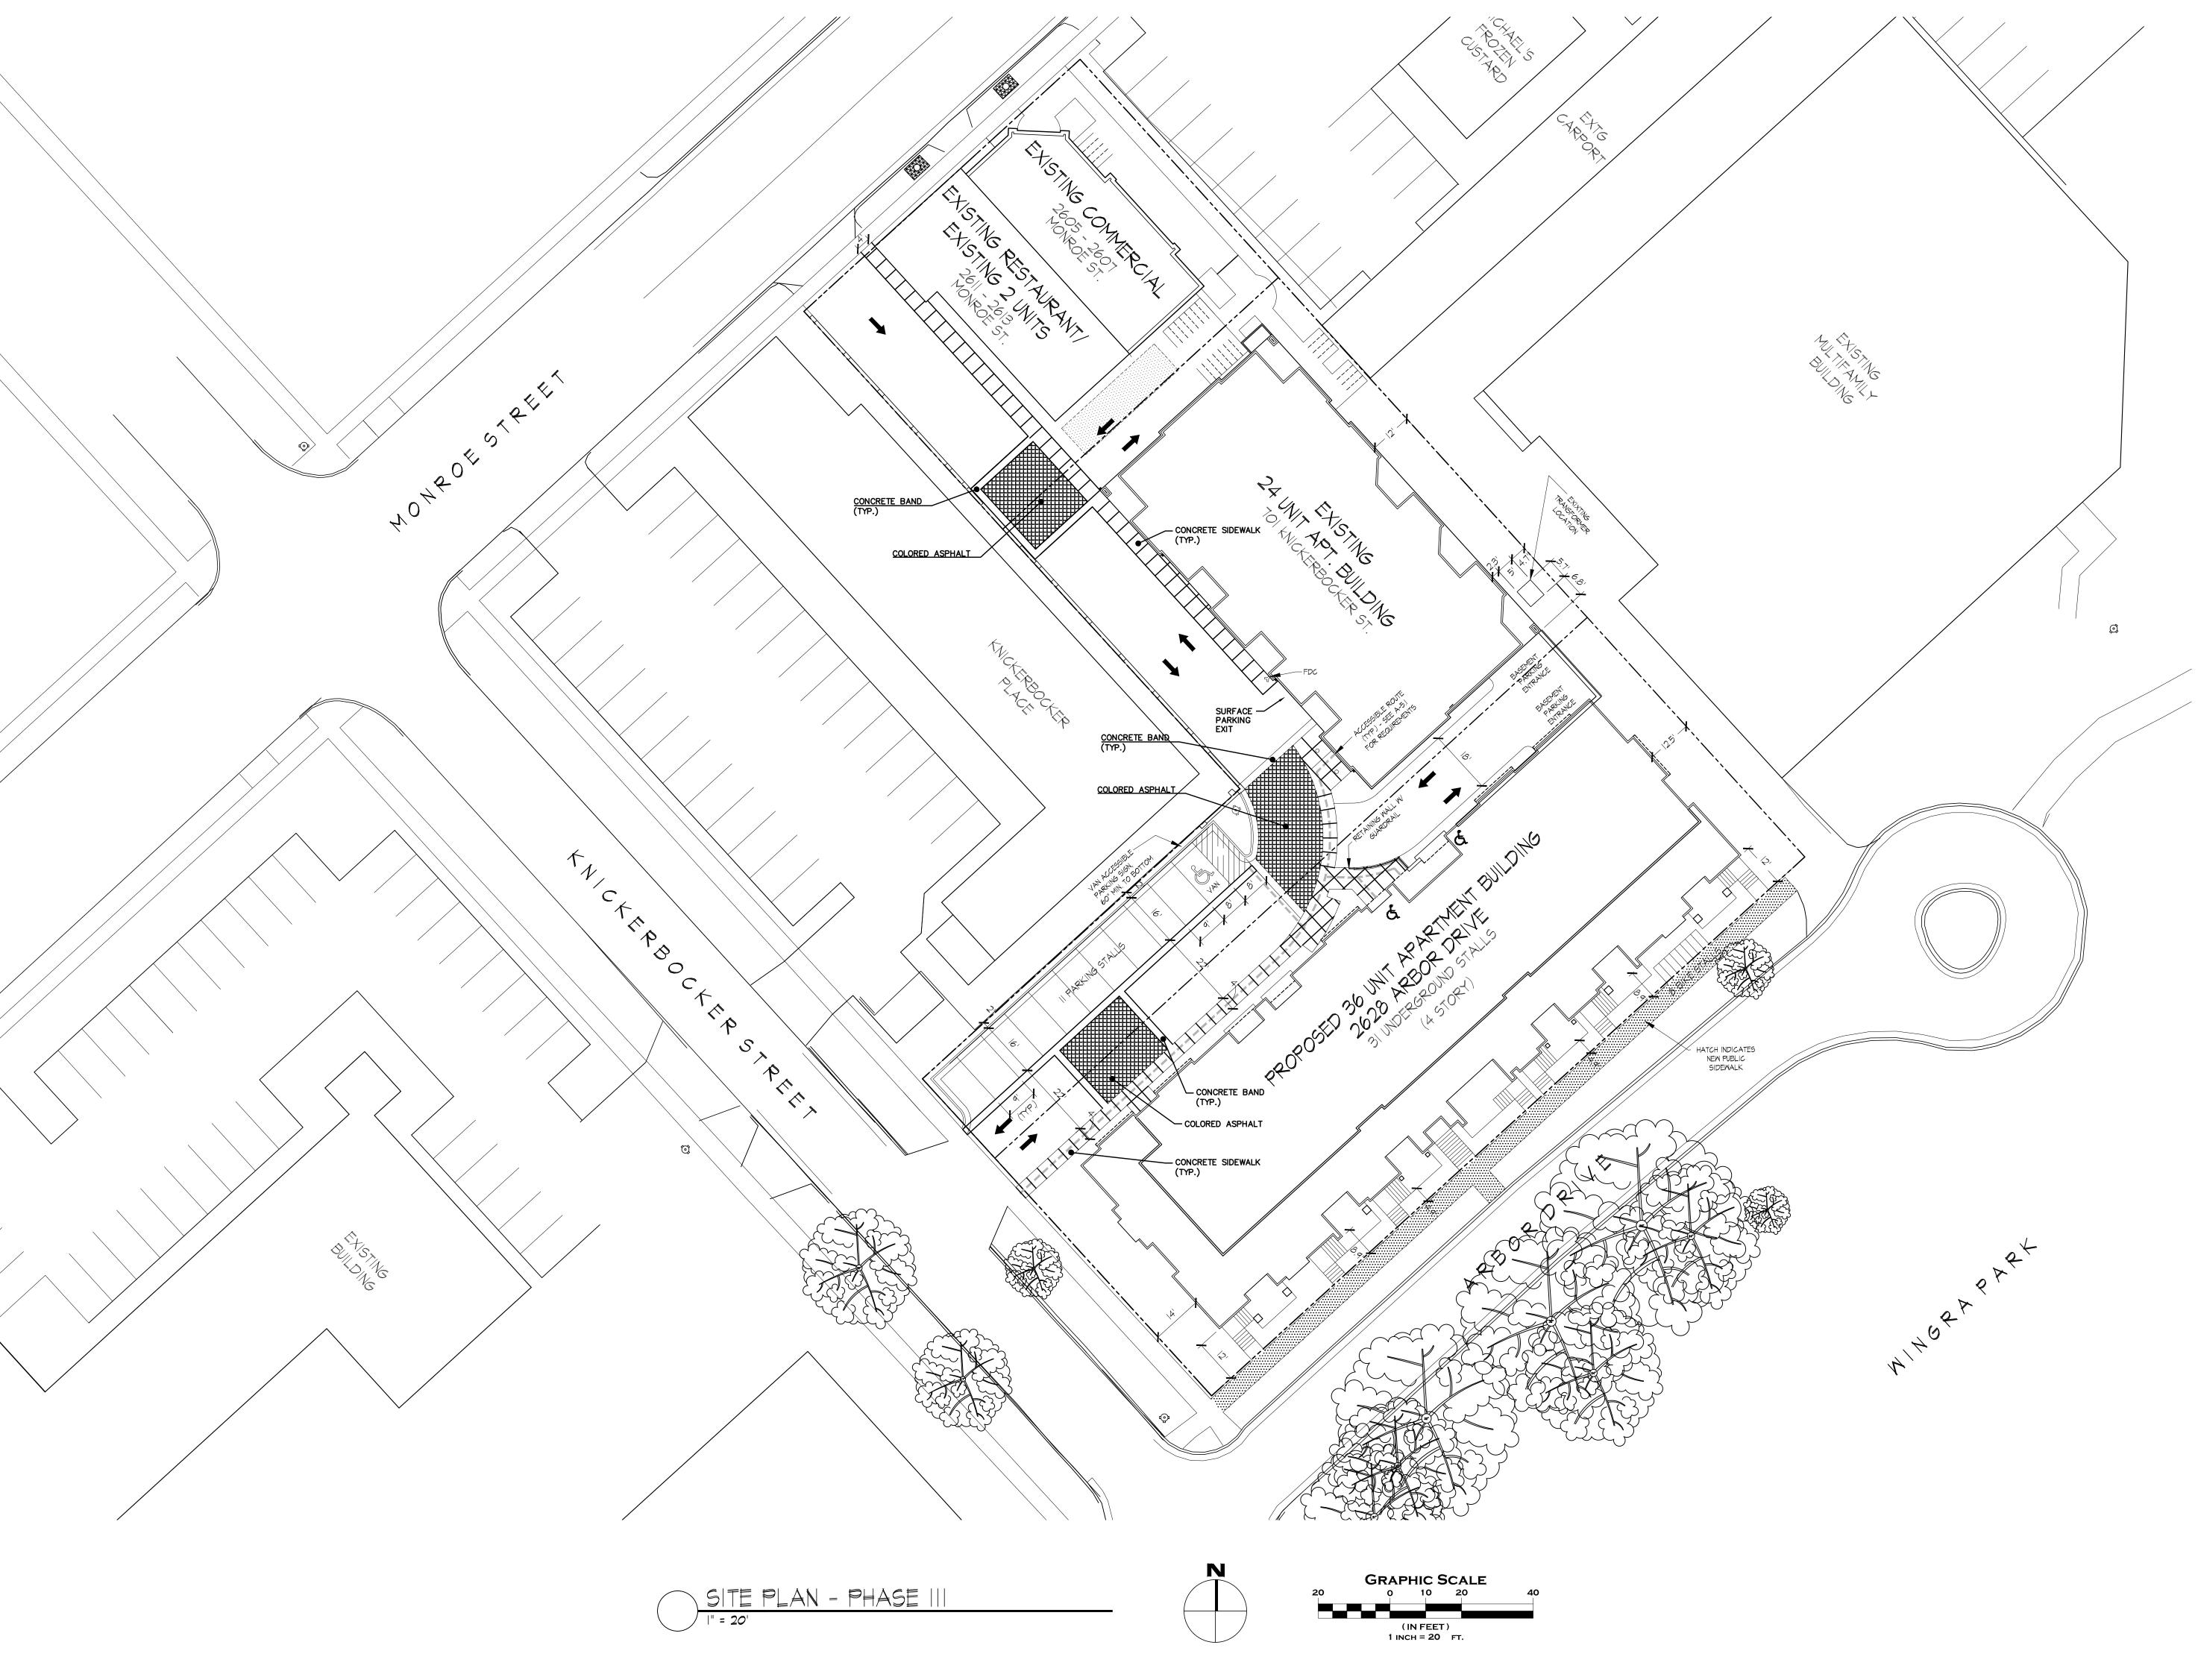

KNOTHE SBRUCE ARCHITECT

> 7601 University Avenue Suite 201 Middleton, Wisconsin 53562 608-836-3690 Fax 836-6934

Consultant

Notes

I. MAXIMUM SLOPE AT ALL ACCESSIBLE WALKS 1:20.
MAXIMUM SLOPE AT ACCESSIBLE RAMPS 1:12. RAMPS
OVERCOMING MORE THAN 6" CHANGE IN ELEVATION TO HAVE
HANDRAILS ON BOTH SIDES. MAXIMUM SLOPE AT ACCESSIBLE
PARKING 5%.

2. ALL DRIVEWAYS, CURB ADJACENT TO DRIVEWAYS, AND SIDEWALK CONSTRUCTION WITHIN THE PUBLIC RIGHT-OF-WAY, SHALL BE COMPLETED IN ACCORDANCE WITH CITY OF MADISON STANDARD SPECIFICATIONS FOR PUBLIC WORKS CONSTRUCTION BY A CONTRACTOR CURRENTLY LICENSED BY THE CITY.

3. ALL NEW DRIVES TO BE CONSTRUCTED WITH CLASS III
APPROACHES (UNLESS NOTED OTHERWISE) IN ACCORDANCE
WITH MADISON GENERAL ORDINANCE SECTION 10.08(4)

4. ALL TRASH TO BE COLLECTED IN DESIGNATED TRASH ROOMS. RECYCLING AREAS TO BE PROVIDED IN TRASH ROOM.

5. SEE GRADING AND UTILITY PLANS FOR ADDITIONAL INFORMATION.

6. COMM 62.0500(II)-REQUIRED FIRE LANES SHALL BE PROVIDED PRIOR TO THE PLACEMENT OF COMBUSTIBLE MATERIALS AT THE BUILDING SITE, OR THE CONSTRUCTION OF ANY PORTION OF A BUILDING ABOVE THE FOOTING AND FOUNDATION.

7. BIKE STALLS TO BE IN ACCORDANCE WITH MADISON GENERAL ORDINANCE 28.II, SEE SUBSECTIONS (3)(e) AND (3)(h)2d. FOR TYPES OF RACKS ALLOWED.

8. THE APPLICANT SHALL CLOSE ALL ABANDONED DRIVEWAYS BY REPLACING THE CURB IN FRONT OF THE DRIVEWAYS AND RESTORING THE TERRACE WITH GRASS.

SHALL BE REPLACED.

9. ALL SIDEWALK, CURB, AND GUTTER ABUTTING THE PROPERTY WHICH IS DAMAGED DURING CONSTRUCTION OR THAT THE CITY ENGINEER DETERMINES TO BE NECESSARY

IO. ALL IMPROVEMENTS IN THE PUBLIC RIGHT-OF-WAY SHALL BE PER THE CITY ISSUED PLANS.

II. ALL DAMAGE TO PAVEMENT ON ARBOR DR. OR KNICKERBOCKER ST. SHALL BE RESTORED IN ACCORDANCE WITH THE CITY OF MADISON'S PAVEMENT PATCHING CRITERIA.

Revisions

Submittal - Febuary 18, 2013 Issued - Febuary 27, 2013 Issued for Construction - April 26, 2013 Issued for Plan Approval - July 5, 2013 Revision #3 - August 19, 2013

Project Title

Mingra Shores Apartments

2628 Arbor Drive 36 Unit Building – Madison, Wl

Drawing Title
Site Plan

Project No.

0522

**G**=|.|

Drawing No.

This document contains confidential or proprietary information of Knothe & Bruce Architects. Neither the document nor the information herein is to be reproduced, distributed, used, or disclosed, either in whole or in part, except as specifically authorized by Knothe & Bruce Architects. Knothe & Bruce Architects is a Limited Liability Company of Wisconsin.

BUILDING MATERIAL	MATERIAL	MANUFACTURER	COLOR	
ROOF	ASPHALT SHINGLES	GAF TIMBERLINE	WILLIAMSBURG SLATE BLEND	
ROOF	WATERPROOF MEMBRANE	T.B.D.	BLACK	
ROOF TRANSITION CAP	ALUMINUM	ALCOA	T.B.D.	
DRIP EDGE	ALUMINUM		TERRA BRONZE	
GUTTER	ALUMINUM		TERRA BRONZE	
FASCIA	WOOD COMPOSITE	LP SMART SIDE	SW 2843 ROYCROFT BRASS	
VENTED SOFFIT	ALUMINUM	MASTIC HOME EXTERIORS	TERRA BRONZE	
DOWNSPOUT	ALUMINUM		TERRA BRONZE	
DOWNSPOUT @ PRAIRIE STONE	ALUMINUM		DESSERT SAND	
FRIEZE BOARD	WOOD COMPOSITE	LP SMART SIDE	SW 2843 ROYCROFT BRASS	
7" EXPOSURE HORIZONTAL SIDING	WOOD COMPOSITE	LP SMART SIDE	SW 2843 ROYCROFT BRASS	
TRIM	WOOD COMPOSITE	LP SMART SIDE	SW 2843 ROYCROFT BRASS	
COMPOSITE PANEL	WOOD COMPOSITE		SM 2842 ROYCROFT SUEDE	
WINDOWS	VINYL	WEATHERSHIELD - VISIONS 3000	TAN	
WINDOW FLASHING @ MASONRY	ALUMINUM	KAYNAR 500	ALMOND	
WINDOW FLASHING @ COMPOSITE	ALUMINUM		TERRA BRONZE	
SEALANT @ WINDOWS	T.B.D.	T.B.D.	MATCH TRIM COLOR	
RAILING	ALUMINUM	SUPERIOR	DARK BRONZE	
DECK BOARDS	COMPOSITE	TREX	WINCHESTER GREY	
DECK SKIRT / TRIM	WOOD COMPOSITE	LP SMART SIDE	SW 2843 ROYCROFT BRASS	
FLASHING @ DECK EDGE	ALUMINUM		TERRA BRONZE	
FLASHING @ DECK LEDGER	ALUMINUM		TERRA BRONZE	
WALKABLE DECK MEMBRANE	VINYL	DURADECK	SURCOSEAL SUEDE	
ENTRANCE DOORS	ALUMINUM	KAMNEER	DARK BRONZE	
OVERHEAD GARAGE DOOR	ALUMINUM	WAYNE DALTON	ALMOND	
BRICK	MASONRY KING SIZE	BORAL	BRIDGETON	
MASONRY ACCENT PIECES @ BRICK	PRAIRIE STONE (4x4x12)	NORTH FIELD BLOCK	BUFF GROUNDFACE	
WALKABLE DECK MEMBRANE	VINYL	DURADECK	SURCOSEAL SUEDE	
PVC WATERPROOFING MEMBRANE @ CANOPIES	PVC		TAN	
STONE VENEER	STONE	HALQUIST	CHILTON WEATHEREDGE BROWN	
PRECAST BANDS, SILLS, HEADS	PRAIRIE STONE	NORTH FIELD BLOCK	BUFF	
MORTAR @ STONE & BRICK	MORTAR		P3410 BEACH SAND	
THINSULGRETE			SW 7569 STUCCO	



# SOUTHWEST ELEVATION (KNICKERBOCKER STREET)



KNOTHE BRUCE

ARCHITECTS

7601 University Avenue Suite 201

Middleton, Wisconsin 53562 608-836-3690 Fax 836-6934

Consultant

Note

Revisions Submittal - Febuary 18, 2013 Issued - Febuary 27, 2013 Issued for Construction - April 26, 2013

ORIGINAL

Project Title
Wingra Shores
Apartments


2628 Arbor Drive 36 Unit Building - Madison, WI Drawing Title **Elevations** 

Project No. Drawing No. A-2.1

This document contains confidential or proprietary information of Knothe & Bruce Architects. Neither the document nor the information herein is to be reproduced, distributed, used, or disclosed, either in whole or in part, except as specifically authorized by Knothe & Bruce Architects. Knothe & Bruce Architects is a Limited Liability Company of Wisconsin.



## NORTHEAST ELEVATION

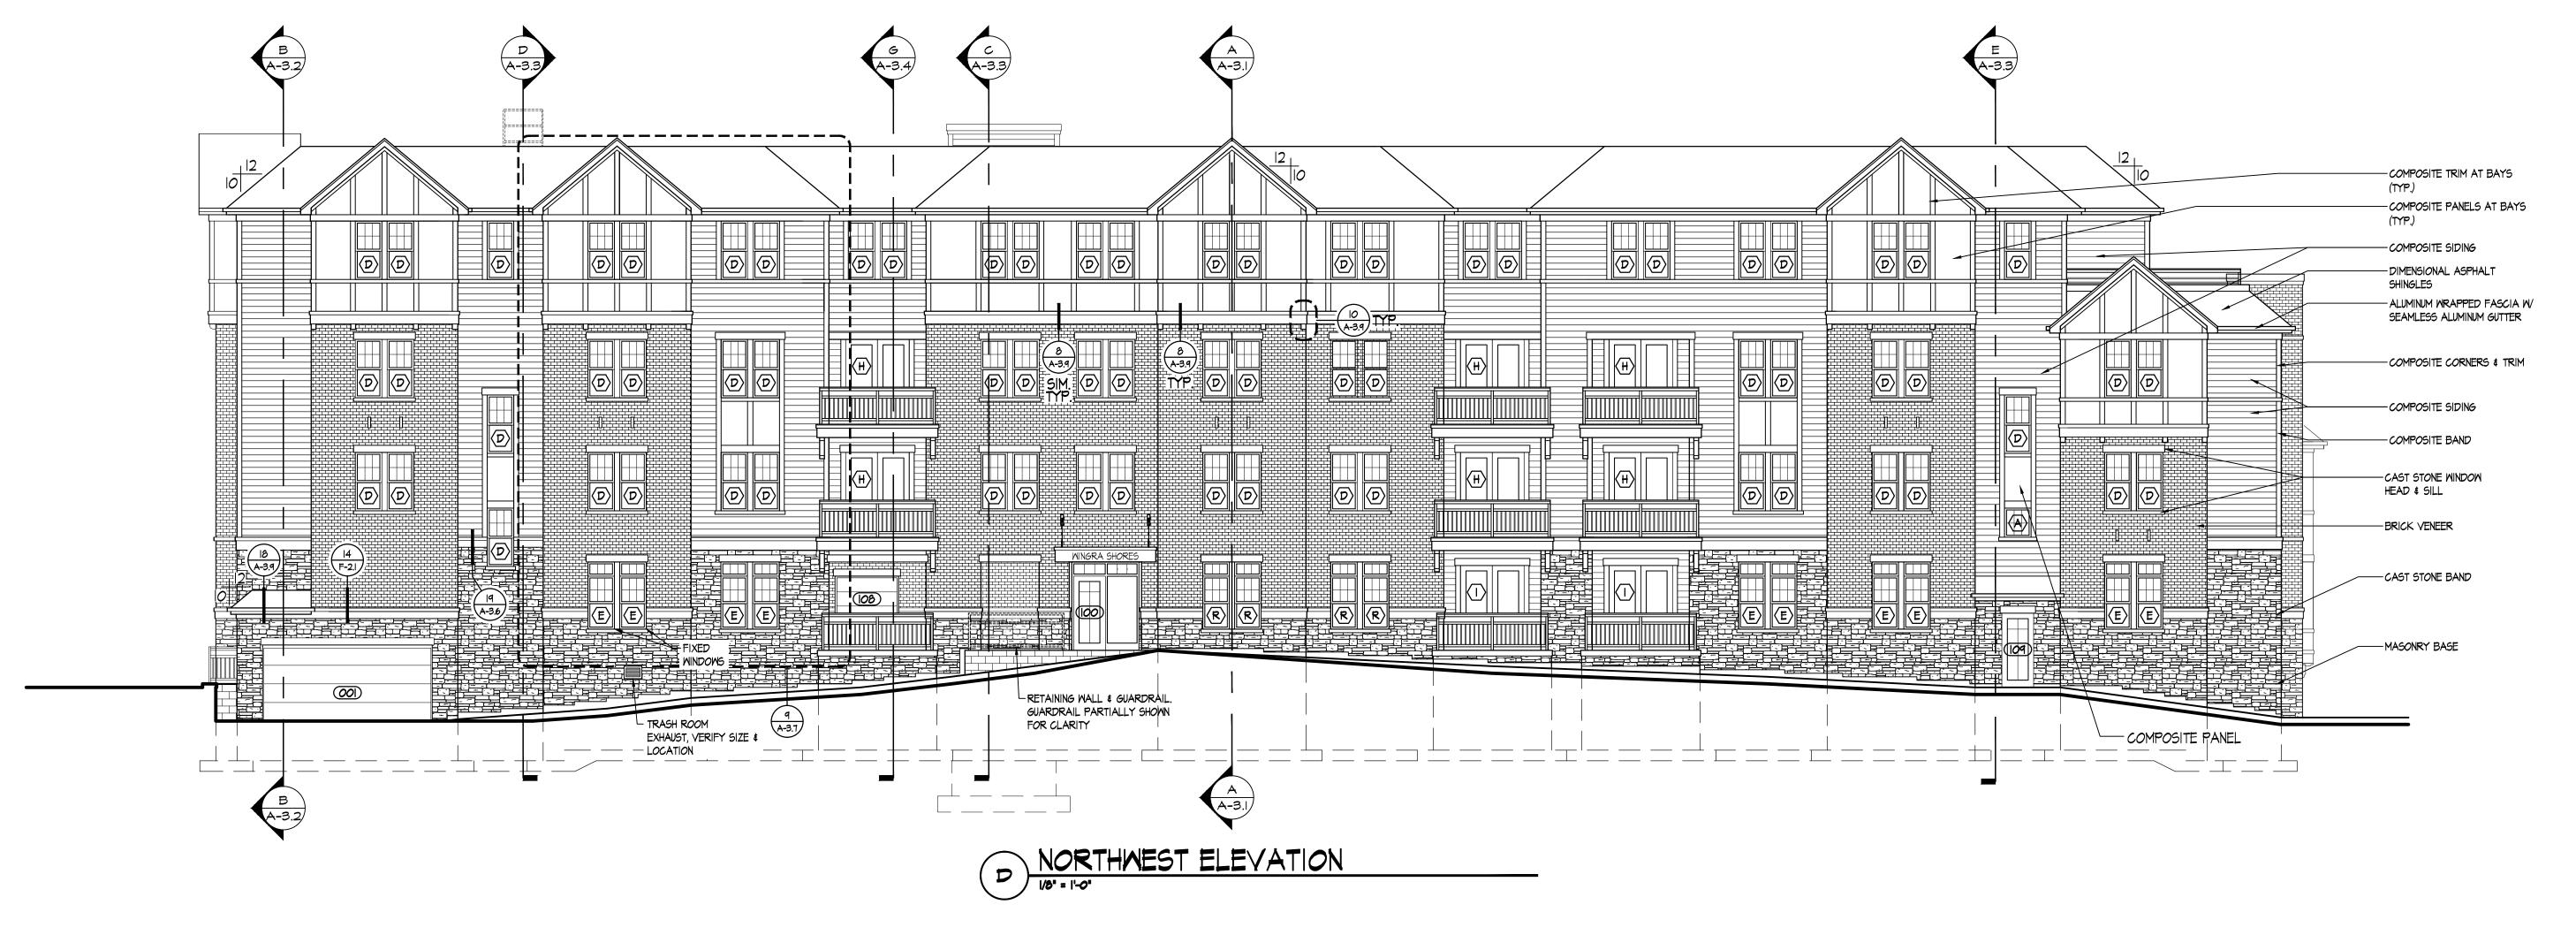

KNOTHE SHITECTS
ARCHITECTS
7601 University Avenue Suite 201

Middleton, Wisconsin 53562 608-836-3690 Fax 836-6934

Consultant

Not

Revisions

Submittal - Febuary 18, 2013

Issued - Febuary 27, 2013

Issued for Construction - April 26, 2013

ORIGINAL

Project Title
Wingra Shores
Apartments

2628 Arbor Drive 36 Unit Building - Madison, WI Drawing Title **Elevations** 

pject No.

0522

This document contains confidential or proprietary information of Knothe & Bruce Architects. Neither the document nor the information herein is to be reproduced, distributed, used, or disclosed, either in whole or in part, except as specifically authorized by Knothe & Bruce Architects. Knothe & Bruce Architects is a Limited Liability Company of Wisconsin.

Drawing No.

A-2.2

ROOF ROOF ROOF TRANSITION CAP DRIP EDGE	ASPHALT SHINGLES	<del> </del>	•
ROOF TRANSITION CAP		GAF TIMBERLINE	WILLIAMSBURG SLATE BLEND
	WATERPROOF MEMBRANE	T.B.D.	BLACK
DRIP FDAF	ALUMINUM	ALCOA	T.B.D.
DNII EDOL	ALUMINUM		TERRA BRONZE
SUTTER	ALUMINUM		TERRA BRONZE
FASCIA	WOOD COMPOSITE	LP SMART SIDE	SM 2843 ROYCROFT BRASS
VENTED SOFFIT	ALUMINUM	MASTIC HOME EXTERIORS	TERRA BRONZE
DOWNSPOUT	ALUMINUM		TERRA BRONZE
DOWNSPOUT @ PRAIRIE STONE	ALUMINUM		DESSERT SAND
FRIEZE BOARD	MOOD COMPOSITE	LP SMART SIDE	SM 2843 ROYCROFT BRASS
T" EXPOSURE HORIZONTAL SIDING	WOOD COMPOSITE	LP SMART SIDE	SM 2843 ROYCROFT BRASS
TRIM	WOOD COMPOSITE	LP SMART SIDE	SM 2843 ROYCROFT BRASS
COMPOSITE PANEL	WOOD COMPOSITE		SM 2842 ROYCROFT SUEDE
MINDOMS	VINYL	WEATHERSHIELD - VISIONS 3000	TAN
NINDOW FLASHING @ MASONRY	ALUMINUM	KAYNAR 500	ALMOND
NINDOW FLASHING @ COMPOSITE	ALUMINUM		TERRA BRONZE
SEALANT @ WINDOWS	T.B.D.	T.B.D.	MATCH TRIM COLOR
RAILING	ALUMINUM	SUPERIOR	DARK BRONZE
DECK BOARDS	COMPOSITE	TREX	WINCHESTER GREY
DECK SKIRT / TRIM	WOOD COMPOSITE	LP SMART SIDE	SM 2843 ROYCROFT BRASS
FLASHING @ DECK EDGE	ALUMINUM		TERRA BRONZE
FLASHING @ DECK LEDGER	ALUMINUM		TERRA BRONZE
MALKABLE DECK MEMBRANE	VINYL	DURADECK	SURCOSEAL SUEDE
ENTRANCE DOORS	ALUMINUM	KAMNEER	DARK BRONZE
OVERHEAD GARAGE DOOR	ALUMINUM	WAYNE DALTON	ALMOND
BRICK	MASONRY KING SIZE	BORAL	BRIDGETON
MASONRY ACCENT PIECES @ BRICK	PRAIRIE STONE (4x4x12)	NORTH FIELD BLOCK	BUFF GROUNDFACE
MALKABLE DECK MEMBRANE	VINYL	DURADECK	SURCOSEAL SUEDE
PVC WATERPROOFING MEMBRANE @ CANOPIES	PVC		TAN
STONE VENEER	STONE	HALQUIST	CHILTON MEATHEREDGE BROWN
PRECAST BANDS, SILLS, HEADS	PRAIRIE STONE	NORTH FIELD BLOCK	BUFF
MORTAR @ STONE & BRICK	MORTAR	***************************************	P34IO BEACH SAND



SOUTHWEST ELEVATION (KNICKERBOCKER STREET)



KNOTHE SUITE 201

Middleton, Wisconsin 53562 608-836-3690 Fax 836-6934

Consultant

Note

Revis

Submittal - Febuary 18, 2013 Issued - Febuary 27, 2013 Issued for Construction - April 26, 2013 Issued for Plan Approval - July 5, 2013 Revision #3 - August 19, 2013

REVISED

Project Title

Mingra Shores Apartments

2628 Arbor Drive 36 Unit Building - Madison, WI Drawing Title **Elevations** 


Project No. Drawing No.

0522 A-2.1

This document contains confidential or proprietary information of Knothe & Bruce Architects. Neither the document nor the information herein is to be reproduced, distributed, used, or disclosed, either in whole or in part, except as specifically authorized by Knothe & Bruce Architects. Knothe & Bruce Architects is a Limited Liability Company of Wisconsin.





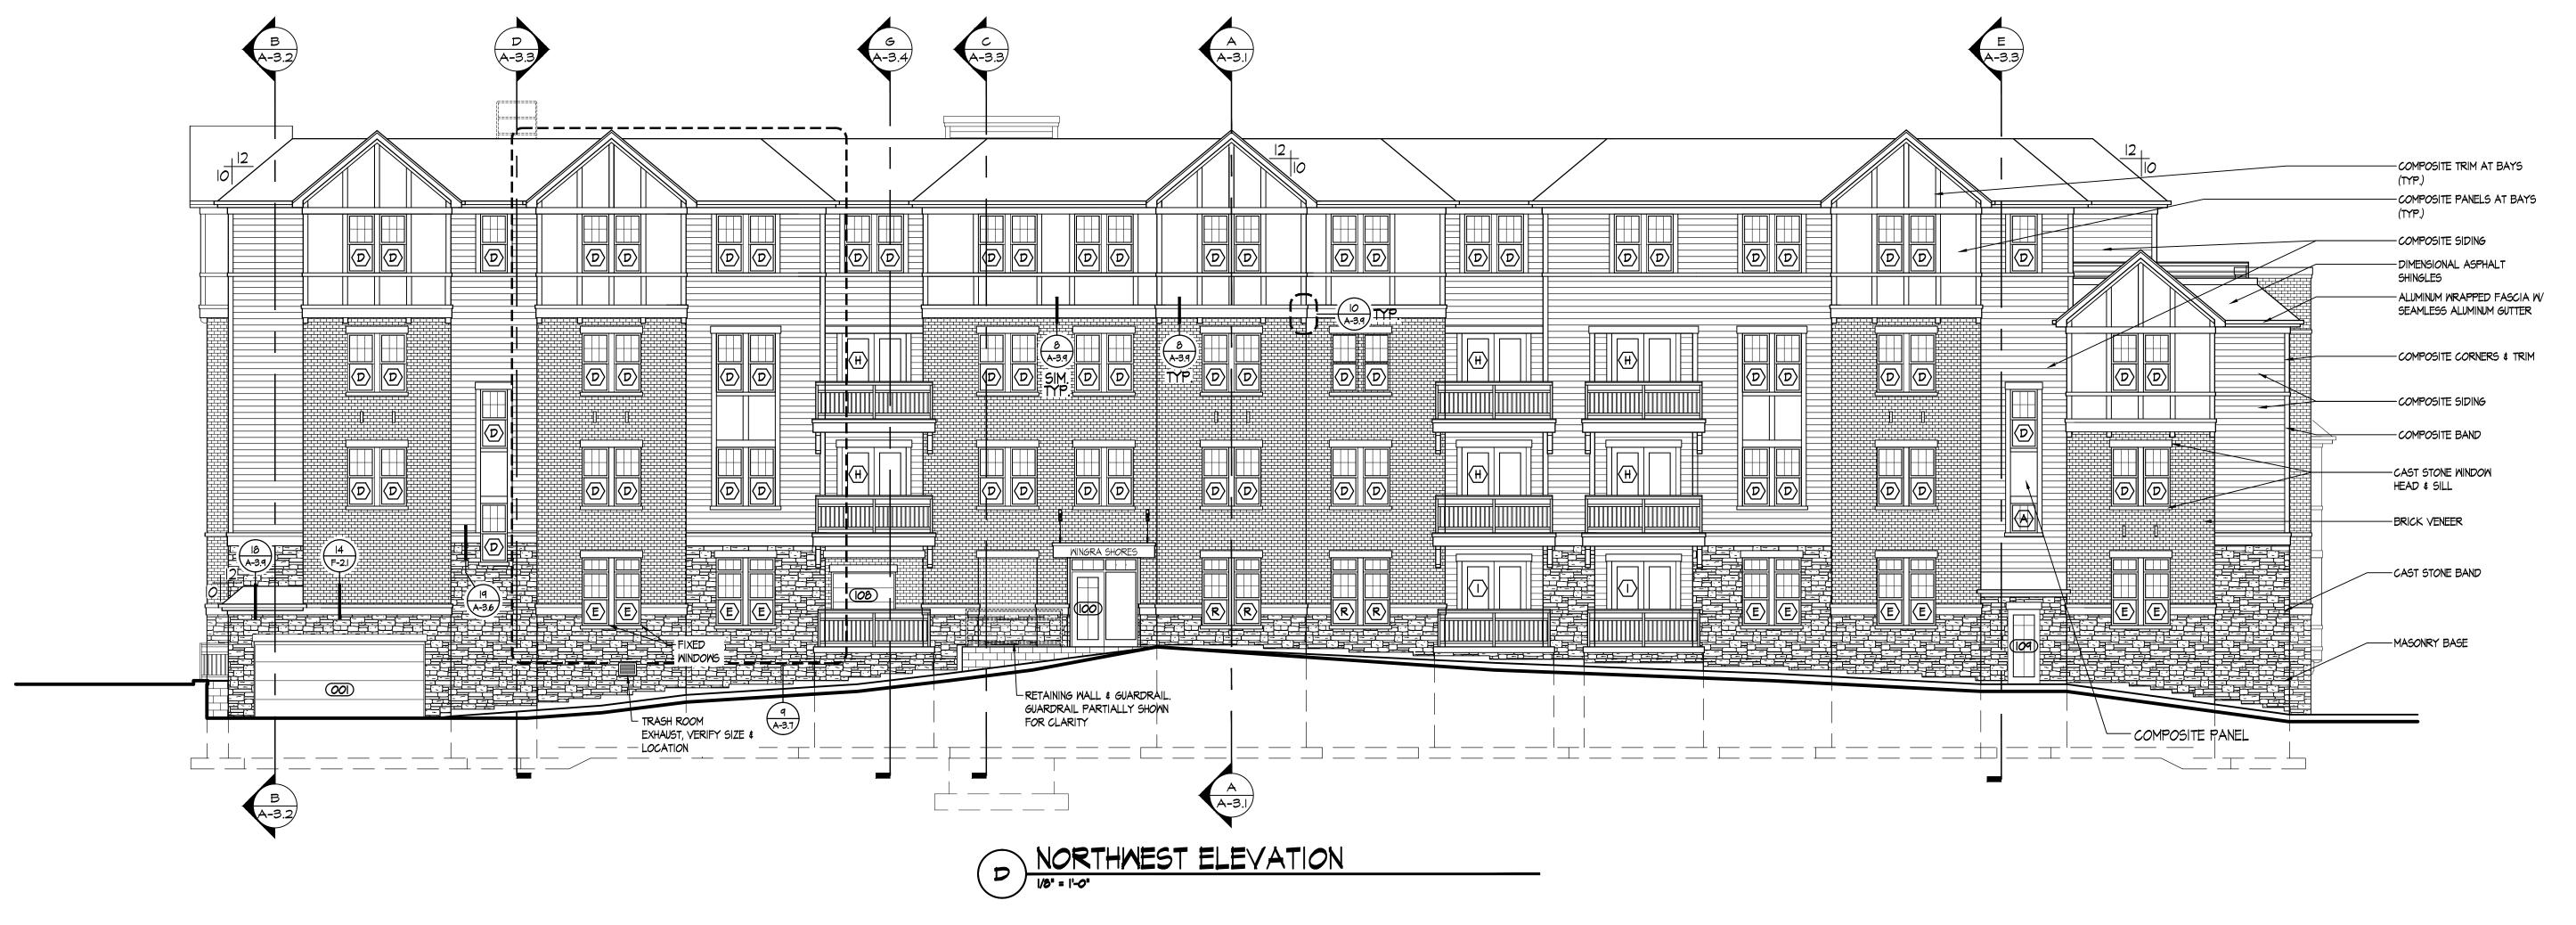

760 University Avenue Suite 20 I

Middleton, Wisconsin 53562 608-836-3690 Fax 836-6934

Consultant

Revisions

Submittal - Febuary 18, 2013 Issued - Febuary 27, 2013 Issued for Construction - April 26, 2013 Issued for Plan Approval - July 5, 2013 Revision #3 - August 19, 2013

REVISED

Wingra Shores Apartments

2628 Arbor Drive 36 Unit Building - Madison, Ml Drawing Title

Elevations

0522

Drawing No.

A-2.2 Neither the document nor the information herein is to be reproduced, distributed, used, or disclosed, either in whole or in part, except as specifically authorized by Knothe & Bruce Architects.

Knothe & Bruce Architects is a Limited Liability Company of Wisconsin.