


1000 OAKS

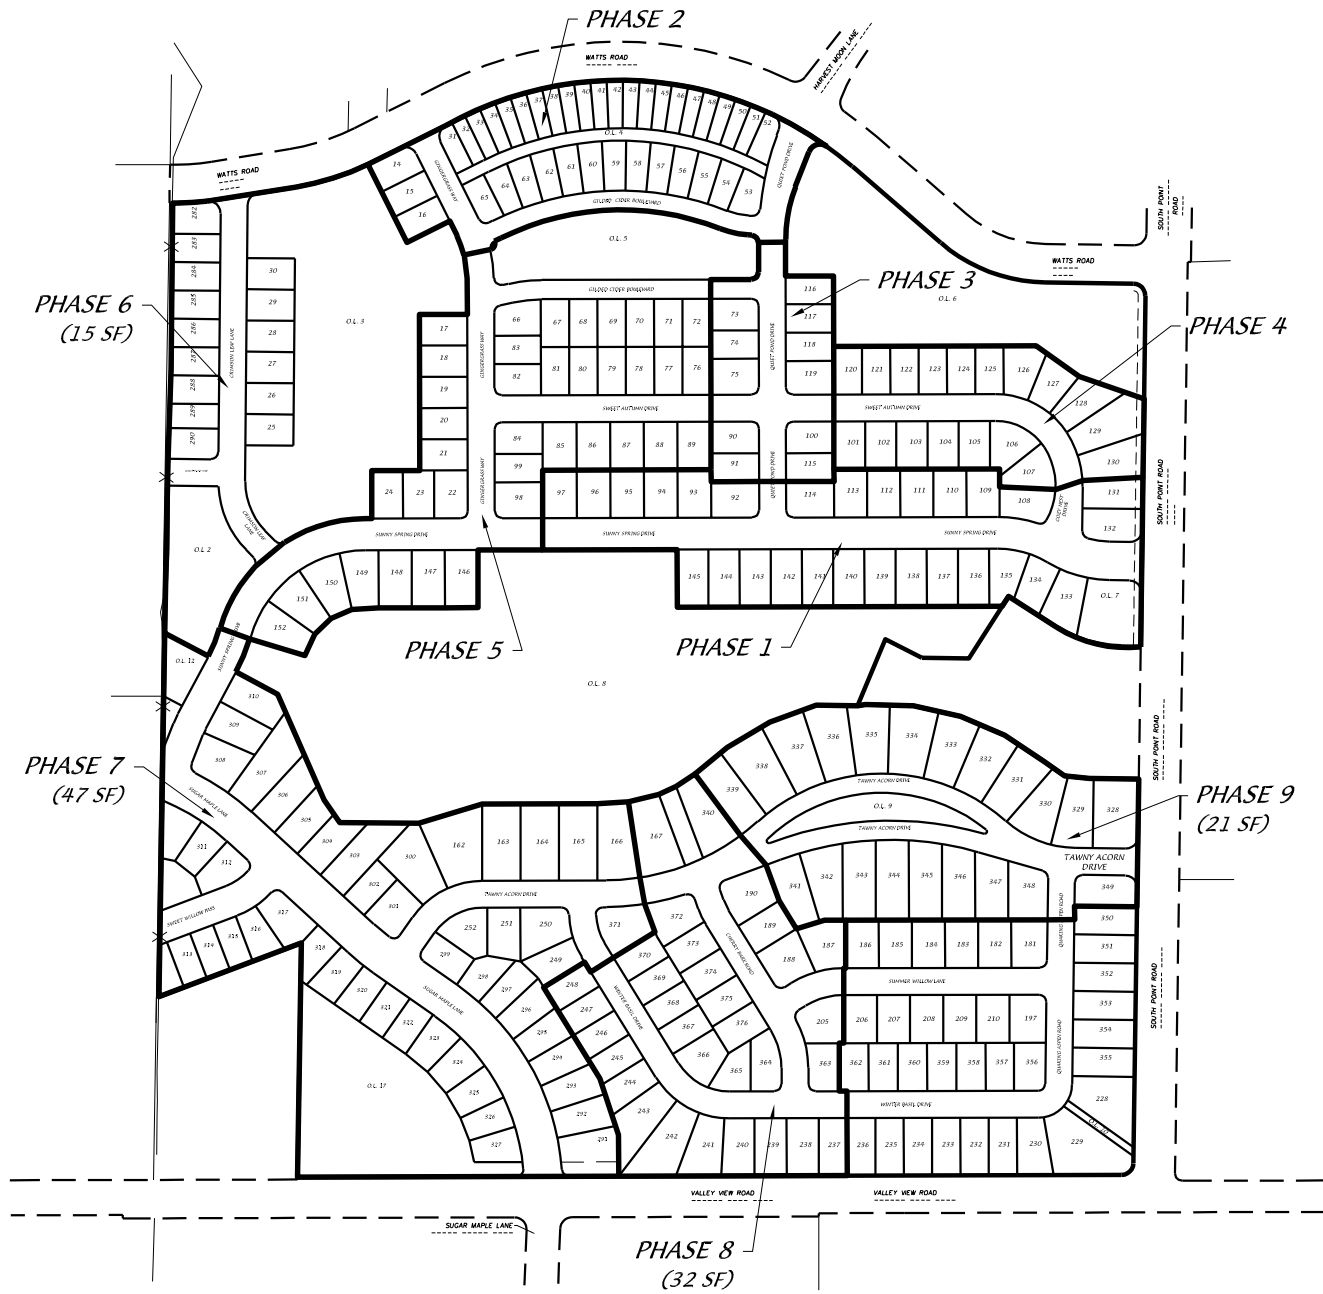

D'ONOFRIO KOTTKE AND ASSOCIATES, INC.

7530 Westward Way, Madison, WI 53717
 Phone: 608.833.7530 • Fax: 608.833.1089

YOUR NATURAL RESOURCE FOR LAND DEVELOPMENT



0 400



Scale 1" = 400'

DATE: 07-10-20

F.N.: 19-05-132

REV.

DRAWN BY:

U: /USER/1305152/DRAWINGS/PHASE MAP.DWG

FIRST ADDITION TO 1000 OAKS:

~~PHASE 8~~ PHASE 9

O.L. 1
CSM 13155

PHASE 9
~~PHASE 8~~

