



City of Madison Site Plan Verification

PROJECT: LNDSPR-2020-00091

Address: 1421 Regent ST

Current Revision #: 0

Submitted by: Sconnie Bar

Contact: Kelly Jordan
(608) 819-8610
jordansbig10@gmail.com

Project Type: Permitted Use Site Plan Review

Description: Temporary Outdoor Seating in parking lot for Restaurant-tavern, valid until October 25, 2020

Status: Approved

Revision History: 0

Review	Status	Reviewer	Reviewed
Fire Review		William Sullivan	Jul 10 2020
Traffic Engineering Review		Timothy Stella	Jul 10 2020
Zoning Review		Matthew Tucker	Jul 14 2020

FIRE

Note **Comment Date:** 07/10/2020

The openings in the fence for ingress/egress shall be a minimum of 36-inches.


TRAFFIC ENGINEERING

Supplement Accepted **Comment Date:** 07/08/2020

Email a revised electronic copy of the site plan, .pdf preferred, to Tim Stella - tstella@cityofmadison.com

Supplement Accepted **Comment Date:** 07/08/2020

Applicant shall add wheel stops to the parking stalls to secure the temporary seating area.

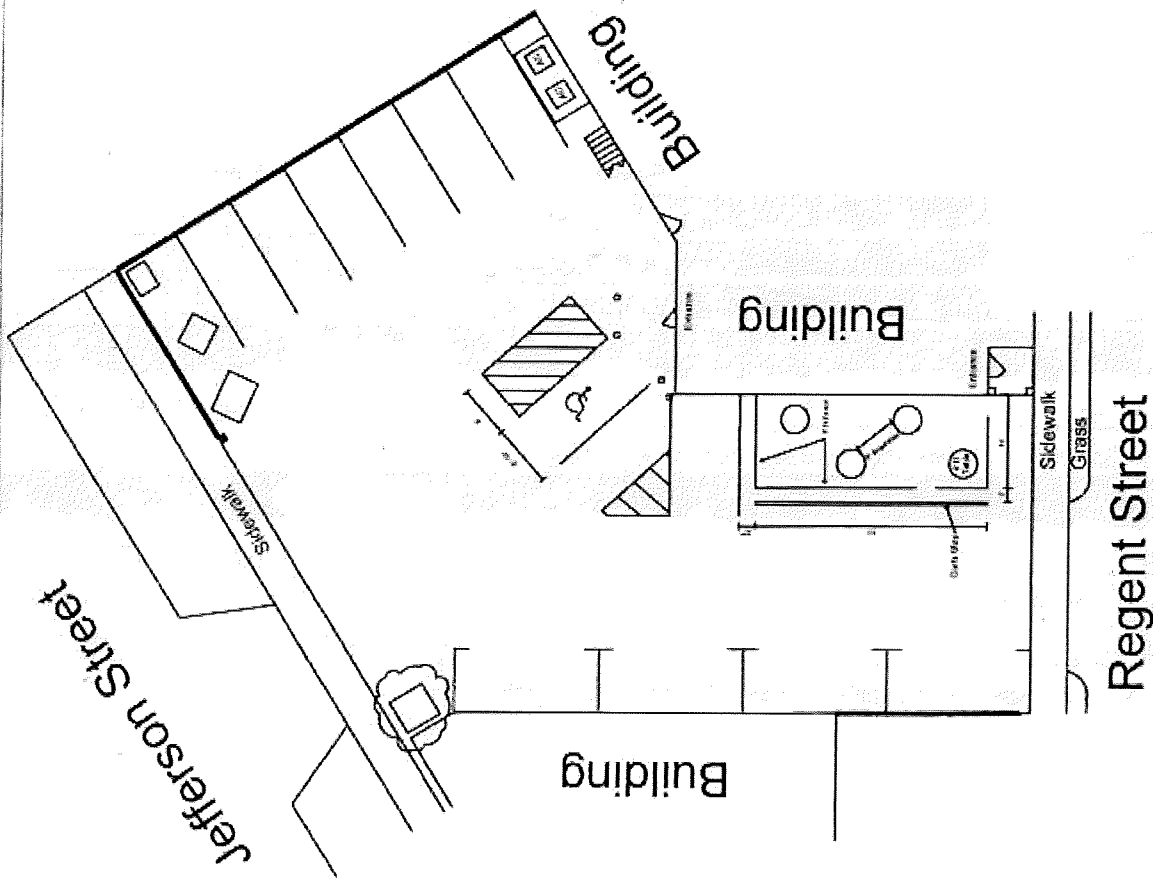

Scale 1" = 25'

SCONNIEBAR

Proposed Outdoor Seating

Revised 07/09/2020