


EXISTING FLOOR PLAN

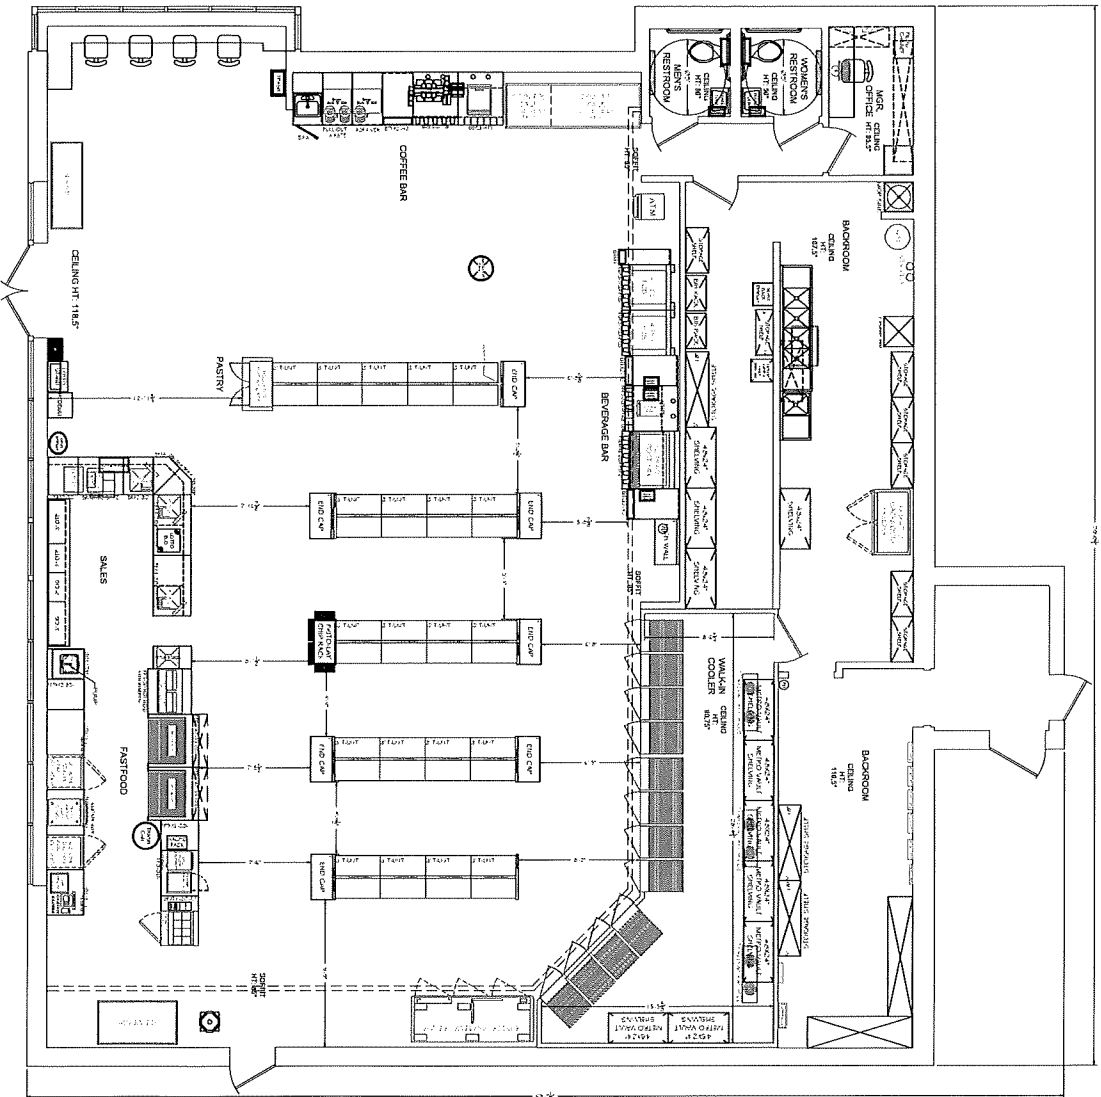

DISCLAIMER: THIS DRAWING AND ALL SUPPORTING DOCUMENTS CONTAINED IN THE "DRAWING PACKAGE" ARE THE PROPERTY OF ROYSTON GROUP, FIELD SERVICES DIVISION. ANY USE OF THE DRAWING, FILE OR ANY OF THE INFORMATION FOUND WITHIN FOR ANY PURPOSE OUTSIDE OF DIRECT REQUEST BY ROYSTON GROUP WILL BE SEEN AS A VIOLATION OF THE WORK AGREEMENT AND WILL BE PURSUED TO THE FULLEST EXTENT ALLOWABLE. THE DRAWINGS AND EQUIPMENT LISTS ARE INTENDED TO REPRESENT THE GENERALIZED CHARACTERISTICS OF THE SCOPE OF WORK BUT IN NO WAY RELIEVE THE CONTRACTORS RESPONSIBILITY FOR CONDUCTING A STORE SPECIFIC SITE VISIT, COLLECTING ALL NECESSARY AS-BUILT INFORMATION, AND VERIFYING ALL ELEMENTS SHOWN AS FEASIBLE AS THEY PERTAIN TO THE PROPOSED DESIGN.

NOTE: EXISTING CONDITIONS ARE SHOWN IN BLACK OR GRAY. NEW / PROPOSED ELEMENTS ARE SHOWN IN RED.



7-ELEVEN
REMDEL

DISCLAIMER:
THIS IS NOT A LEGAL
DOCUMENT. INTENT TO
SHOW CURRENT
EQUIPMENT CONDITIONS

REVISIONS		
REV#	DATE	DESCRIPTION

7-ELEVEN

35851
2216 UNIVERSITY AVENUE
MADISON, WISCONSIN
53726

DRAWN BY:
FJ

SCALE:
1/8" = 1'-0"


DATE:
05-11-24

SHEET:
A - 1.0

7-ELEVEN

DRAWING #
35851 - 7-ELEVEN

PROPOSED - FLOOR PLAN

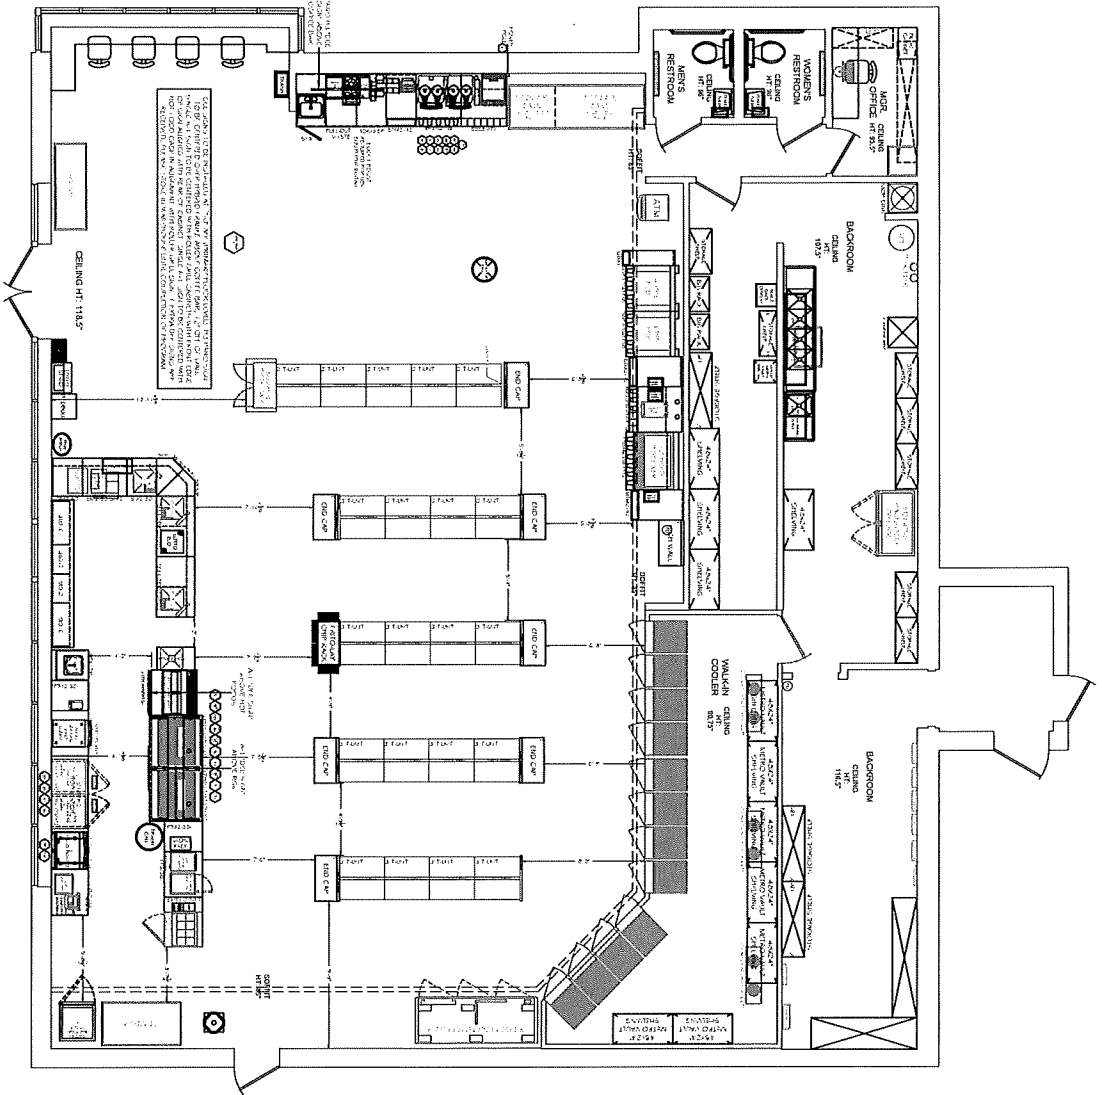

DISCLAIMER: THIS DRAWING AND ALL SUPPORTING DOCUMENTS CONTAINED IN THE "DRAWING PACKAGE" ARE THE PROPERTY OF ROYSTON GROUP, FIELD SERVICES DIVISION. ANY USE OF THE DRAWING, FILE OR ANY OF THE INFORMATION FOUND WITHIN FOR ANY PURPOSE OUTSIDE OF DIRECT REQUEST BY ROYSTON GROUP WILL BE SEEN AS A VIOLATION OF THE WORK AGREEMENT AND WILL BE PURSUED TO THE FULLEST EXTENT ALLOWABLE. THE DRAWINGS AND EQUIPMENT LISTS ARE INTENDED TO REPRESENT THE GENERALIZED CHARACTERISTICS OF THE SCOPE OF WORK, BUT IN NO WAY RELIEVE THE CONTRACTORS RESPONSIBILITY FOR CONDUCTING A STORE SPECIFIC SITE VISIT, COLLECTING ALL NECESSARY AS-BUILT INFORMATION, AND VERIFYING ALL ELEMENTS SHOWN AS FEASIBLE AS THEY PERTAIN TO THE PROPOSED DESIGN.

NOTE: EXISTING CONDITIONS ARE SHOWN IN BLACK OR GRAY. NEW / PROPOSED ELEMENTS ARE SHOWN IN RED.



7-ELEVEN
REMODEL

DISCLAIMER:
THIS IS NOT A LEGAL
DOCUMENT. INTENT TO
SHOW CURRENT
EQUIPMENT CONDITIONS

7-ELEVEN		
REVISIONS		
REV#	DATE	DESCRIPTION
2-KLD	5/14/24	INITIAL PROPOSAL
3-NRR	6/13/24	SCOPE WALK

35851
2216 UNIVERSITY AVENUE
MADISON, WISCONSIN
53726

DRAWN BY:
FJ

SCALE:
1/8" = 1'-0"

DATE:
05-11-24

SHEET:
A - 2.0

DRAWING #
7-ELEVEN

35851 - 7-ELEVEN



ELEVEN
®

DISCLAIMER:
THIS IS NOT A LEGAL
DOCUMENT. INTENT TO
SHOW CURRENT
EQUIPMENT CONDITIONS

REVISIONS		
REV#	DATE	DESCRIPTION

7-ELEVEN
35851
2216 UNIVERSITY AVENUE
MADISON, WISCONSIN
53726

DRAWN BY:	FJ
SCALE:	NTS
DATE	05-11-24
SHEET	R.1. - 1.0
7-ELEVEN	
DRAWING #	
35851 - 7-ELEVEN	

(WITH DOORS)

BUNN-
DUAL TF DBC

A schematic diagram of the Sanden Hot Hold Display Case. It shows a rectangular frame with two internal vertical dividers. The top section is divided into two equal-width compartments. The bottom section is a single wide compartment containing the text "SANDEN HOT HOLD DISPLAY CASE".

FFRG 42-39 SCD	FFRG 42-39 SCD
----------------	----------------

DISCLAIMER: THIS DRAWING AND ALL SUPPORTING DOCUMENTS CONTAINED IN THE "DRAWING PACKAGE" ARE THE PROPERTY OF ROYSTON GROUP, FIELD SERVICES DIVISION. ANY USE OF THE DRAWING FILE OR ANY OF THE INFORMATION FOUND WITHIN FOR ANY PURPOSE OUTSIDE OF DIRECT REQUEST BY ROYSTON GROUP WILL BE SEEN AS A VIOLATION OF THE WORK AGREEMENT AND WILL BE PURSUED TO THE FULLEST EXTENT ALLOWABLE. THE DRAWINGS AND EQUIPMENT LISTS ARE INTENDED TO REPRESENT THE GENERALIZED CHARACTERISTICS OF THE SCOPE OF WORK BUT IN NO WAY RELIEVE THE CONTRACTORS RESPONSIBILITY FOR CONDUCTING A STORE SPECIFIC SITE VISIT, COLLECTING ALL NECESSARY AS-BUILT INFORMATION, AND VERIFYING ALL ELEMENTS SHOWN AS FEASIBLE AS THEY PERTAIN TO THE PROPOSED DESIGN.

NOTE: EXISTING CONDITIONS
ARE SHOWN IN BLACK OR
GRAY. NEW / PROPOSED
ELEMENTS ARE SHOWN IN RED.