



MGE Marked Up  
 MJB 5/4/18

Existing Facilities in Blue  
 Proposed Facilities in Red  
 Removals in Orange

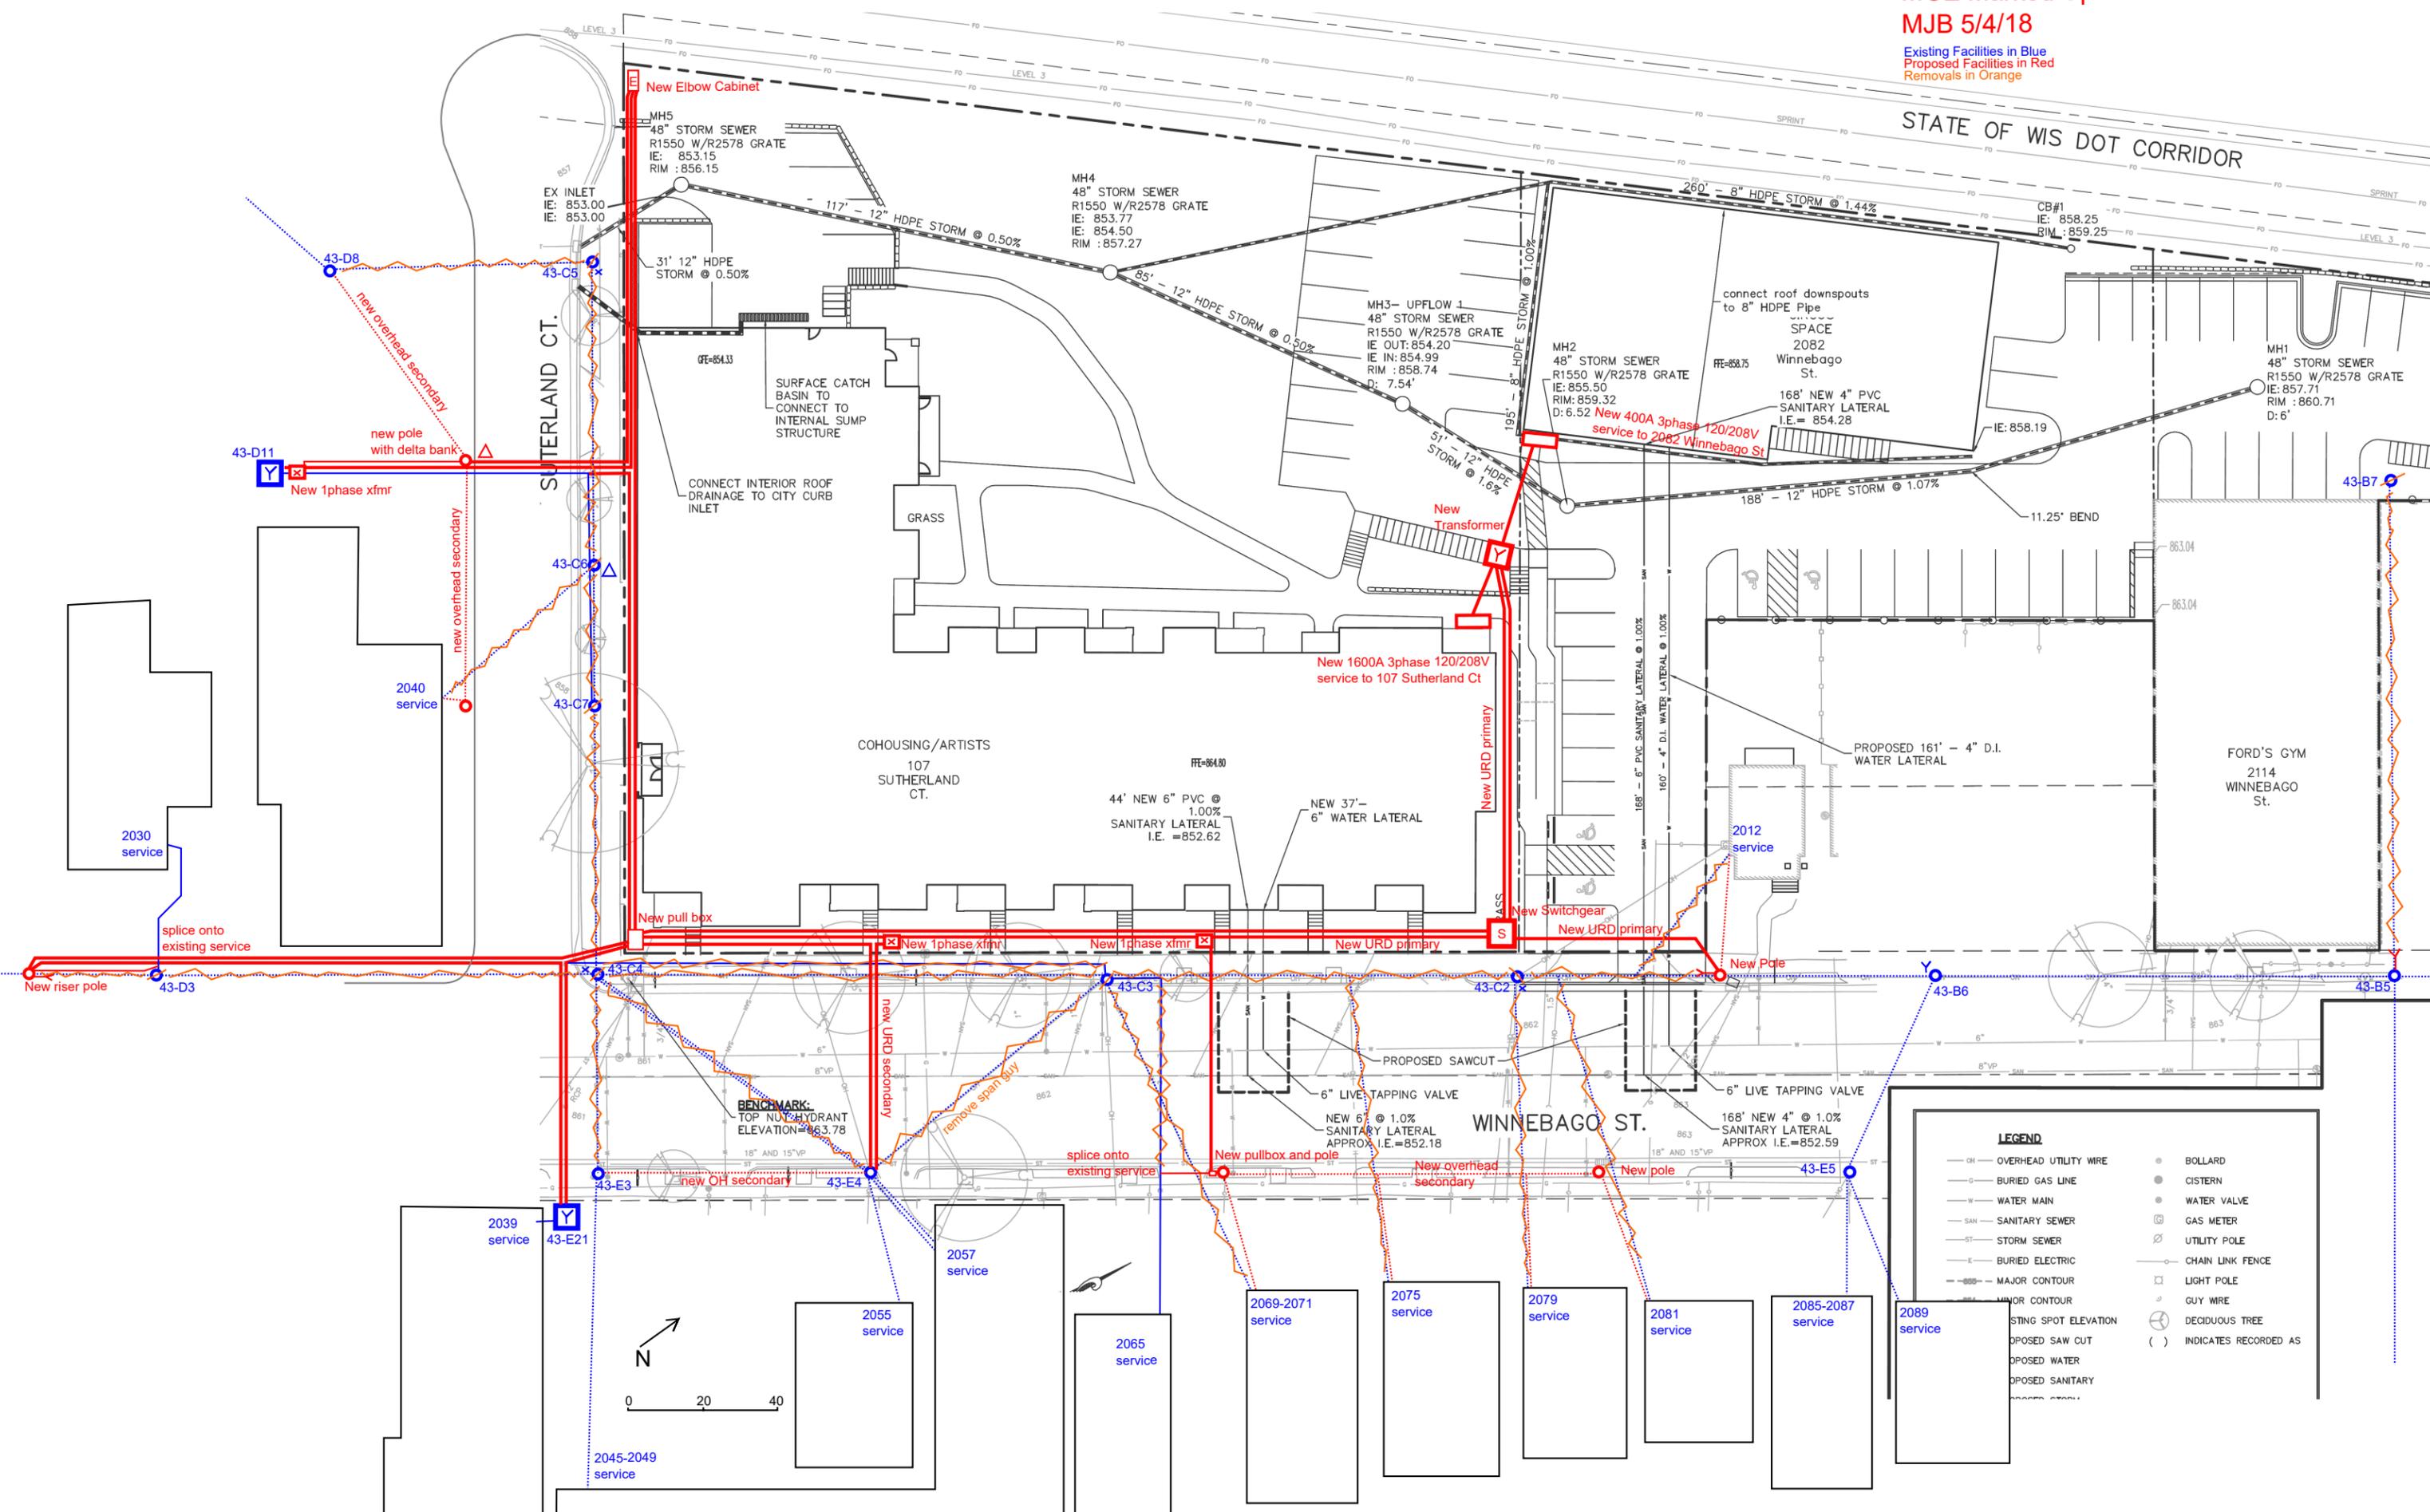

LEGEND	
— OH	OVERHEAD UTILITY WIRE
— B	BURIED GAS LINE
— W	WATER MAIN
— SAN	SANITARY SEWER
— ST	STORM SEWER
— E	BURIED ELECTRIC
— MC	MAJOR CONTOUR
— MC	MINOR CONTOUR
—	STING SPOT ELEVATION
—	PROPOSED SAW CUT
—	PROPOSED WATER
—	PROPOSED SANITARY
●	BOLLARD
●	CISTERN
●	WATER VALVE
⊗	GAS METER
⊗	UTILITY POLE
⊗	CHAIN LINK FENCE
⊗	LIGHT POLE
⊗	GUY WIRE
⊗	DECIDUOUS TREE
( )	INDICATES RECORDED AS

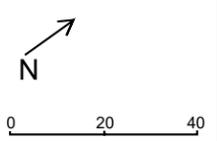

2039 service

2055 service

2065 service

2069-2071 service

2075 service

2079 service

2081 service

2085-2087 service

2089 service

2045-2049 service

2040 service

2030 service

2012 service

2057 service
















