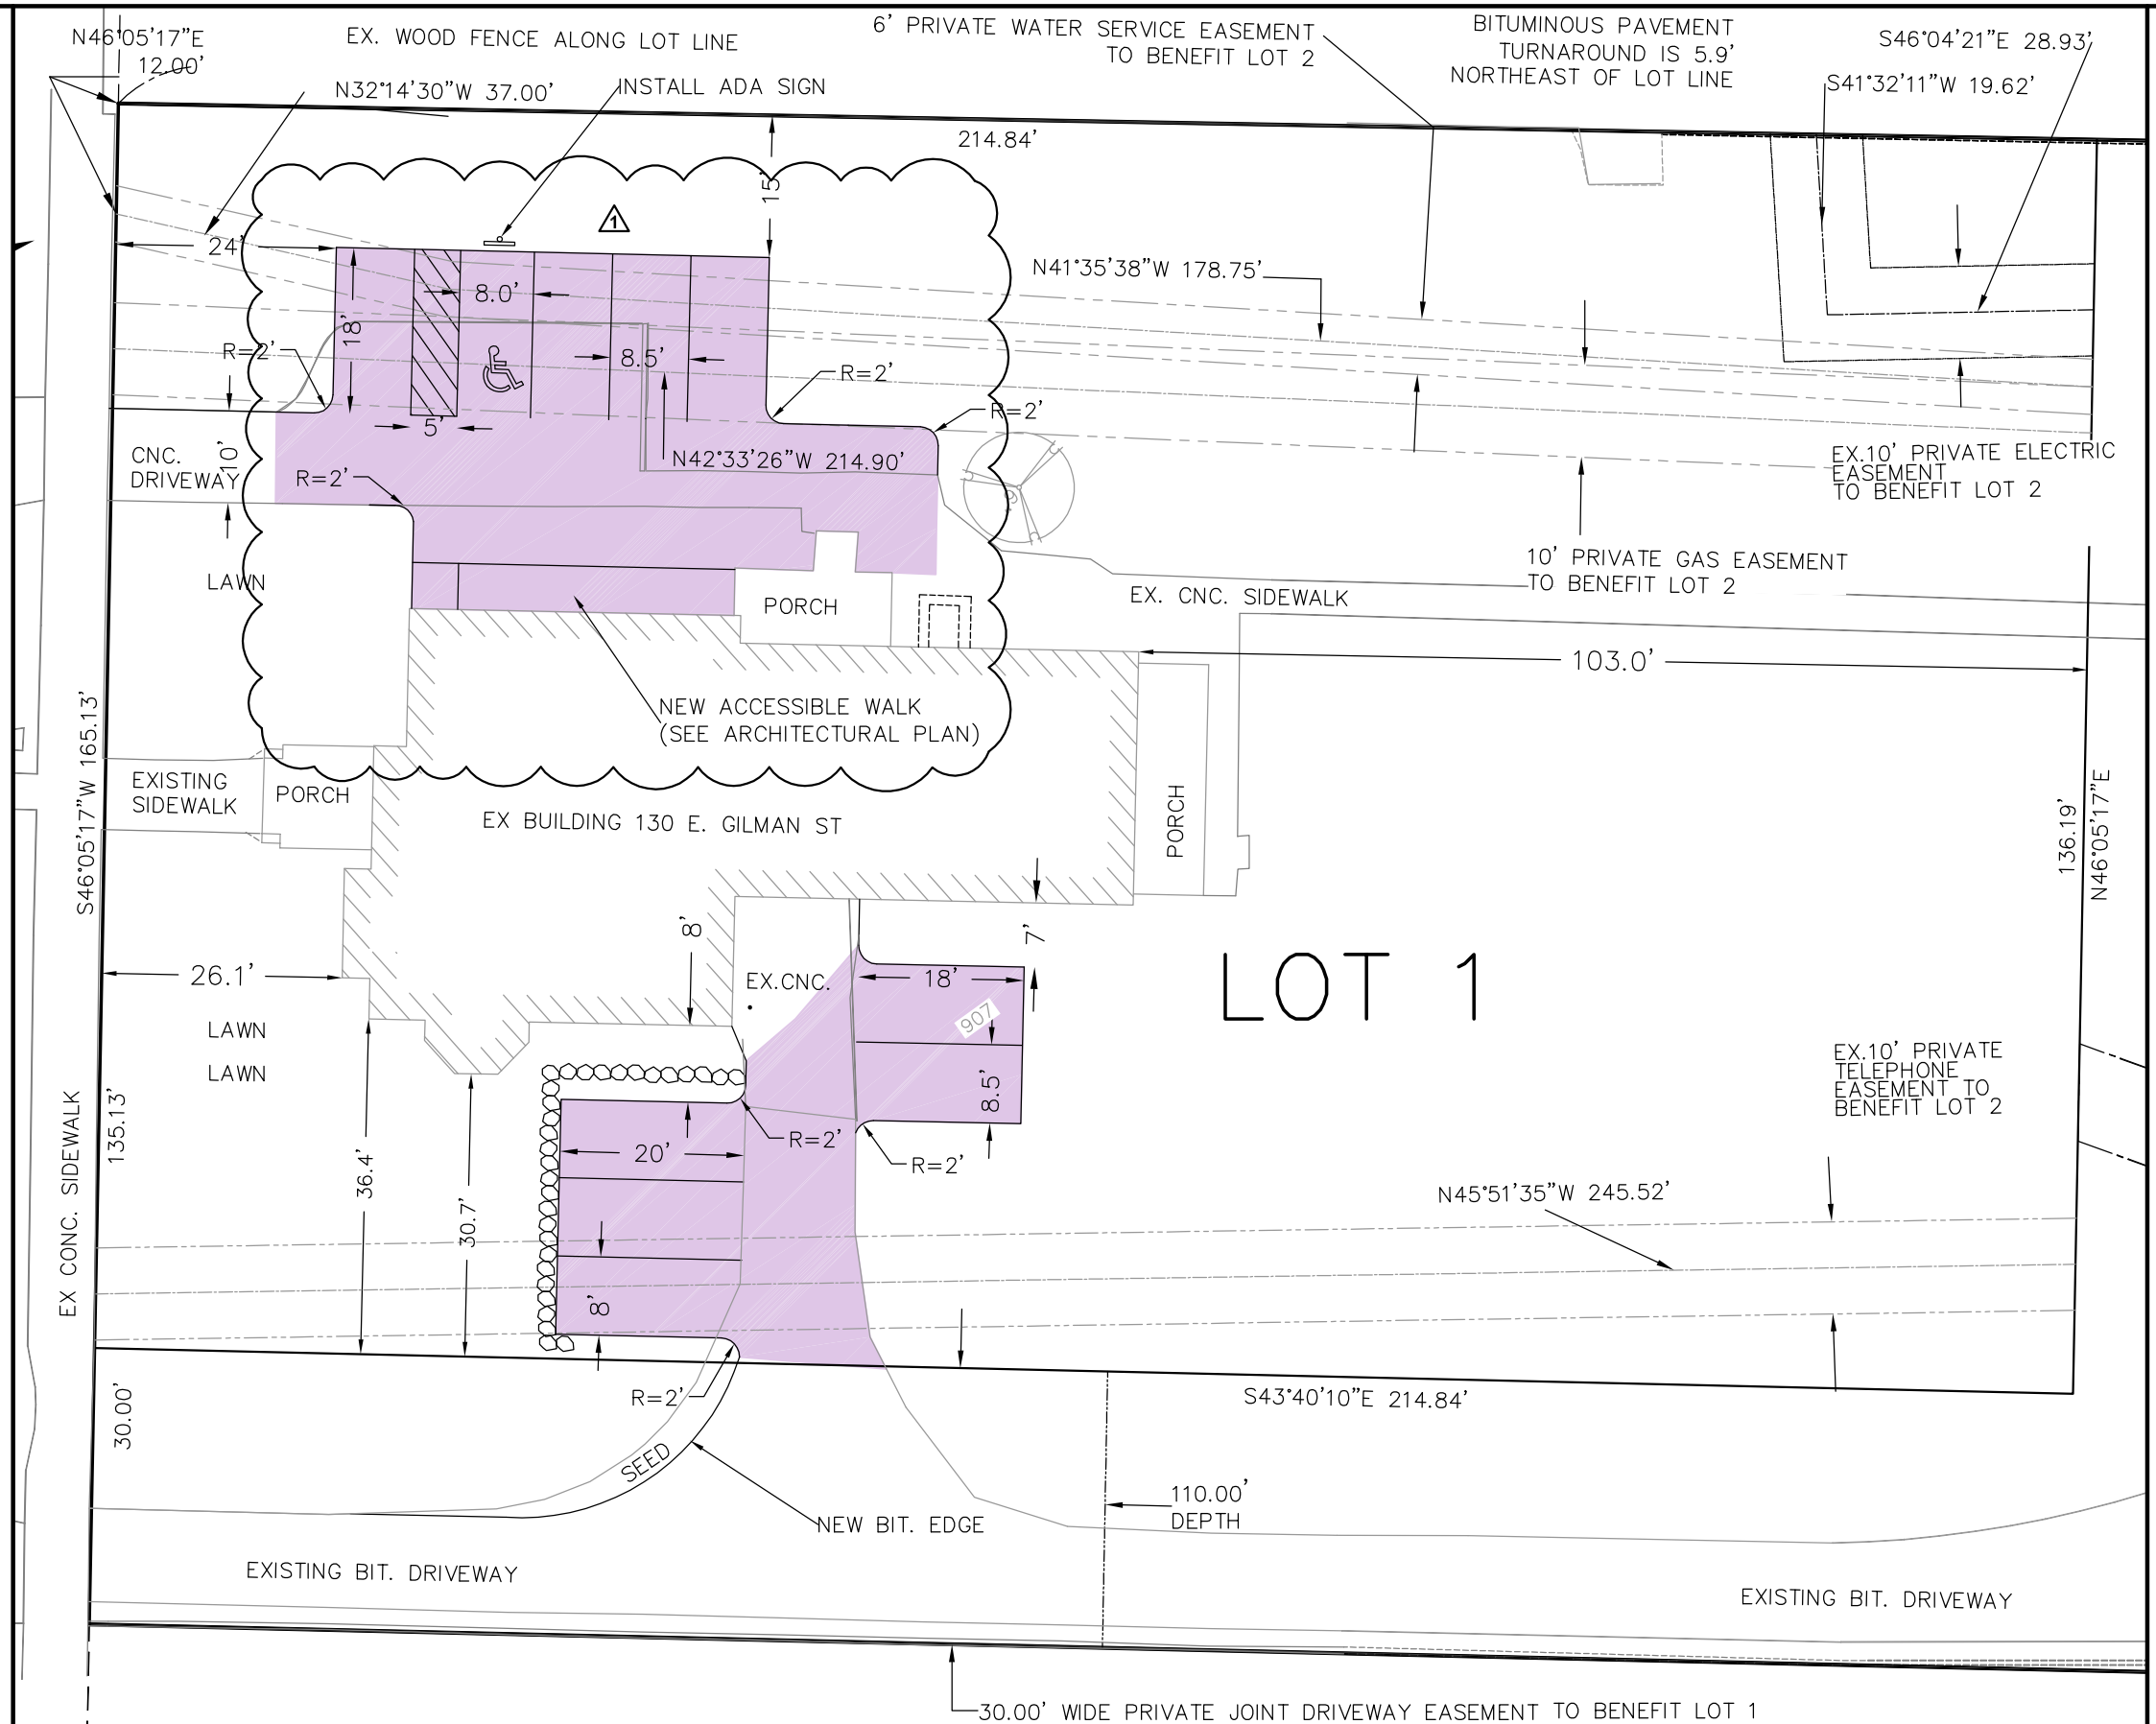

0 10 20

GRID NORTH

GENERAL NOTES:

1. PAVEMENT MARKINGS AND SIGNAGE PERTAINING TO ACCESSIBLE PARKING STALLS AND ROUTES SHALL CONFORM TO CURRENT ADA REGULATIONS
2. PAVEMENT DESIGN SHALL BE PER THE RECOMMENDATION OF THE SOILS CONSULTANT
3. IT IS THE CONTRACTOR'S RESPONSIBILITY TO VERIFY THE LOCATION OF UNDERGROUND UTILITIES. UTILITIES WERE LOCATED BY OBSERVED EVIDENCE, MARKINGS PROVIDED BY DIGGER'S HOTLINE, AND RECORD DRAWINGS FROM THE CITY OF MADISON.
4. ANY SIDEWALK, CURB, OR OTHER PUBLIC PROPERTY DAMAGED AS PART OF THE CONSTRUCTION OF THE UTILITIES AND BUILDING SHALL BE REPLACED IN-KIND PER THE CITY OF MADISON'S STANDARD SPECIFICATION.
5. ALL WORK IN PUBLIC RIGHT-OF-WAY SHALL BE PERFORMED BY A CITY APPROVED CONTRACTOR .

WISCONSIN VAN ACCESSIBLE PARKING SIGN

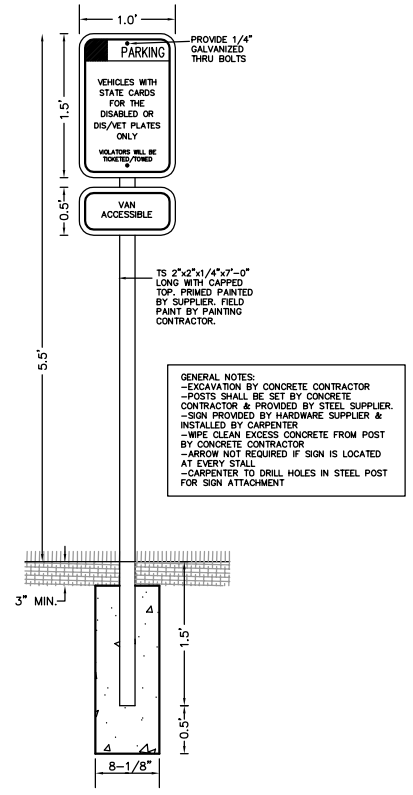

DIGGERS HOTLINE
Dial 811 or (800) 242-8511
www.DiggersHotline.com

Burse
Surveying and Engineering, Inc.
2801 International Lane, Suite 101
Madison, WI 53704
Phone: 608-250-9263
Fax: 608-250-9266
e-mail: MBurse@BSE-INC.net
www.bursesurveyengr.com

APPROVALS		
PROJECT ENG.	M.L.B.	
DESIGNED BY:	PDF	
DRAWN BY:	CMK	
CHECKED BY:	M.L.B.	
APPROVED	M.L.B.	

GOVERNOR'S MANSION

130 E.GILMAN STREET
MADISON, WI. 53703

BOB KLEBBA
704 E Gorham Street
Madison, WI. 5307-1522

PROJECT #: BSE 1625	
PLOT DATE:	08/10/2017
REVISION DATES:	
1	08/10/2017
ISSUE DATES:	
	06/28/2017
	08/10/2017

CIVIL SITE PLAN

Burse
Surveying and Engineering, Inc.

This document contains confidential or proprietary information of Burse Surveying and Engineering, Inc. Neither the document nor the information herein is to be reproduced, distributed, used or disclosed, either in whole or in part, except as specifically authorized by Burse Surveying and Engineering, Inc.

DRAWING NUMBER

C-200

Printed: Aug 10, 2017 - 10:04am Printed By: Survey

M:_BSE1625\Engineering\BSE1625eng.DWG